
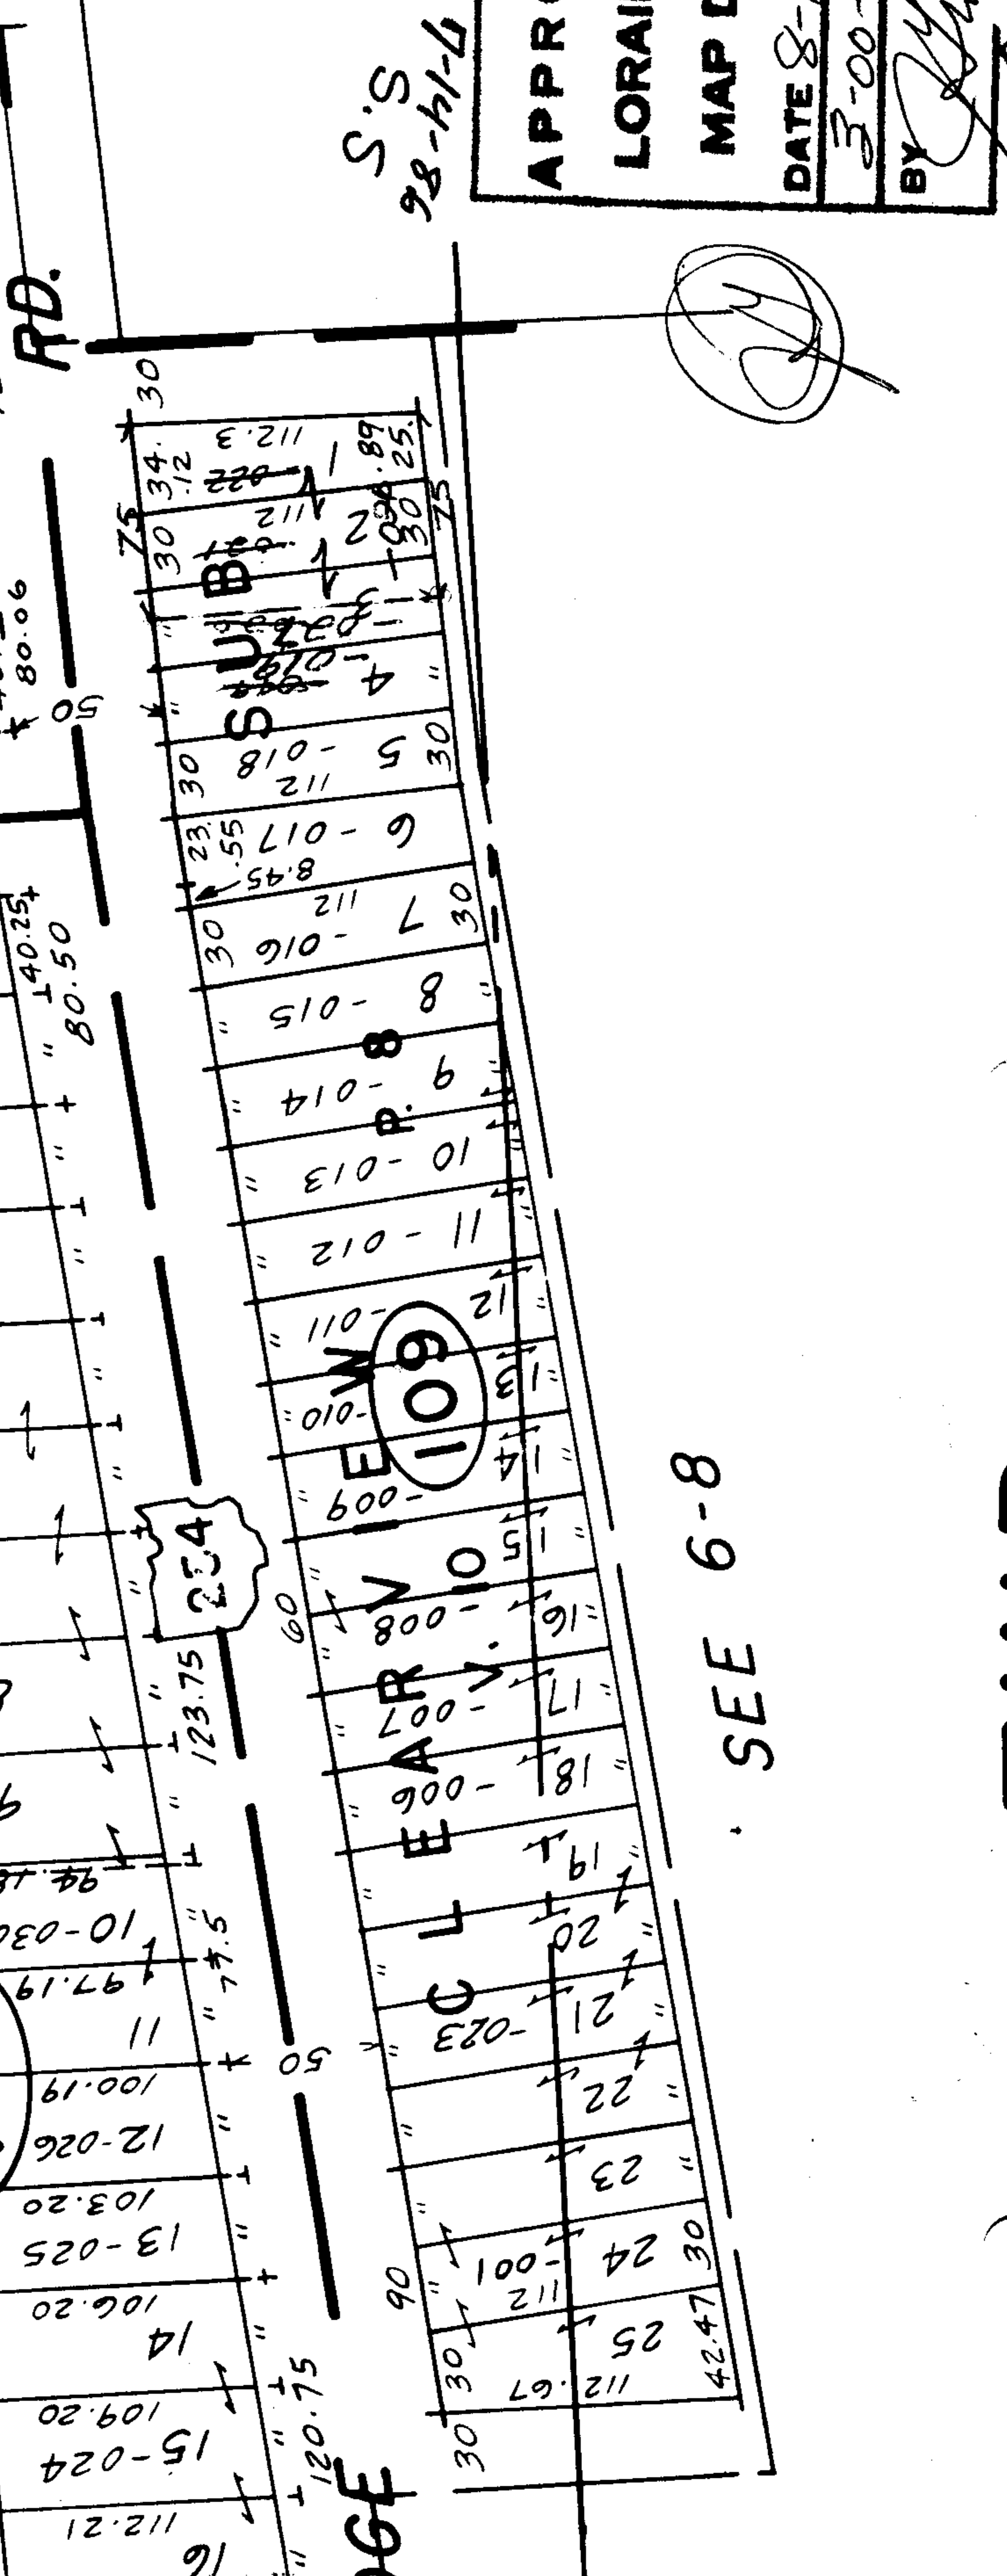


2032

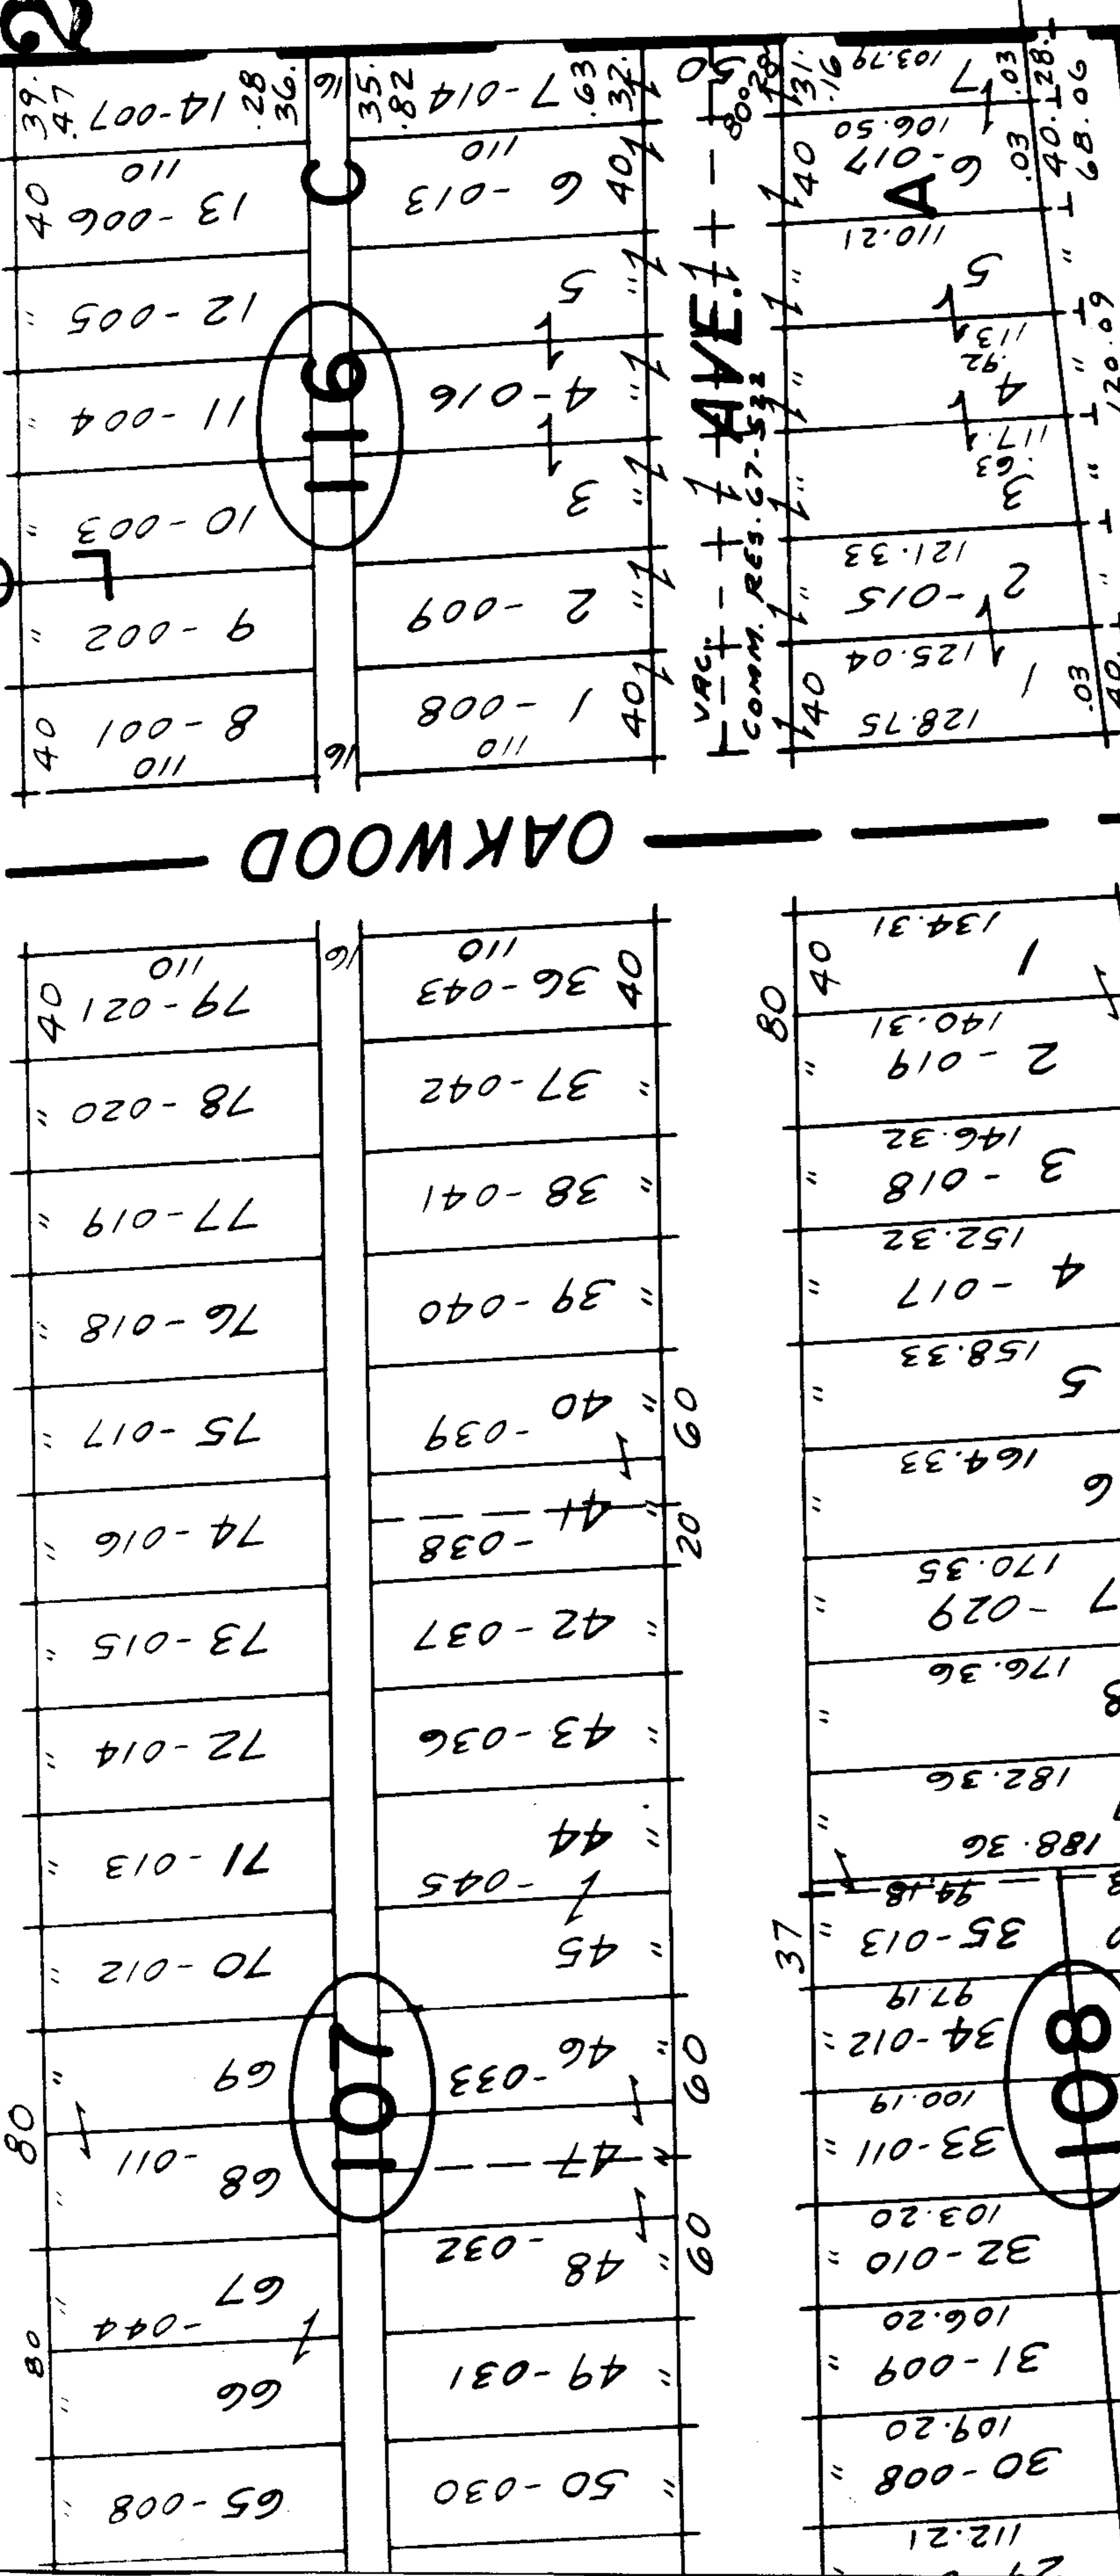

APPROVED
 LORAIN CO.
 MAP DEPT.
 DATE 8-16-68
 3-00-109A
 BY *[Signature]*
 9/1/68 R.K.

[Handwritten mark]

SEE 6-8

EFFIELD TWP.