



2034

3.4077.

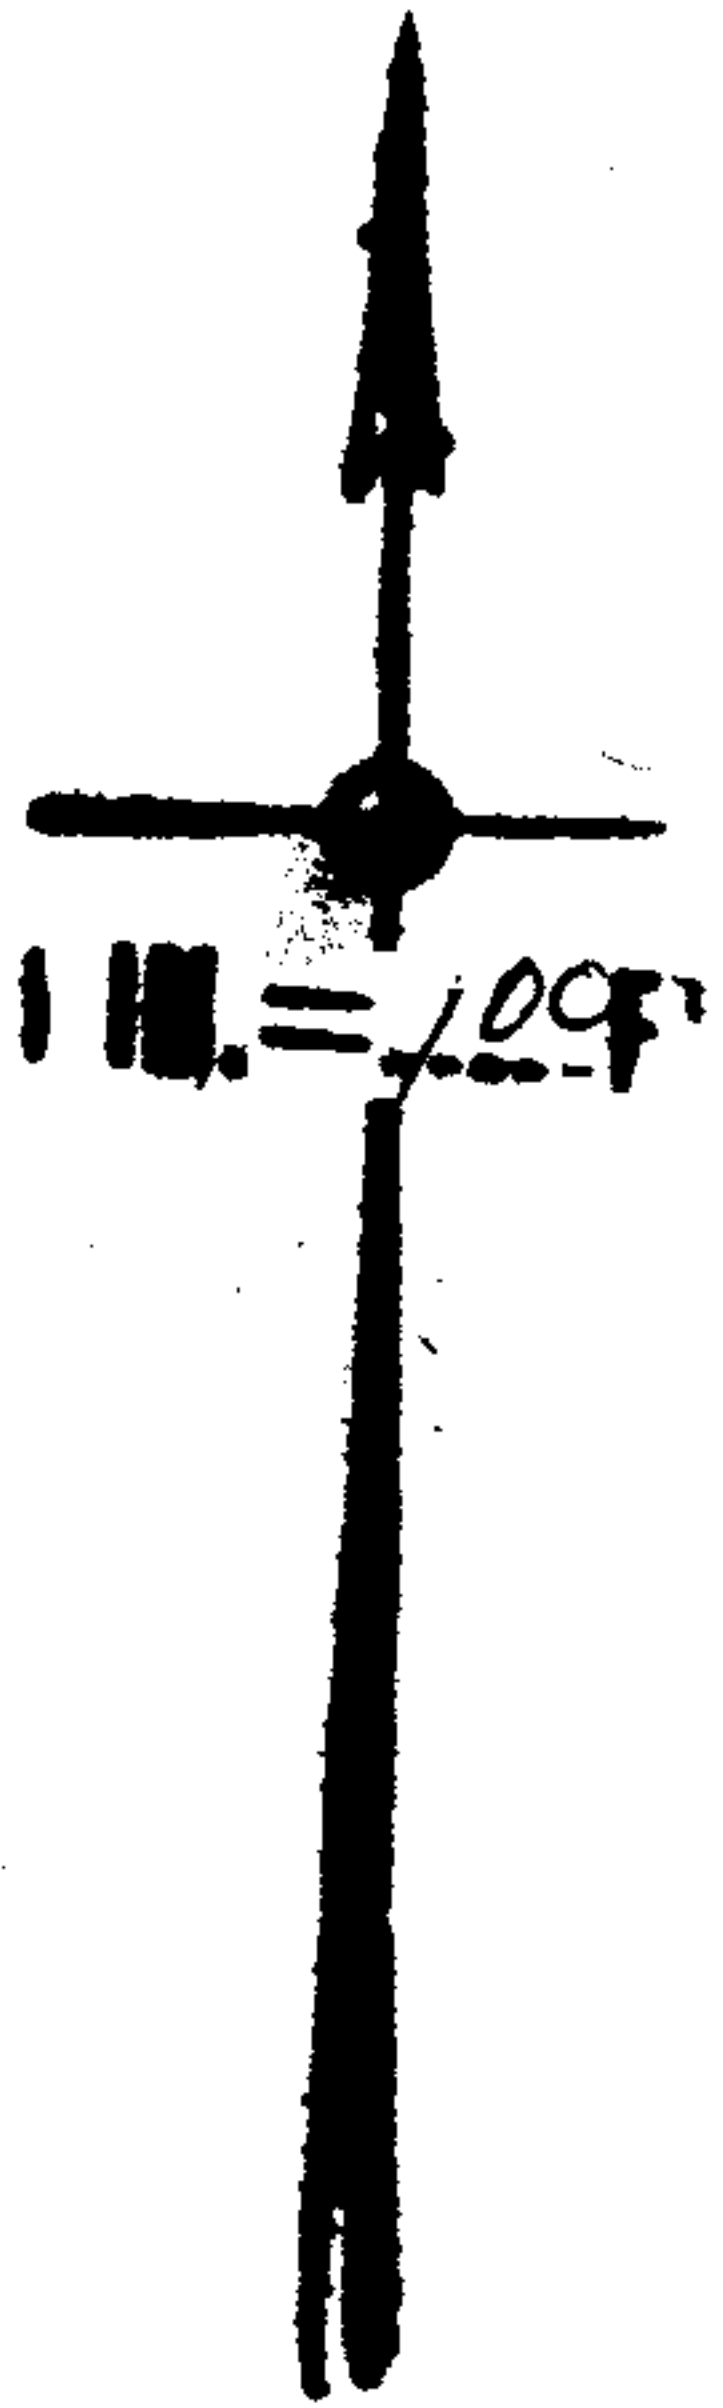

APPROVED
 LORAIN CO.
 MAP DEPT.
 DATE 8-19-68
 10-00-007 E
 BY *Grace*

9/28/68 *R.K.*

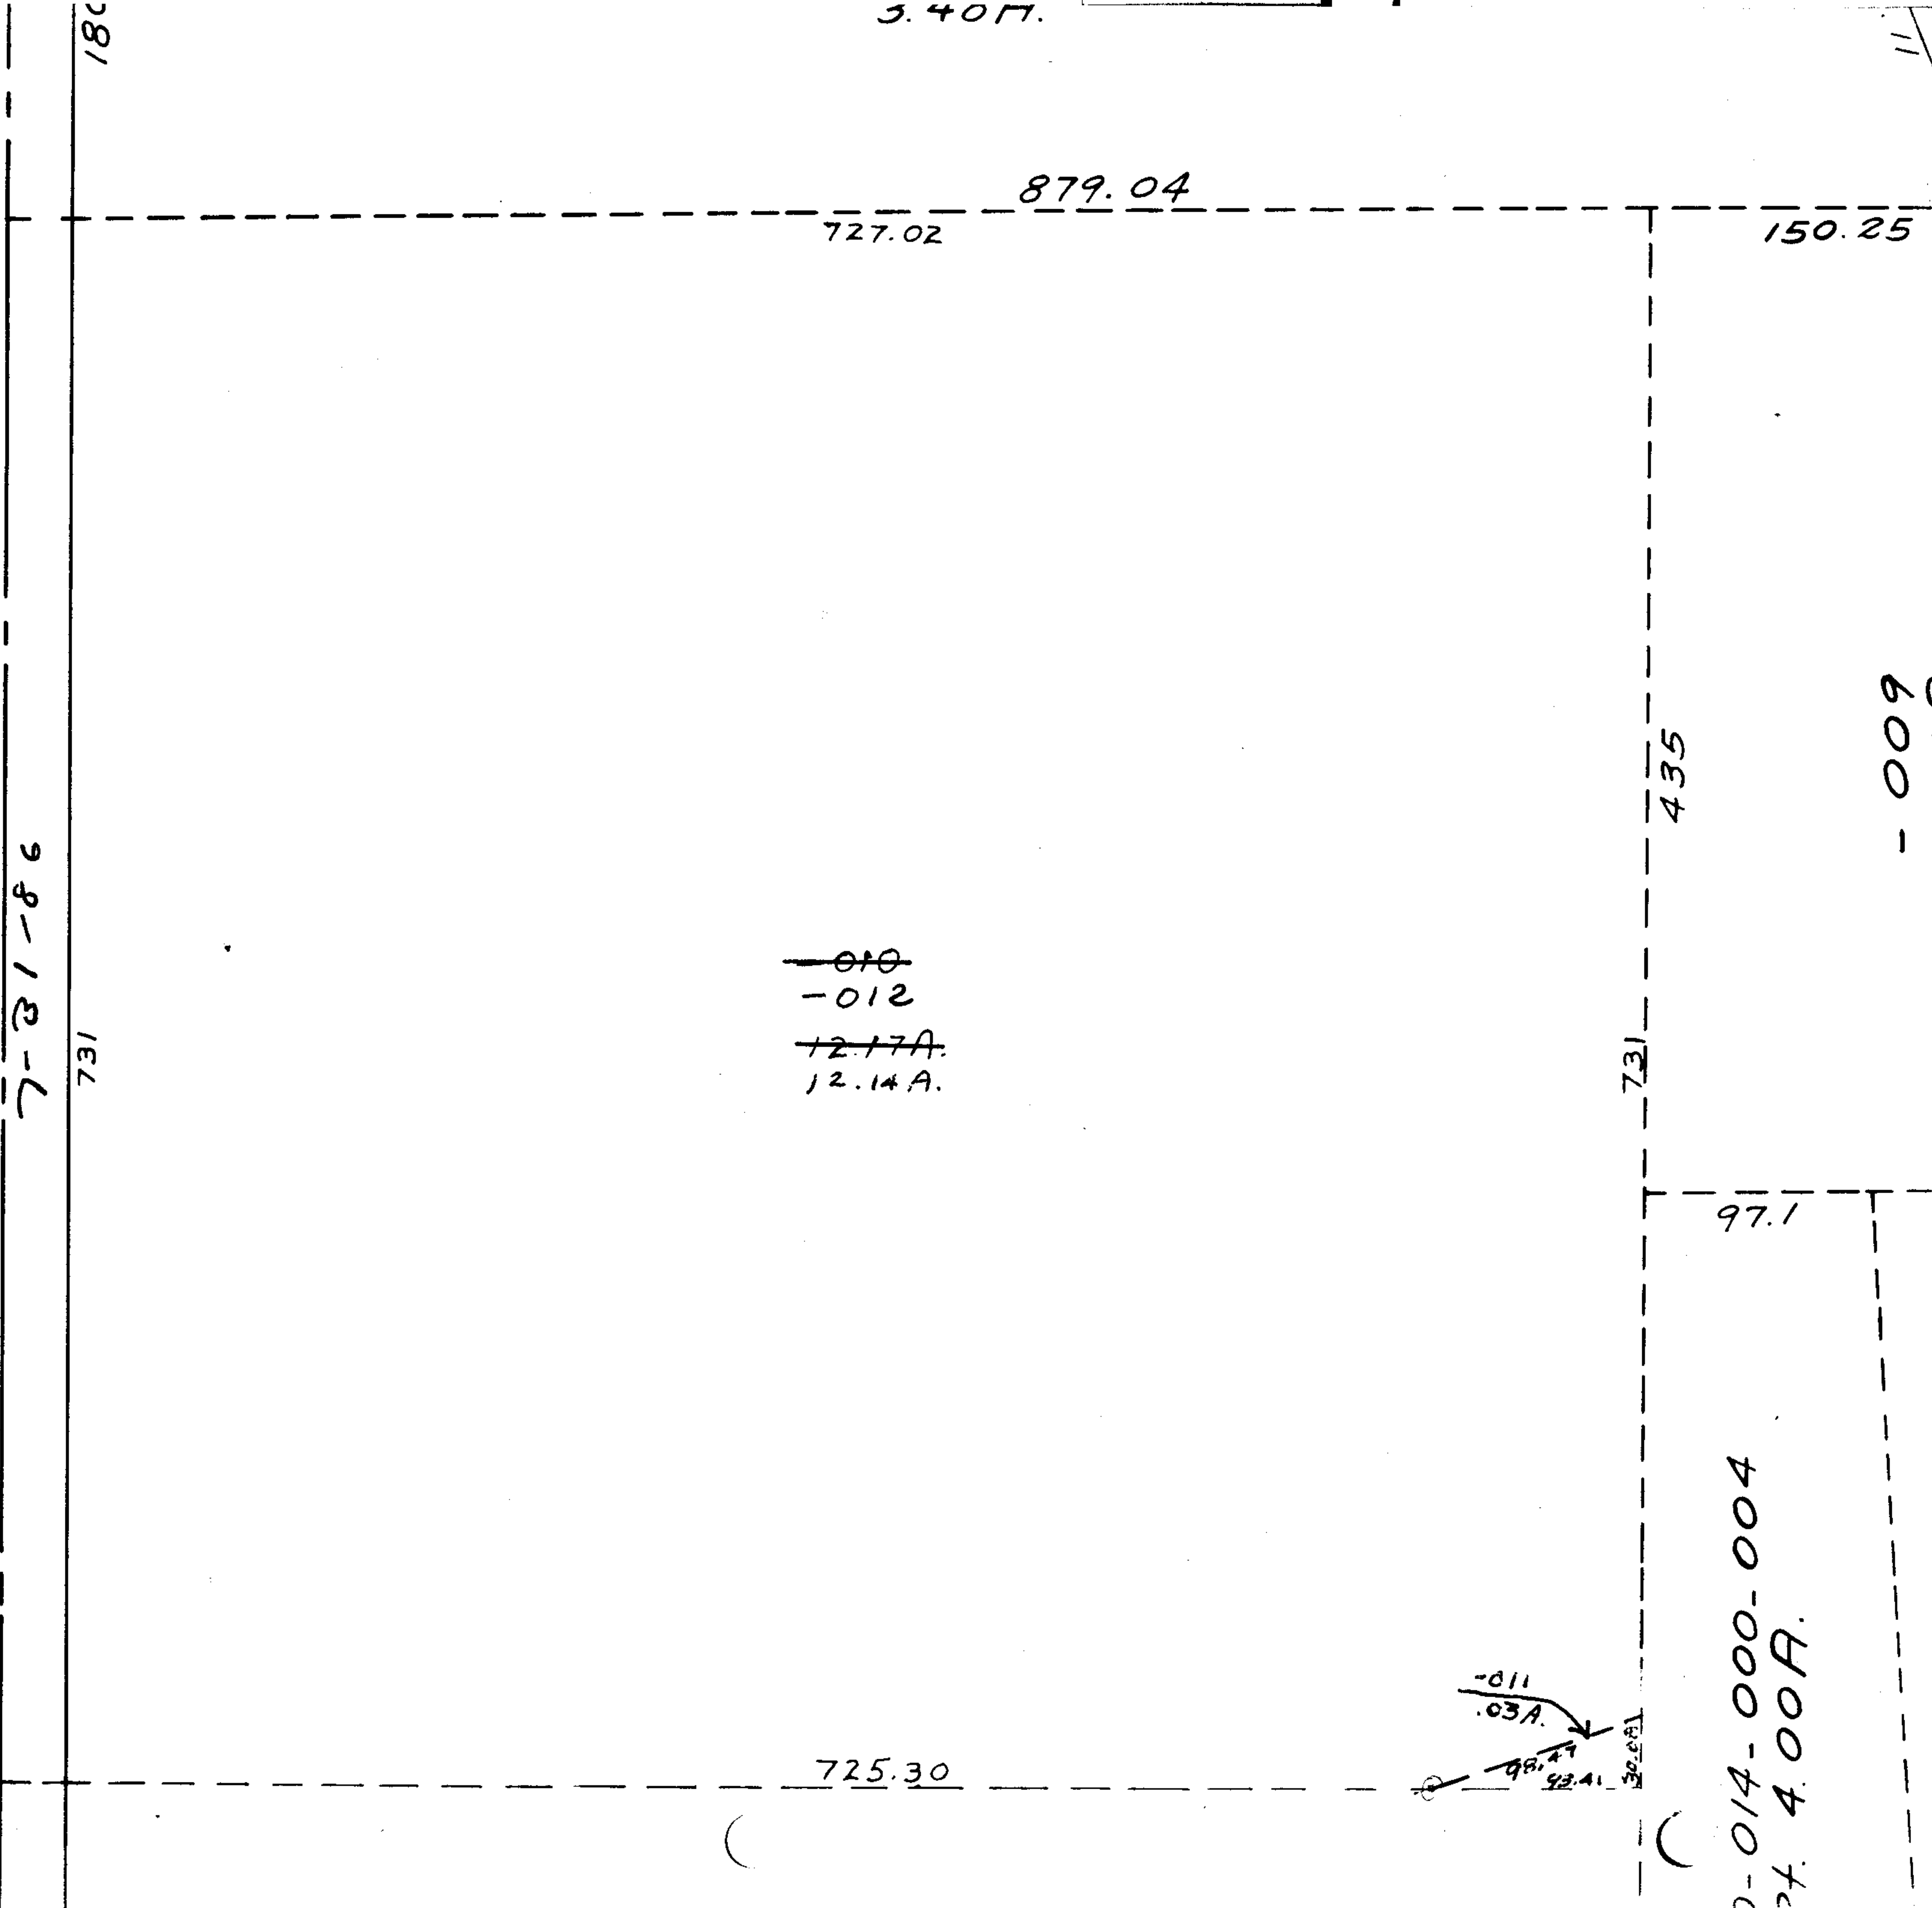

10-014-000-004
 24.400A.