


8.00
- .87
7.13

110.62 310.1 808.12 526

101

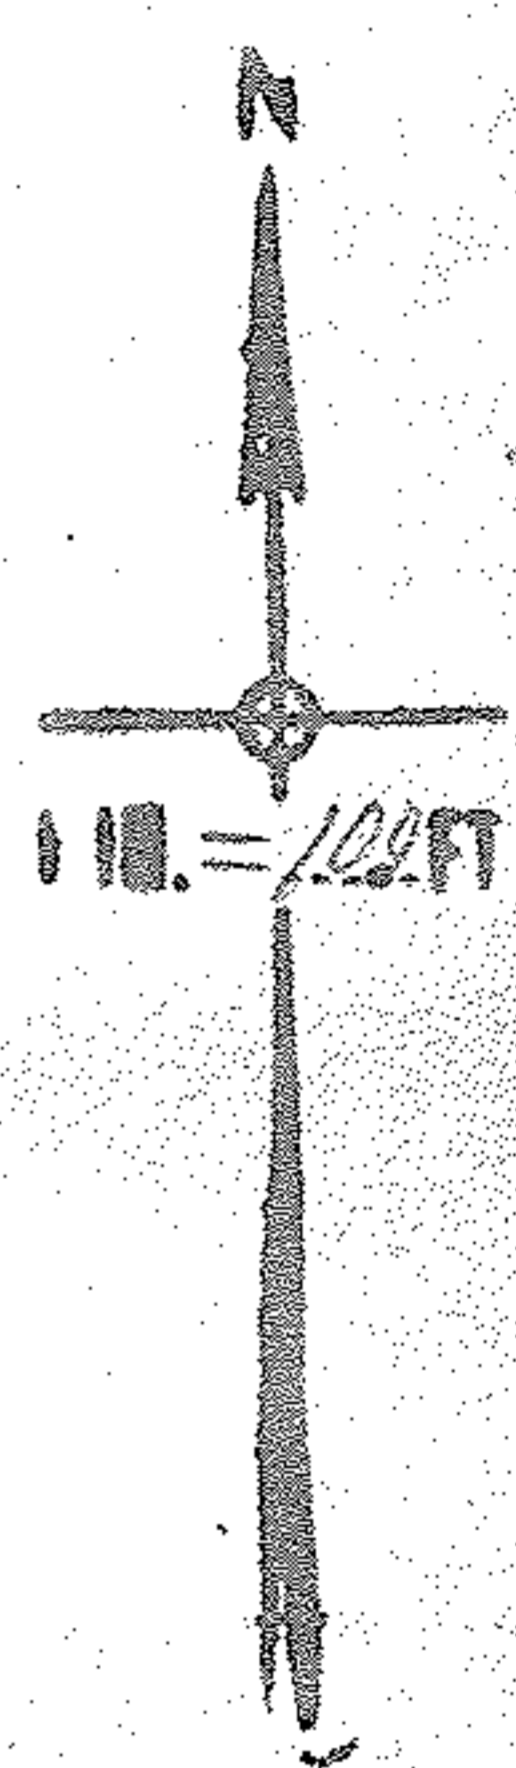

1187.03 1187.03

-022
3.00 R.

1175.68

-046
-023
8.45 A.
~~7.58 A.~~
7.13 A



1144.78

#2039
APPROVED
LORAIN CO.
MAP DEPT.
DATE 8-19-68
4-00-028F
BY *Grace*

7-11-86 88

Done 11-2-68
Jim Grace

