


STREET NAME CHANGE MAP CORRECTION ONLY SANDALWOOD

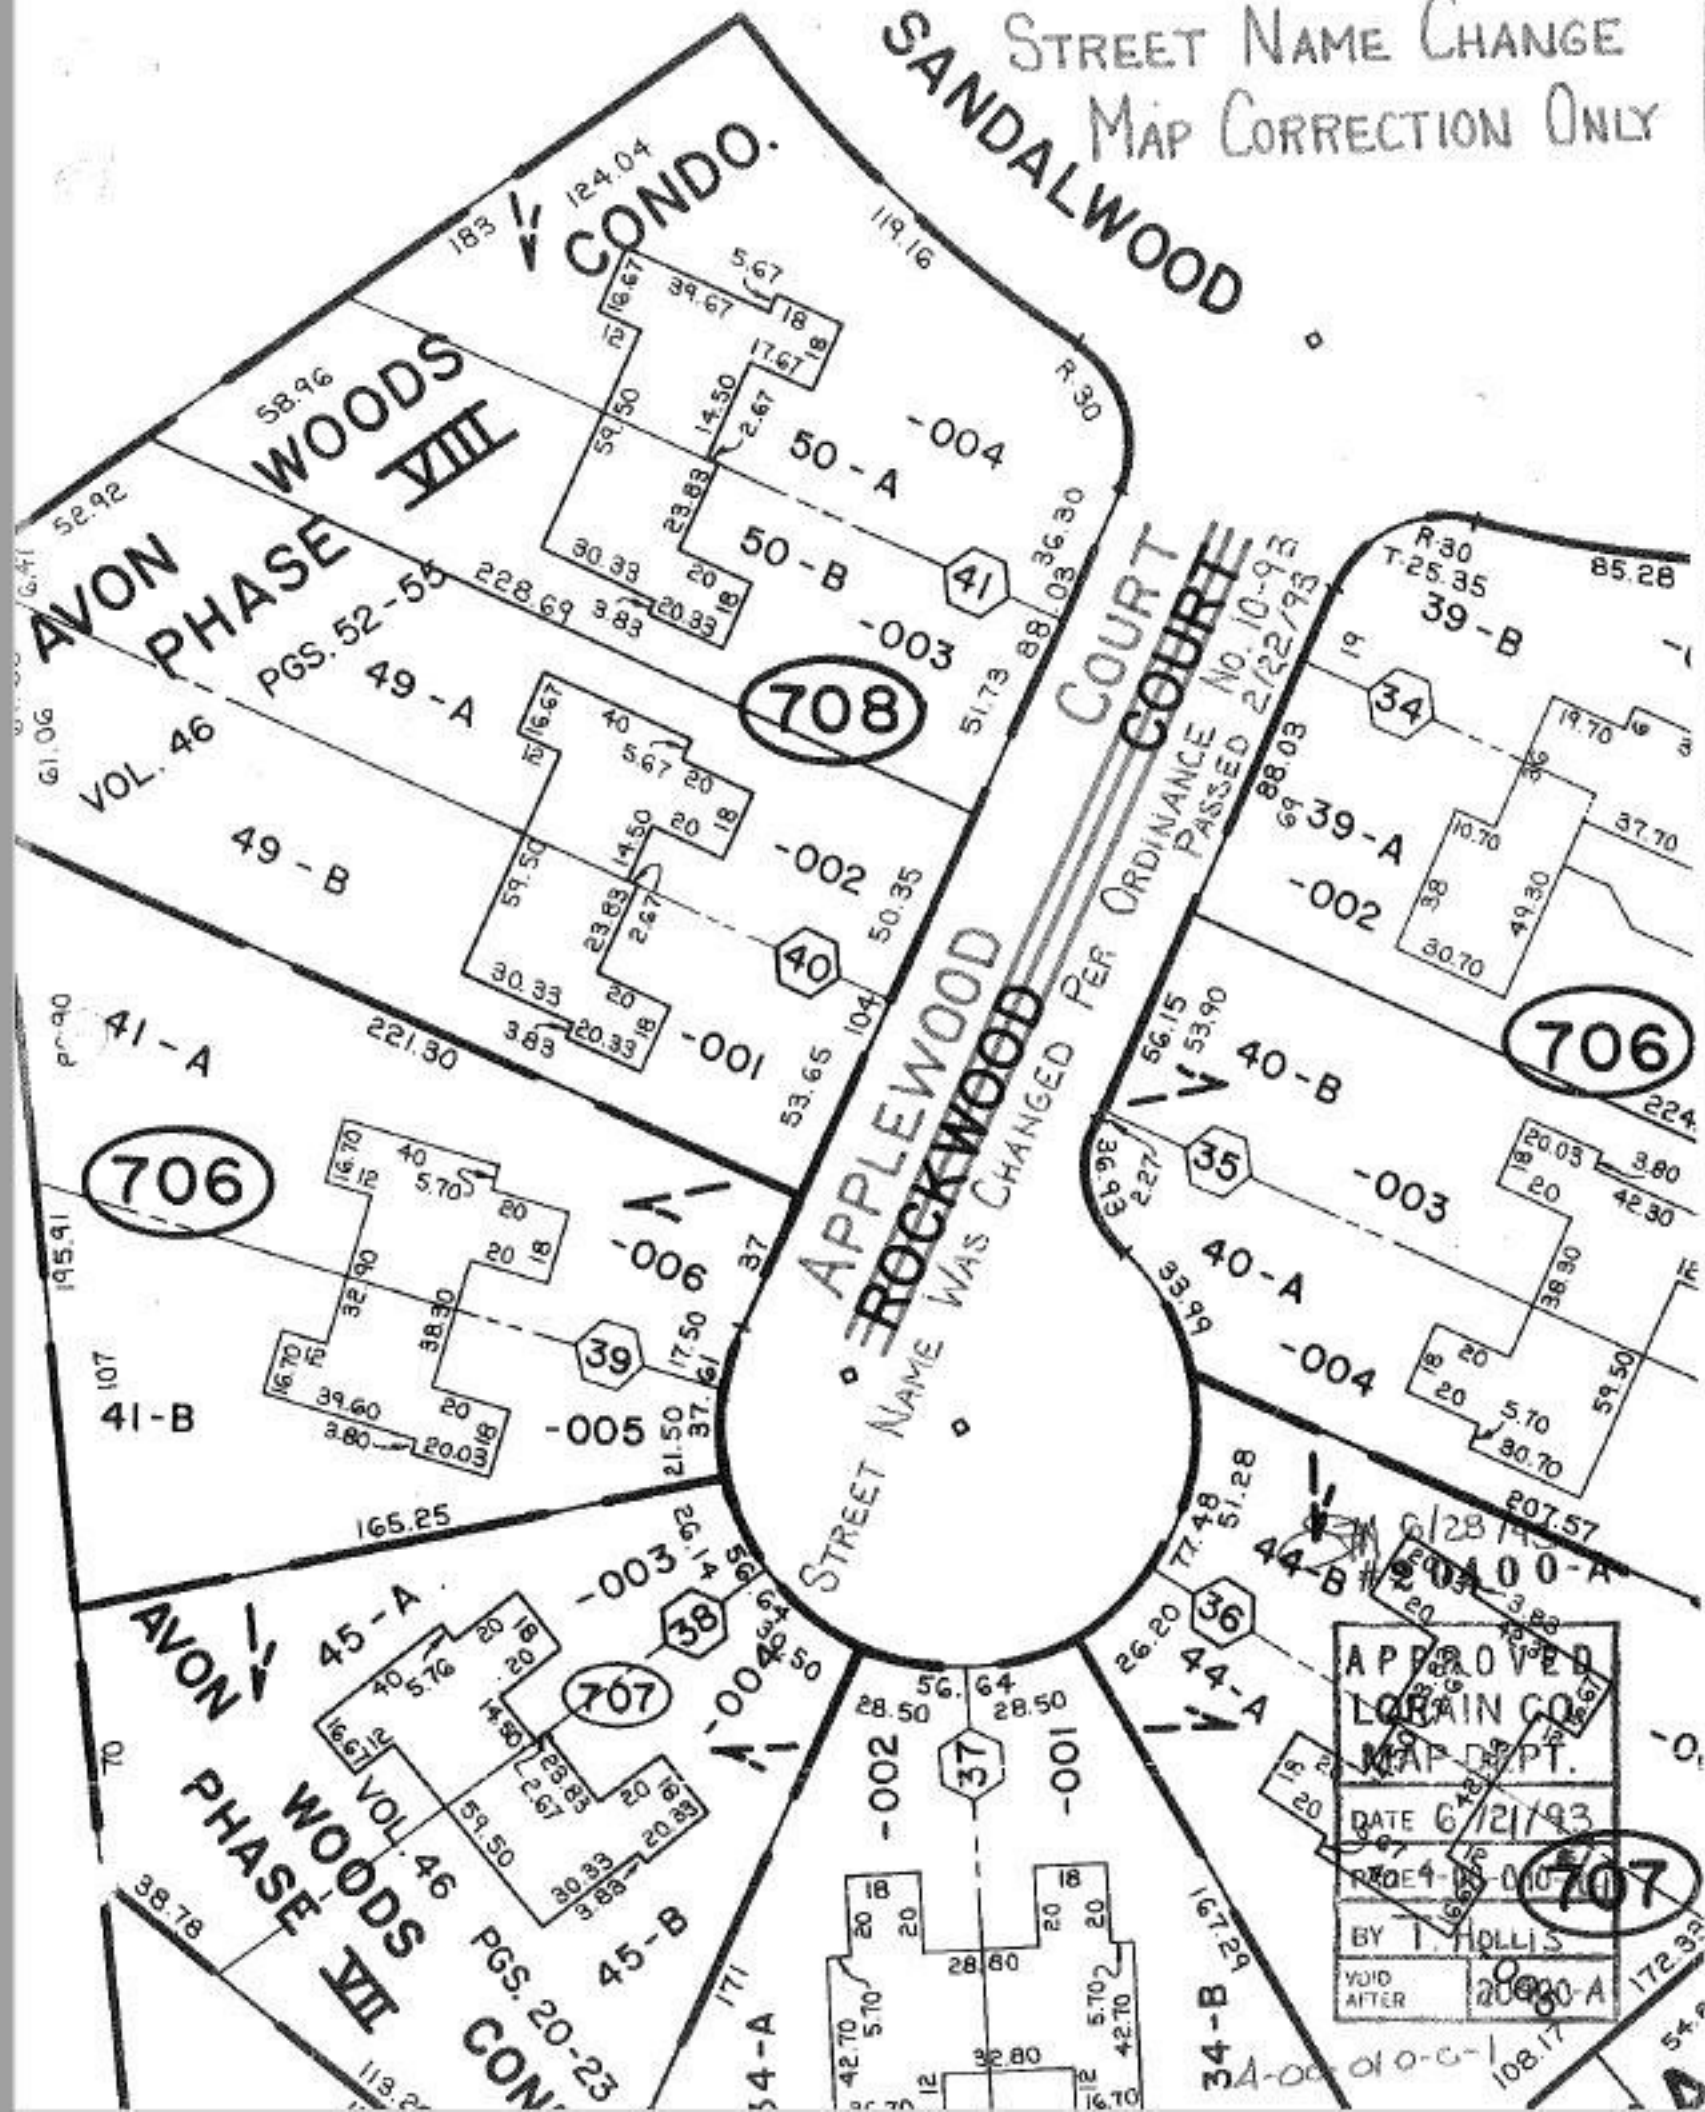

APPROVED
LORAIN CO.
MAP DEPT.
DATE 6/21/93
BY T. HOLLIS
VOID AFTER

707

708

706

706

707

20400-A