


SEE 3-F

101

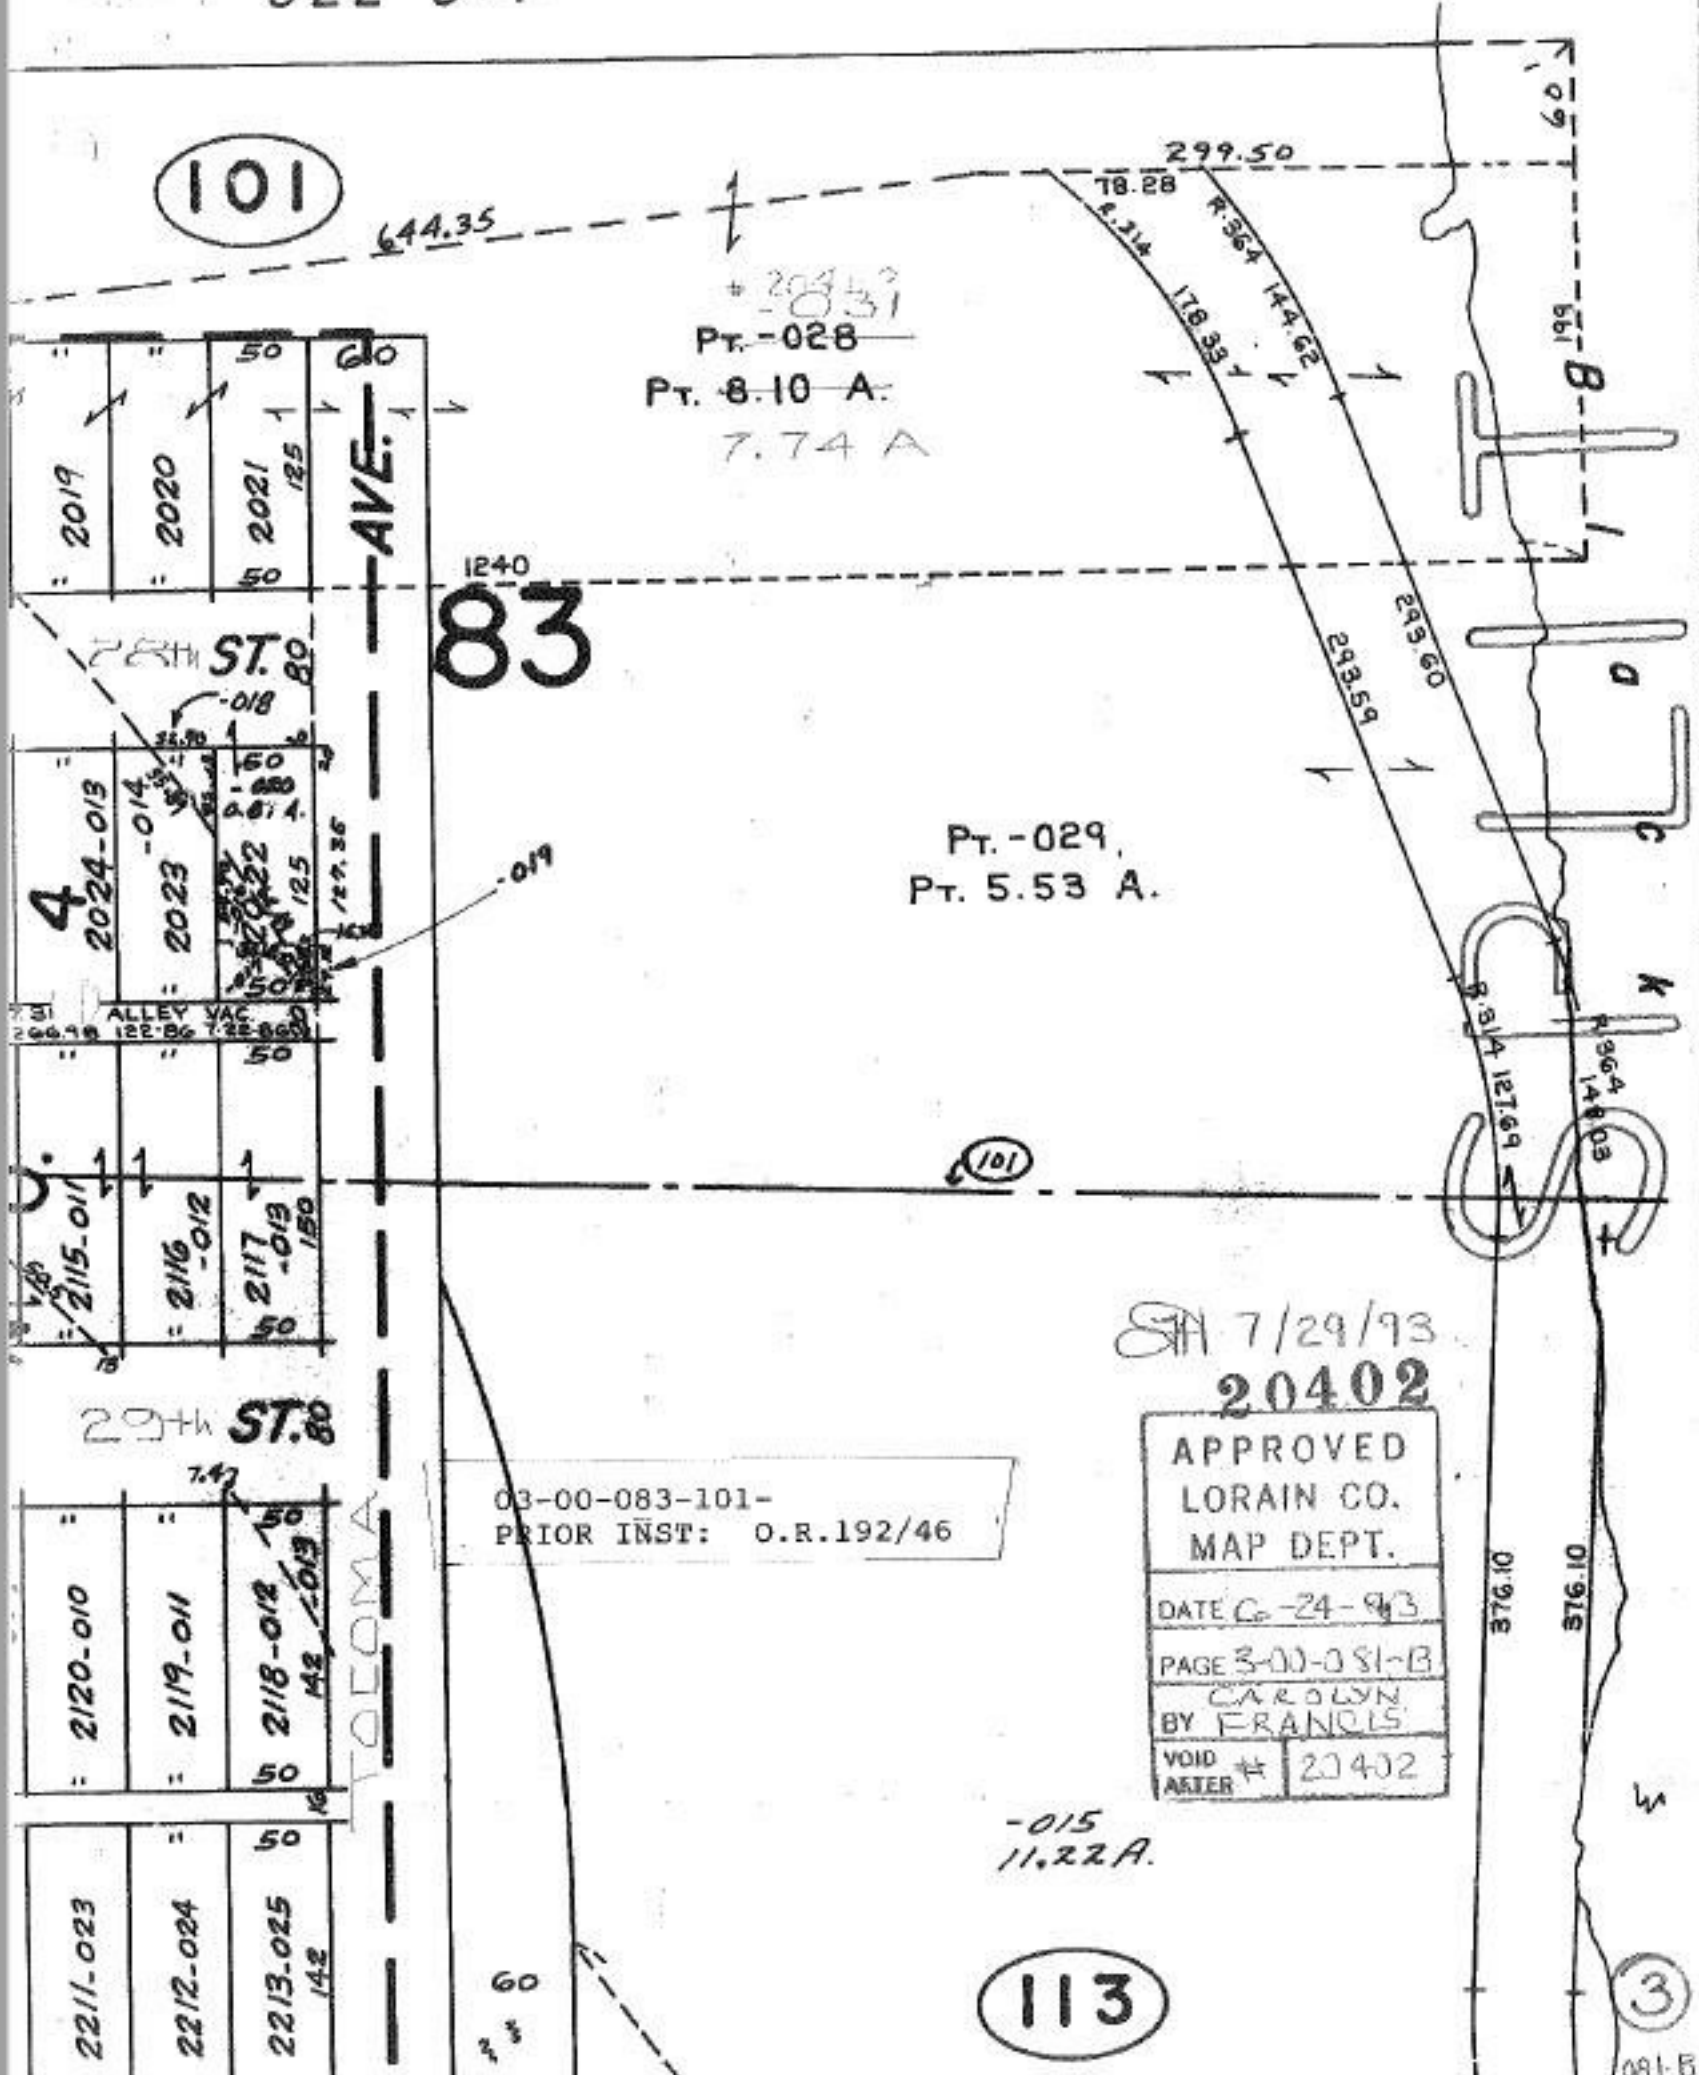

+ 204 1/2
 - 031
 Pt. -028
 Pt. 8.10 A:
 7.74 A

Pt. -029,
 Pt. 5.53 A.

83

101

SHA 7/29/93

20402

03-00-083-101-
 PRIOR INST: O.R.192/46

APPROVED
 LORAIN CO.
 MAP DEPT.
 DATE 6-24-93
 PAGE 3-00-081-B
 CAROLYN
 BY FRANCIS
 VOID AFTER # 20402

-015
 11.22 A.

113

3

081-B