


L O K

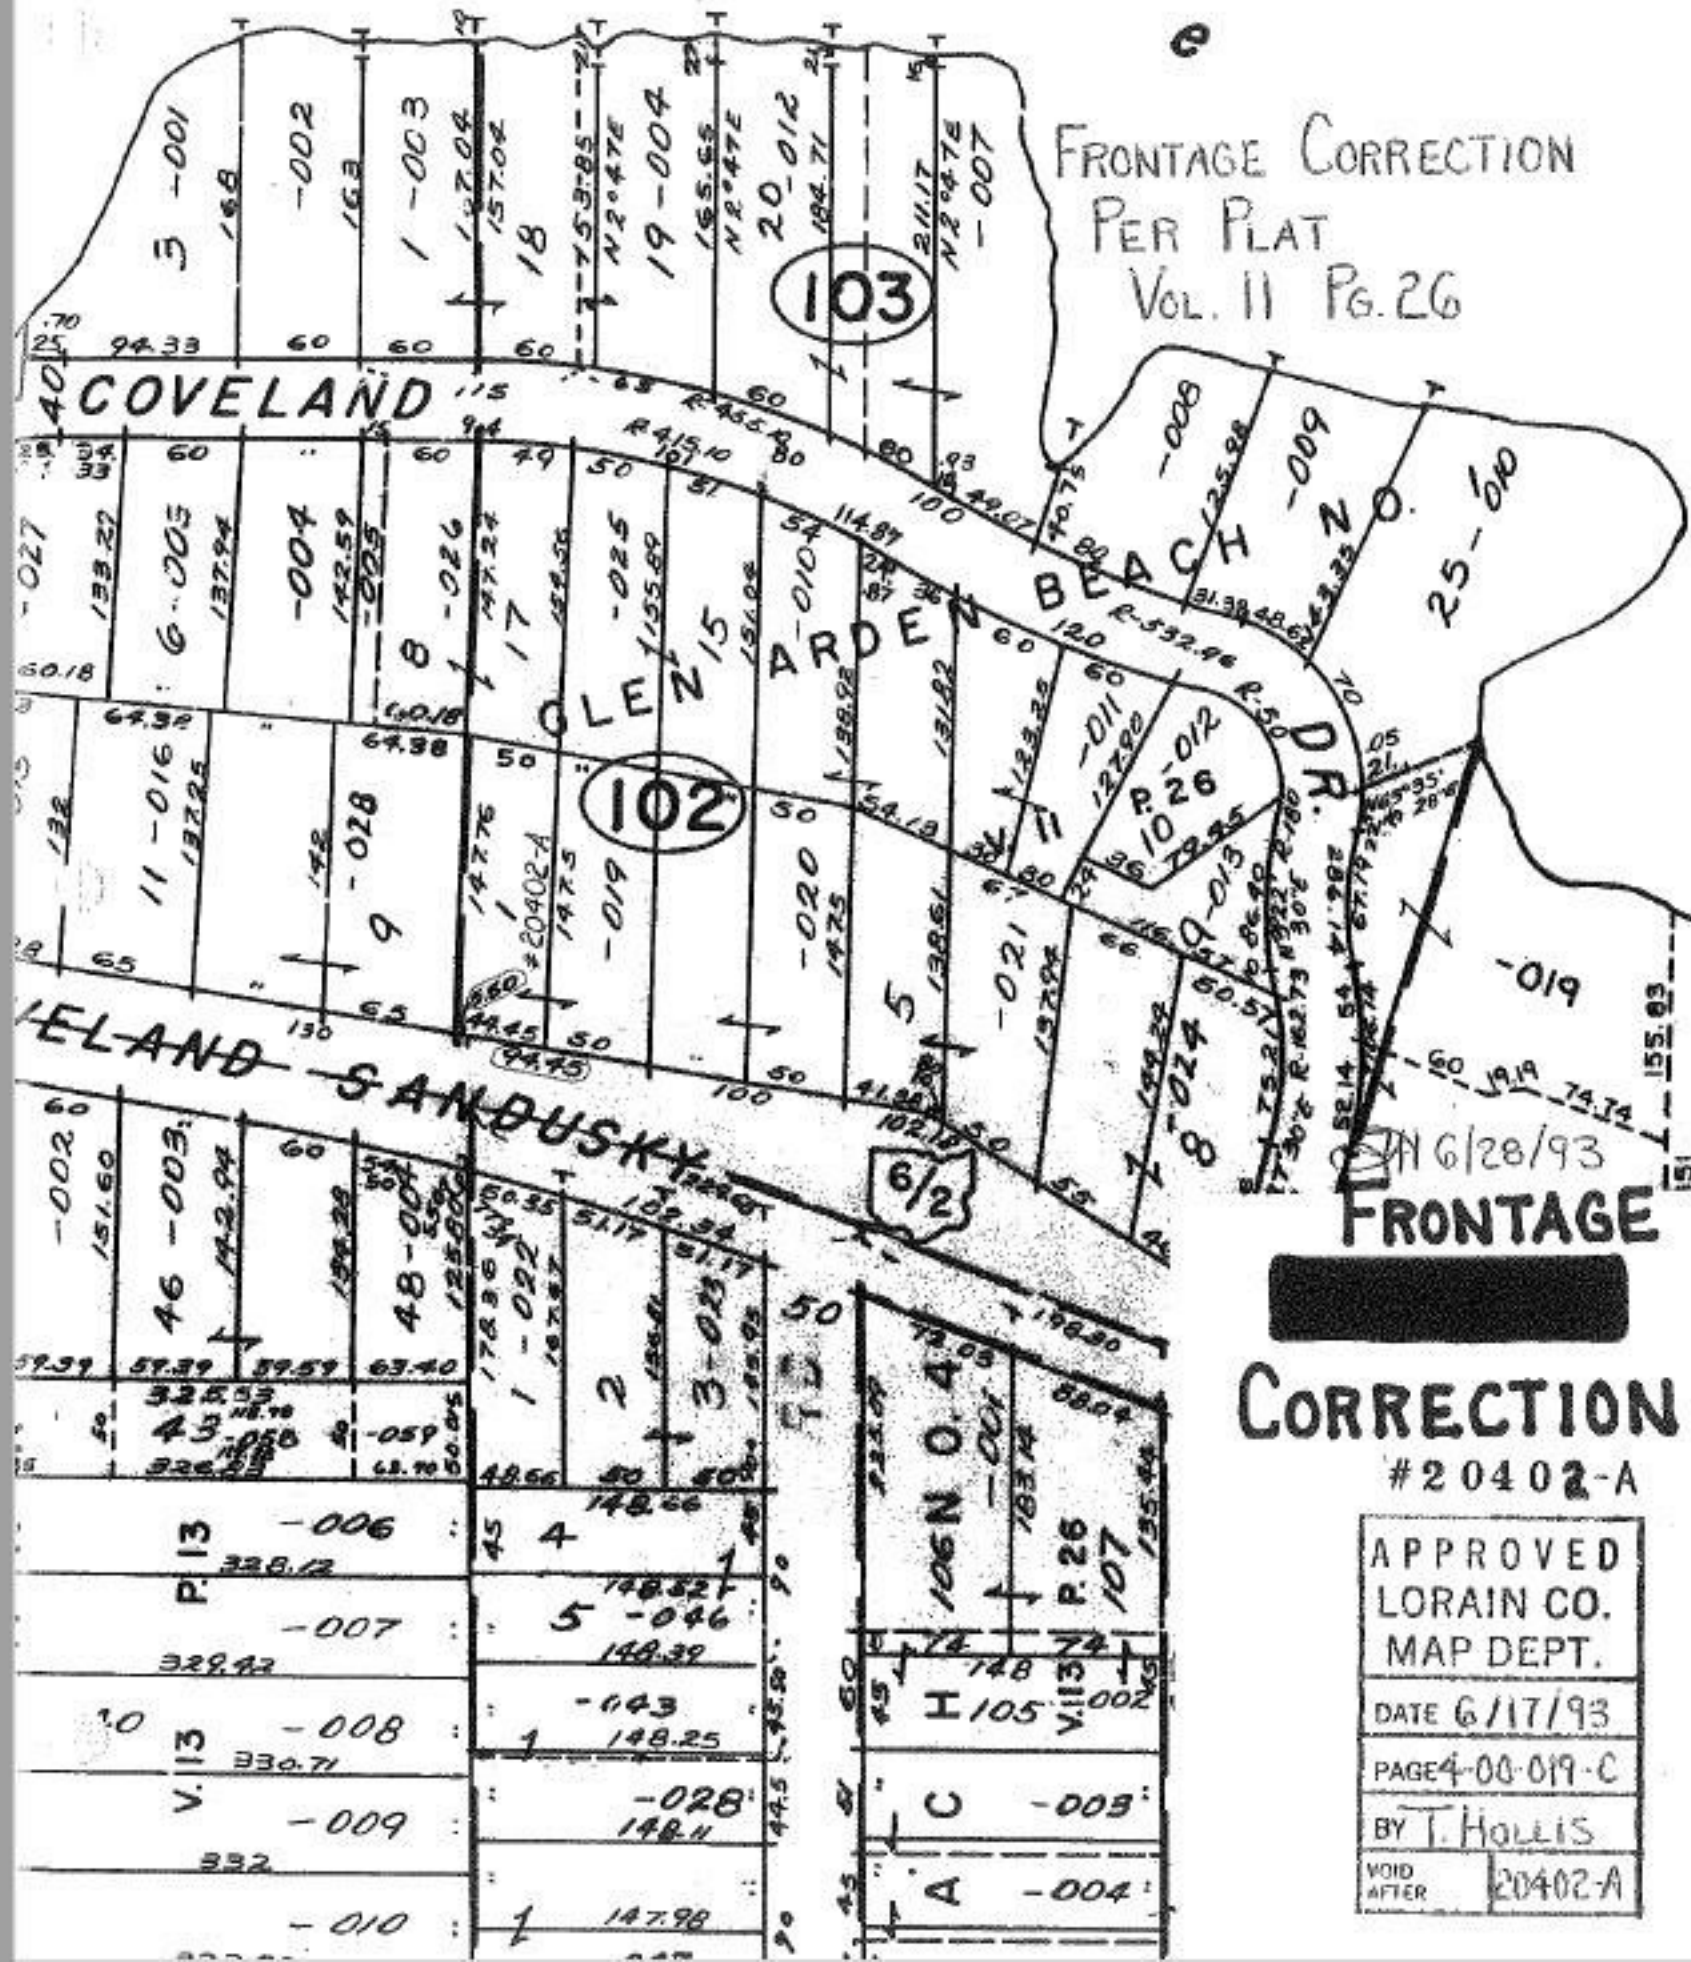

FRONTAGE CORRECTION
PER PLAT
VOL. 11 PG. 26

6/28/93
FRONTAGE

CORRECTION

#20402-A

APPROVED
LORAIN CO.
MAP DEPT.
DATE 6/17/93
PAGE 4-00-019-C
BY T. HOLLIS
VOID AFTER 20402-A