




SEE J-F

101

8.10 A
2.36 A
7.74 A

-031
Pt. -028
Pt. 8.10 A.
7.74 A

1764.44
2400.75

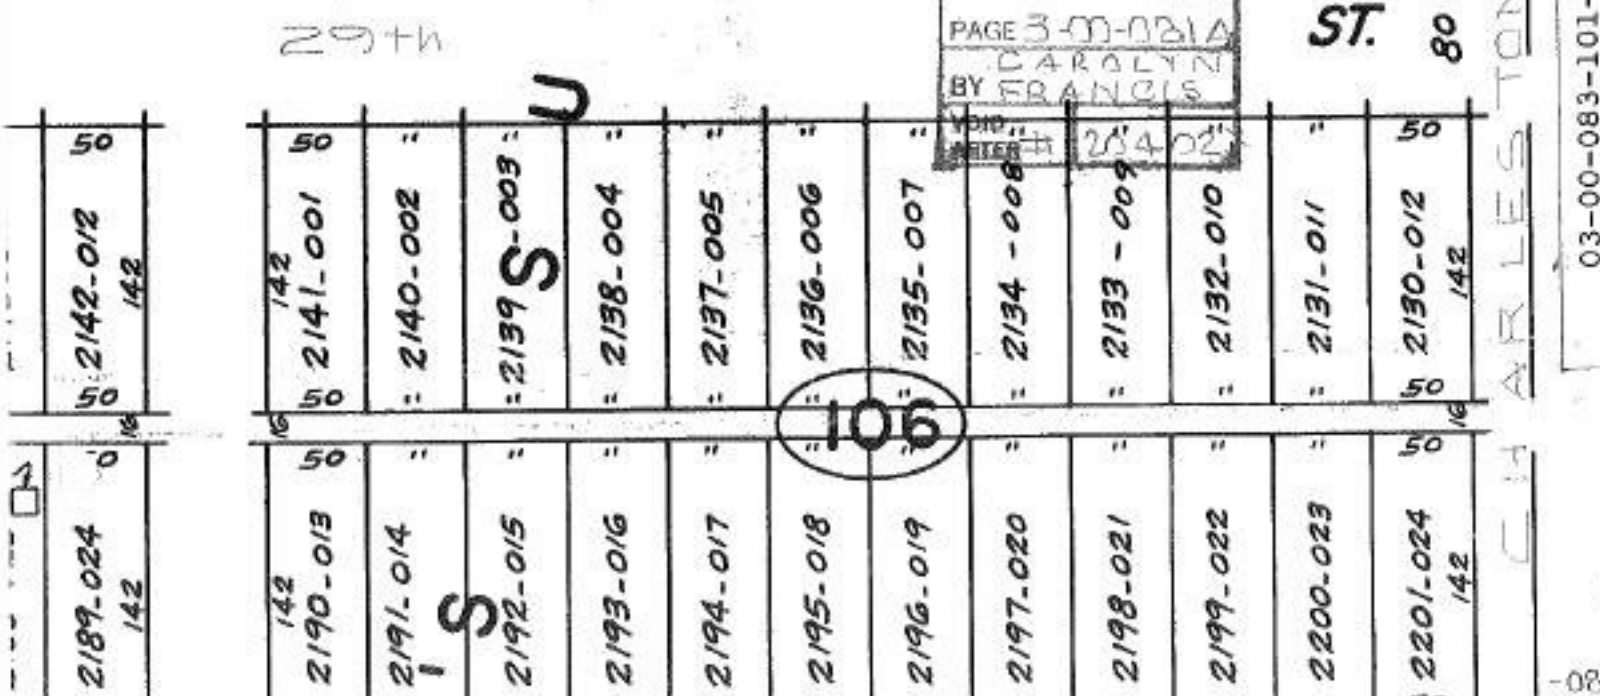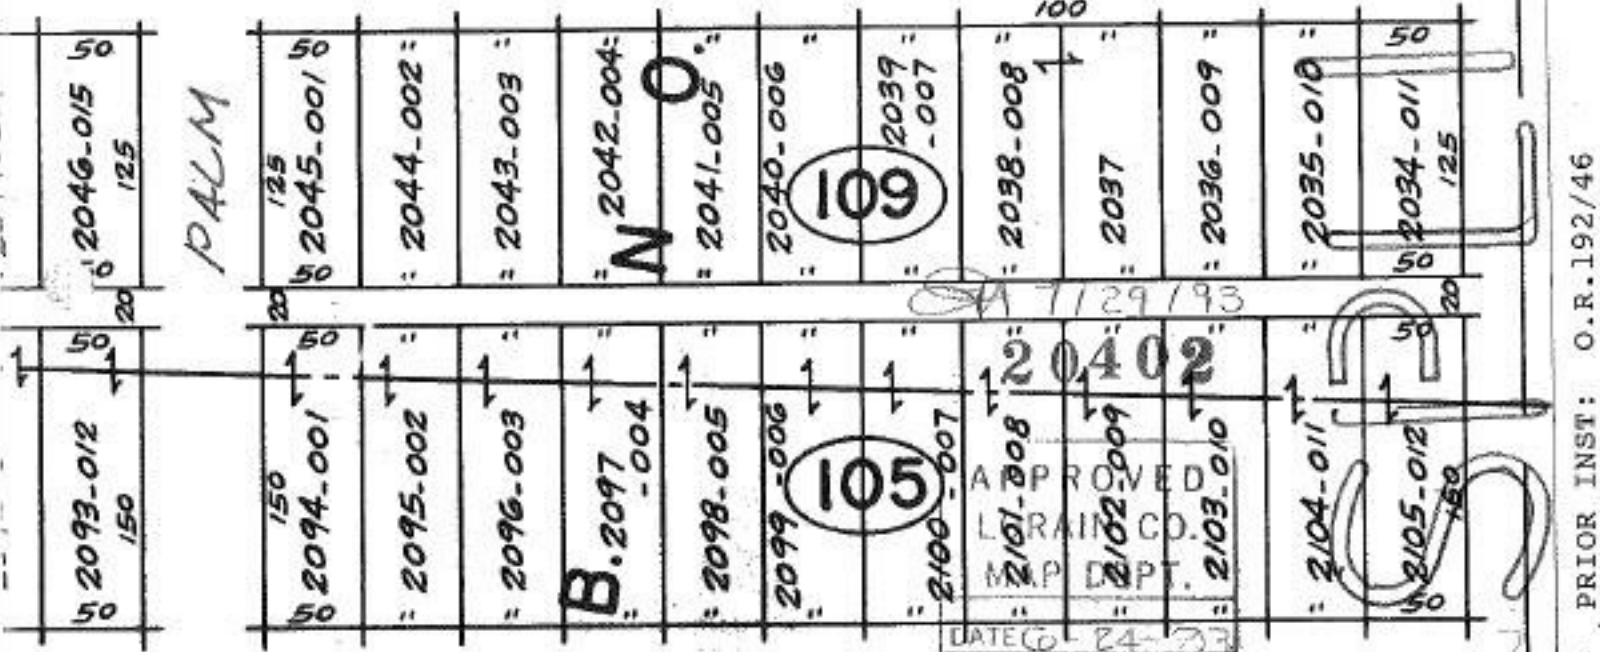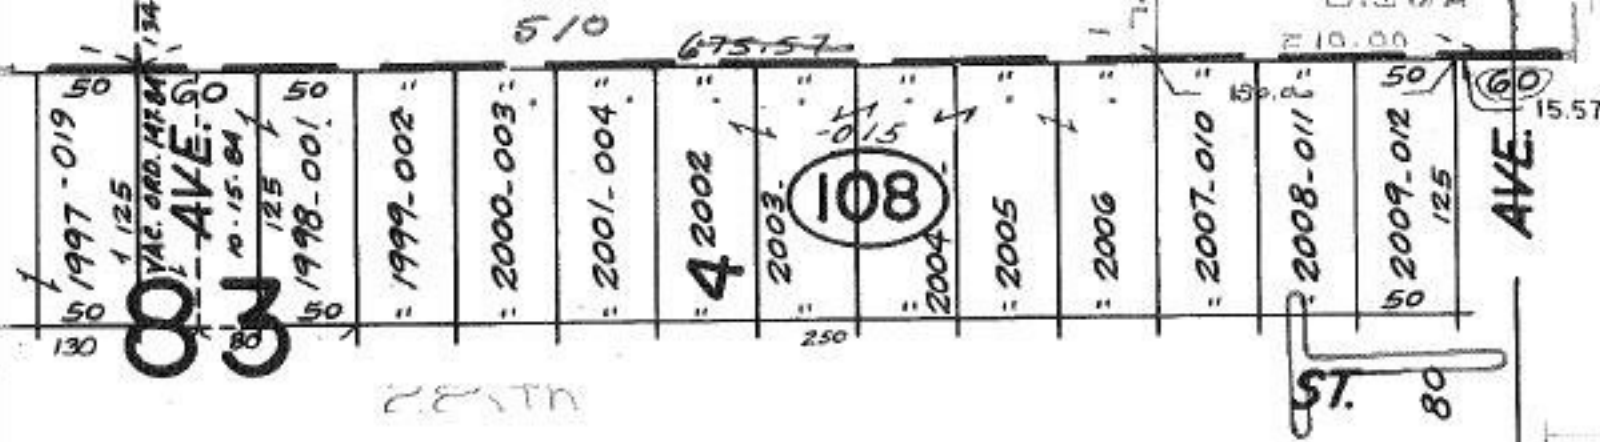

APPROVED
L. RAIN CO.
M.P. DEPT.
DATE 24-23
PAGE 3-0-021A
BY CAROLYN
BY FRANCIS
NO. 20402

03-00-083-101- PRIOR INST: O.R. 192/46
SURVEYED BY: K. S. ASSOC C=LINE.