


PARCEL WAS CHANGED FROM
ACREAGE TO FRONTAGE &
DEPTH PER MAP DEPT.
CAL.

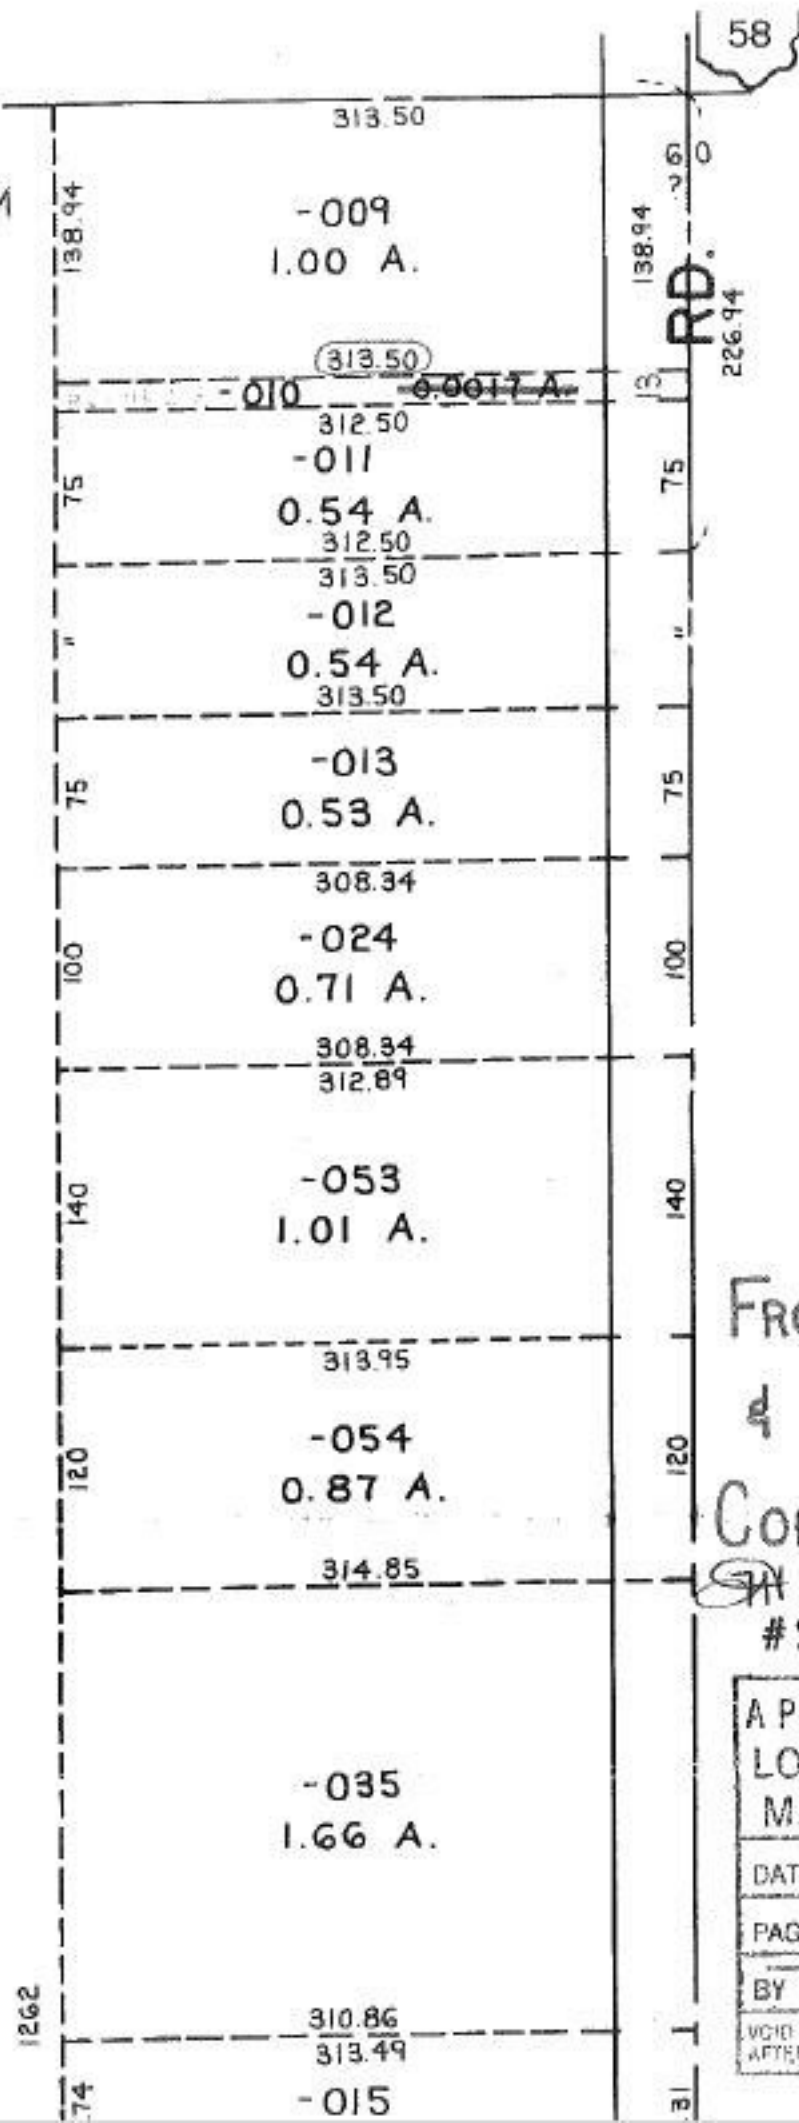

FRONTAGE
& DEPTH
CORRECTION

6/28/93
#20403-A

APPROVED	
LORAIN CO.	
MAP DEPT.	
DATE 6/17/93	
PAGE 5-00-033B	
BY T. HOLLIS	
VOID AFTER	20403-A