


GREEN RD
ST
E
R

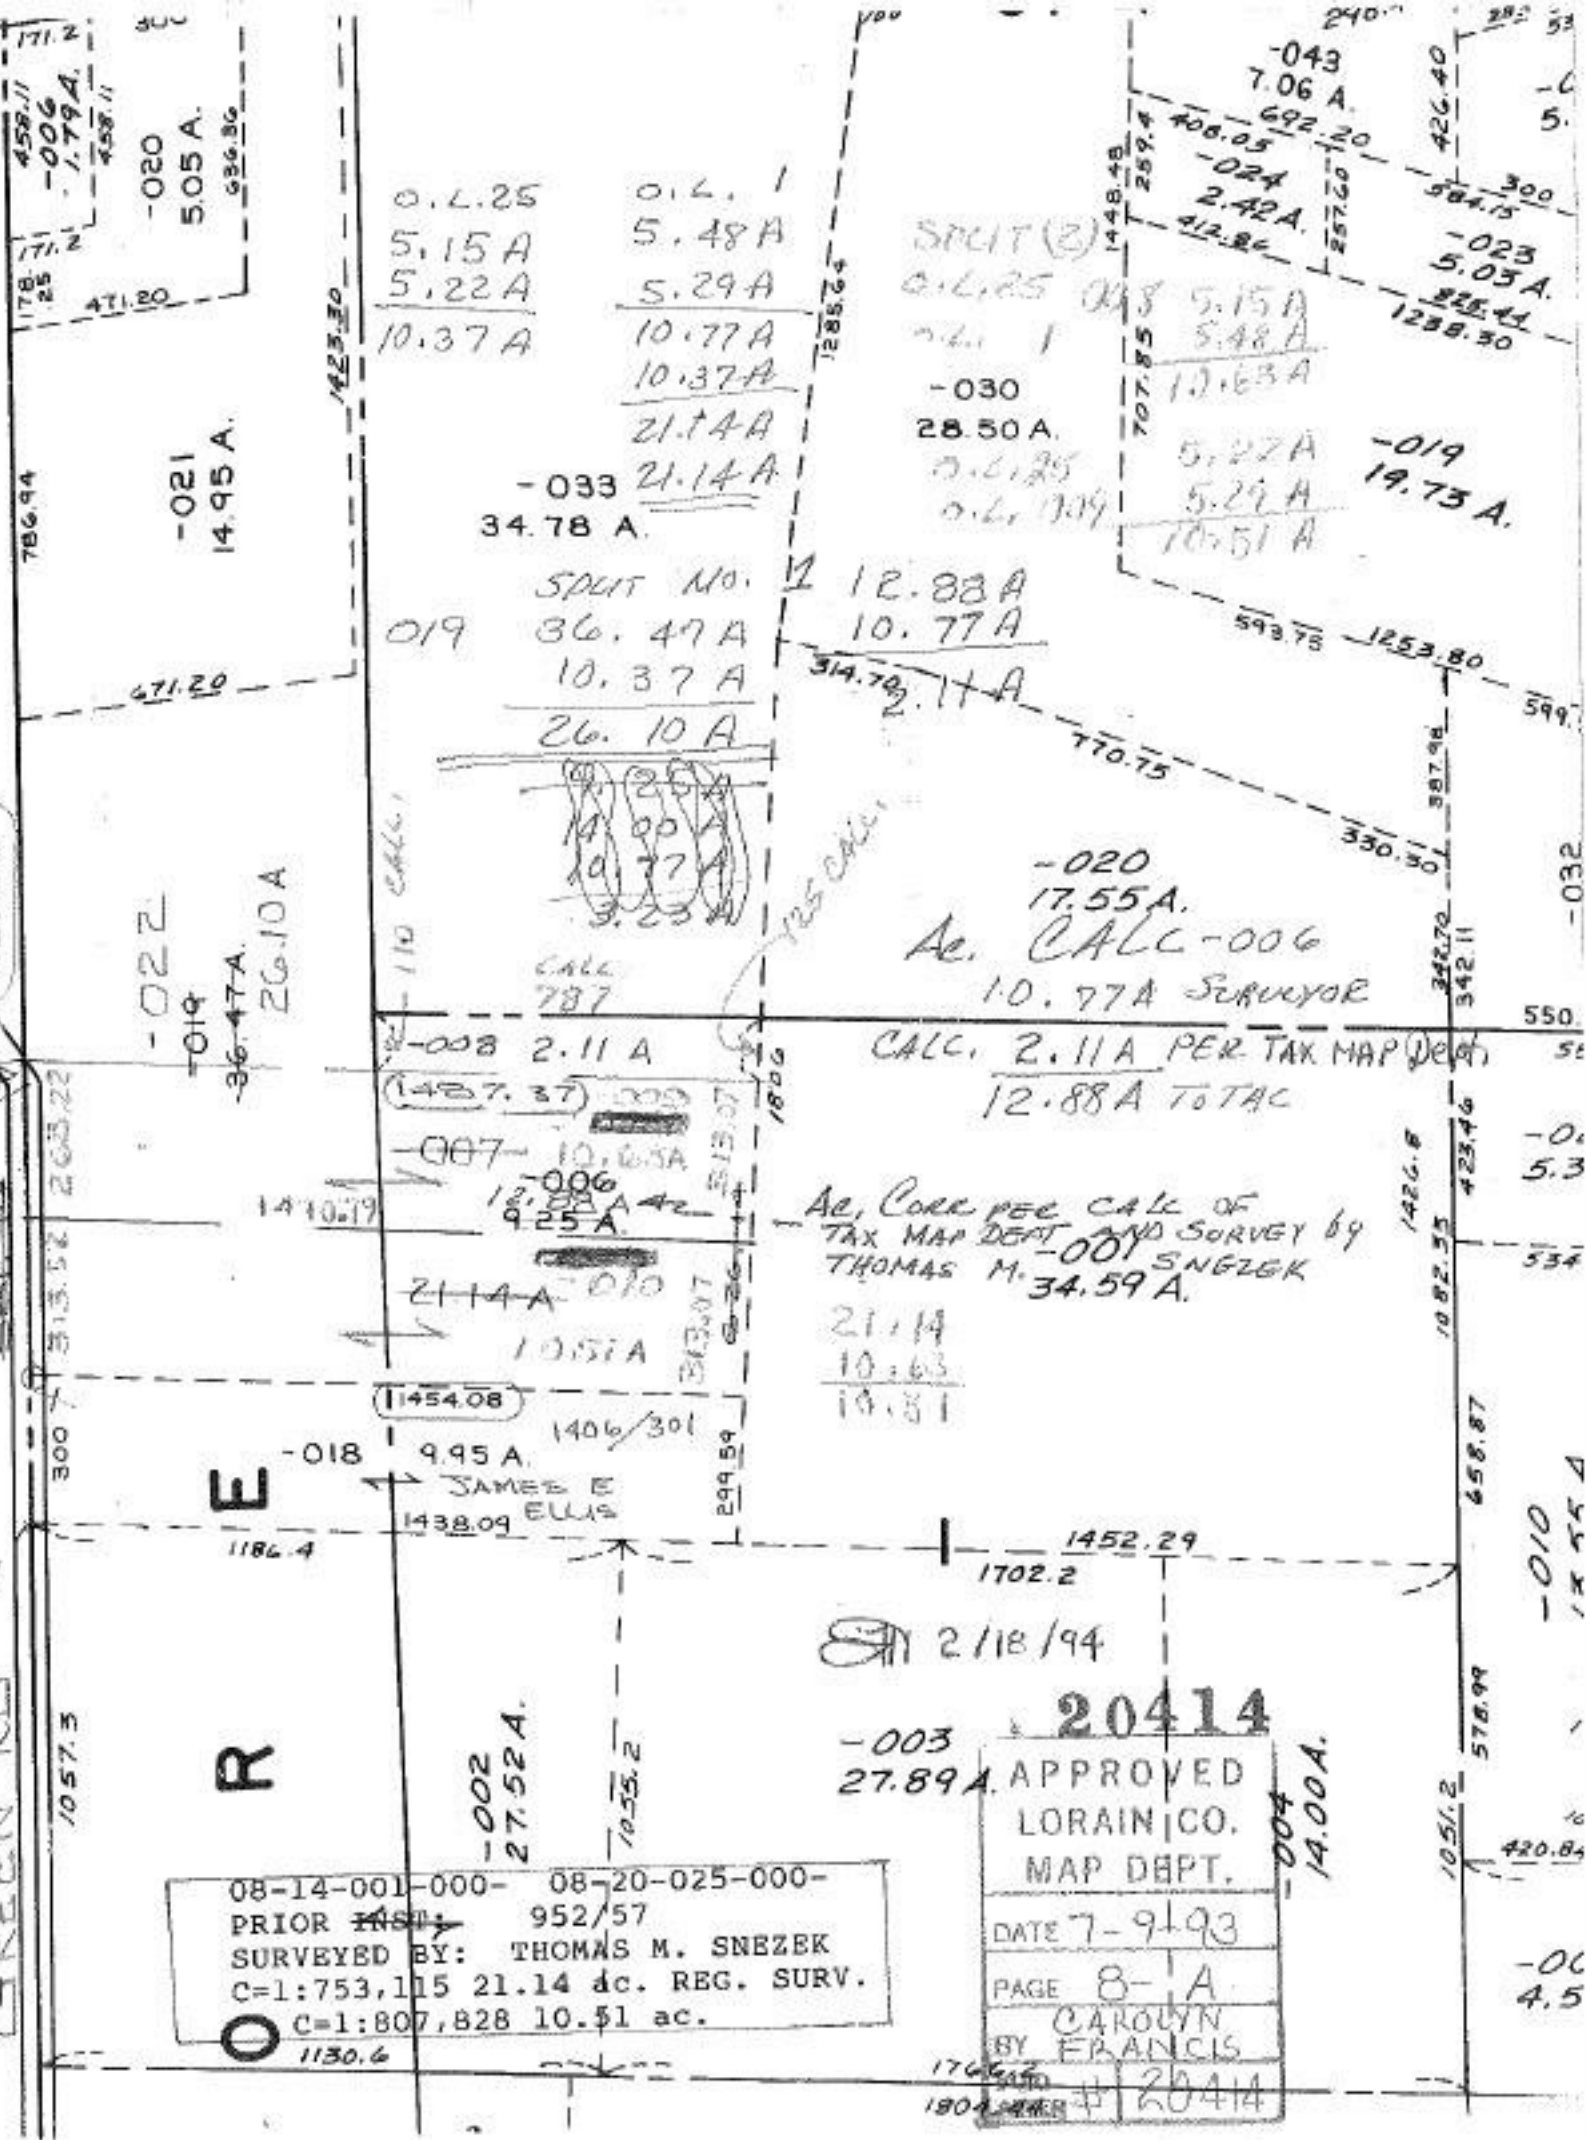

0.2.25
5.15 A
5.22 A
10.37 A
0.2.1
5.48 A
5.29 A
10.77 A
10.37 A
21.14 A
21.14 A
-033
34.78 A.

SPLIT (2)
0.2.25
0.2.1
-030
28.50 A.
0.2.25
0.2.109

-043
7.06 A.
692.20
408.05
-024
2.42 A.
412.86
02758
426.40
300
584.75
-023
5.03 A.
825.44
1288.30

SPLIT NO. 1
019
36.47 A
10.37 A
26.10 A
14.00 A
10.77 A
3.23 A

12.88 A
10.77 A
2.11 A
-020
17.55 A.
Ac. CALC -006
10.77 A SCARVOR

-019
19.73 A.
593.75
1253.80
397.98
330.30
342.70
342.11
-030
550.

-008
2.11 A
-007
10.63 A
-006
12.88 A
9.25 A
21.14 A
10.51 A

CALL 787
CALC. 2.11 A PER TAX MAP DEPT
12.88 A TOTAC
Ac. CORR PER CALL OF TAX MAP DEPT AND SURVEY BY THOMAS M. SNEZEK
-001
34.59 A.
21.14
10.63
10.81

1426.8
1082.35
423.46
-0.
5.3
534

-018
9.95 A.
JAMES E
1438.09
ELLIS
11454.08
1406/301
-002
27.52 A.
10.55.2
299.59

1452.29
1702.2
2/18/94
-003
27.89 A.
20414
APPROVED
LORAIN CO.
MAP DEPT.

658.87
578.99
-010
18.55 A
420.84
-004
14.00 A.
1051.2
578.99

08-14-001-000-08-20-025-000-
PRIOR INST. 952/57
SURVEYED BY: THOMAS M. SNEZEK
C=1:753,115 21.14 ac. REG. SURV.
C=1:807,828 10.51 ac.

20414
APPROVED
LORAIN CO.
MAP DEPT.
DATE 7-9-93
PAGE 8-A
BY CAROLYN FRANCIS
20414