

137.62 A.

REDRAW


- 019
- 021
- 027

R

BURSLEY ROAD DEDICATION - COMM. RES. 76-250
3519.12

750

NR

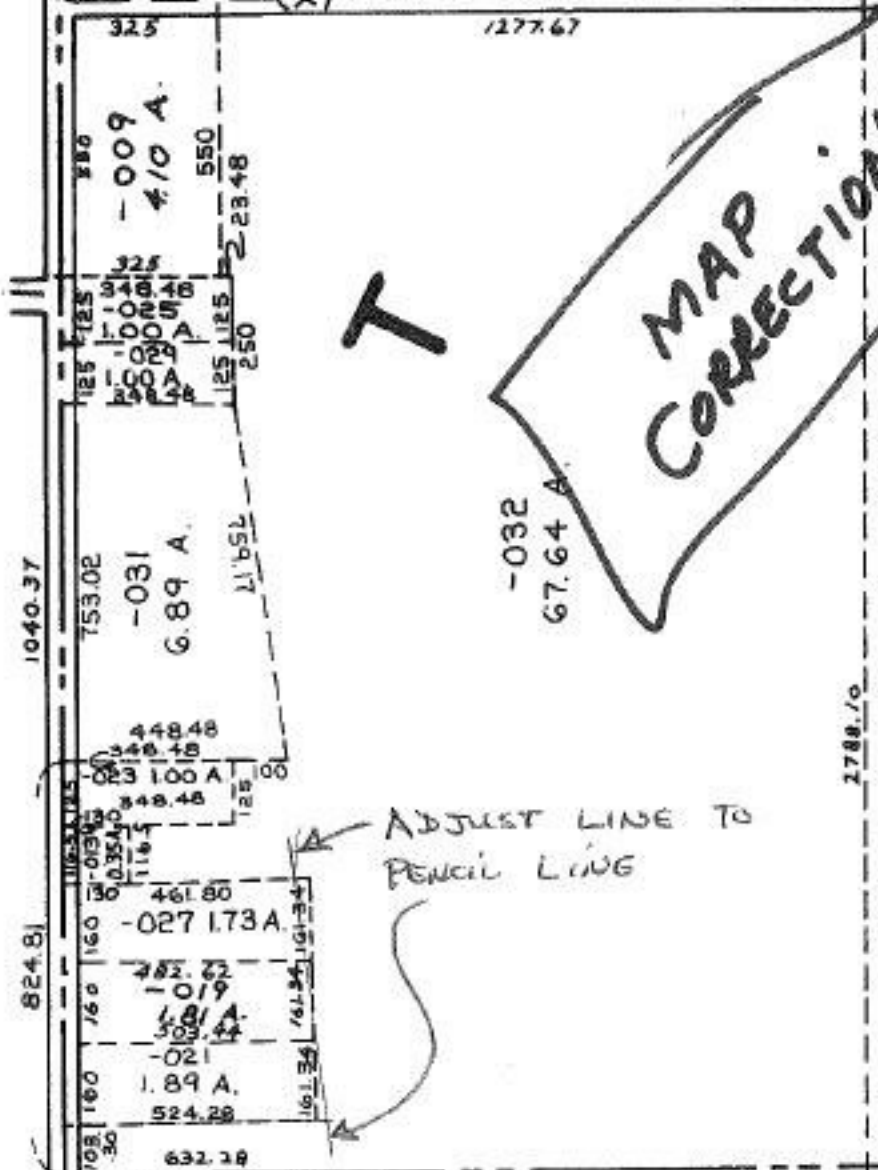

MAP CORRECTION

-032
67.64 A.

T

- 018
138.09

4/14/94
#20418A

APPROVED
LORAIN CO.
MAP DEPT.
DATE 7-12-93
PAGE 21-C
BY *[Signature]*
VOID AFTER 20418A

ADJUST LINE TO PENCIL LINE

Pt. -027
Pt. 16.46 A.

2573.27
2677.55

Pt. - 021
BY 81.1.3 A