



COMBINATION

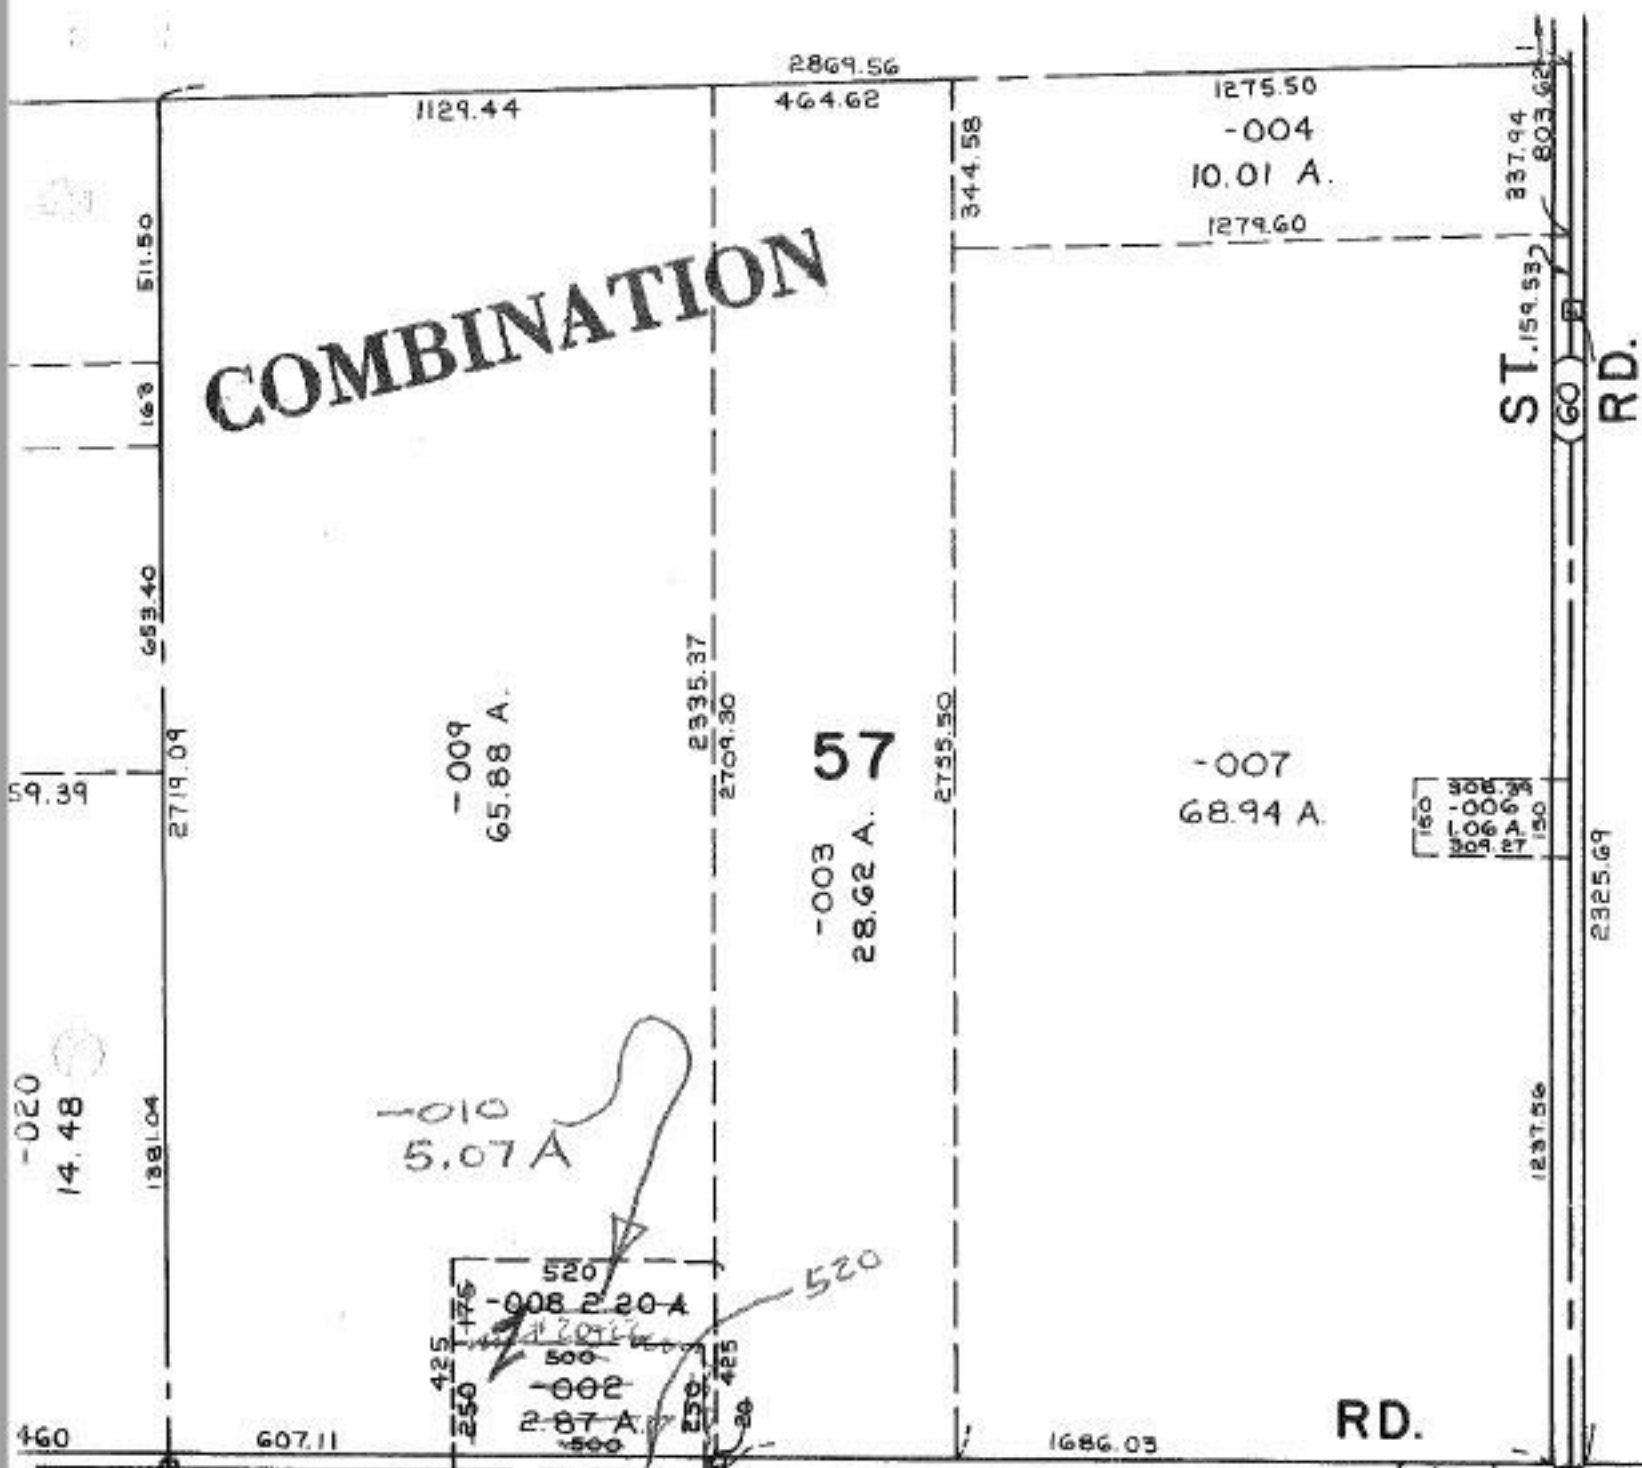

57

-007
68.94 A.

-010
5.07 A

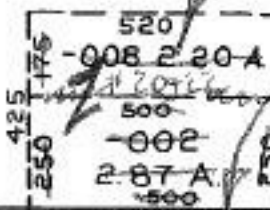

CSA 2128194
#20422

COMBINATION

APPROVED
LORAIN CO.
MAP DEPT.
DATE 7-9-93
PAGE 9-G
BY <i>J. E. ...</i>
VOID AFTER 20422

0-067-A

0-067-B