


SEE 5-00-

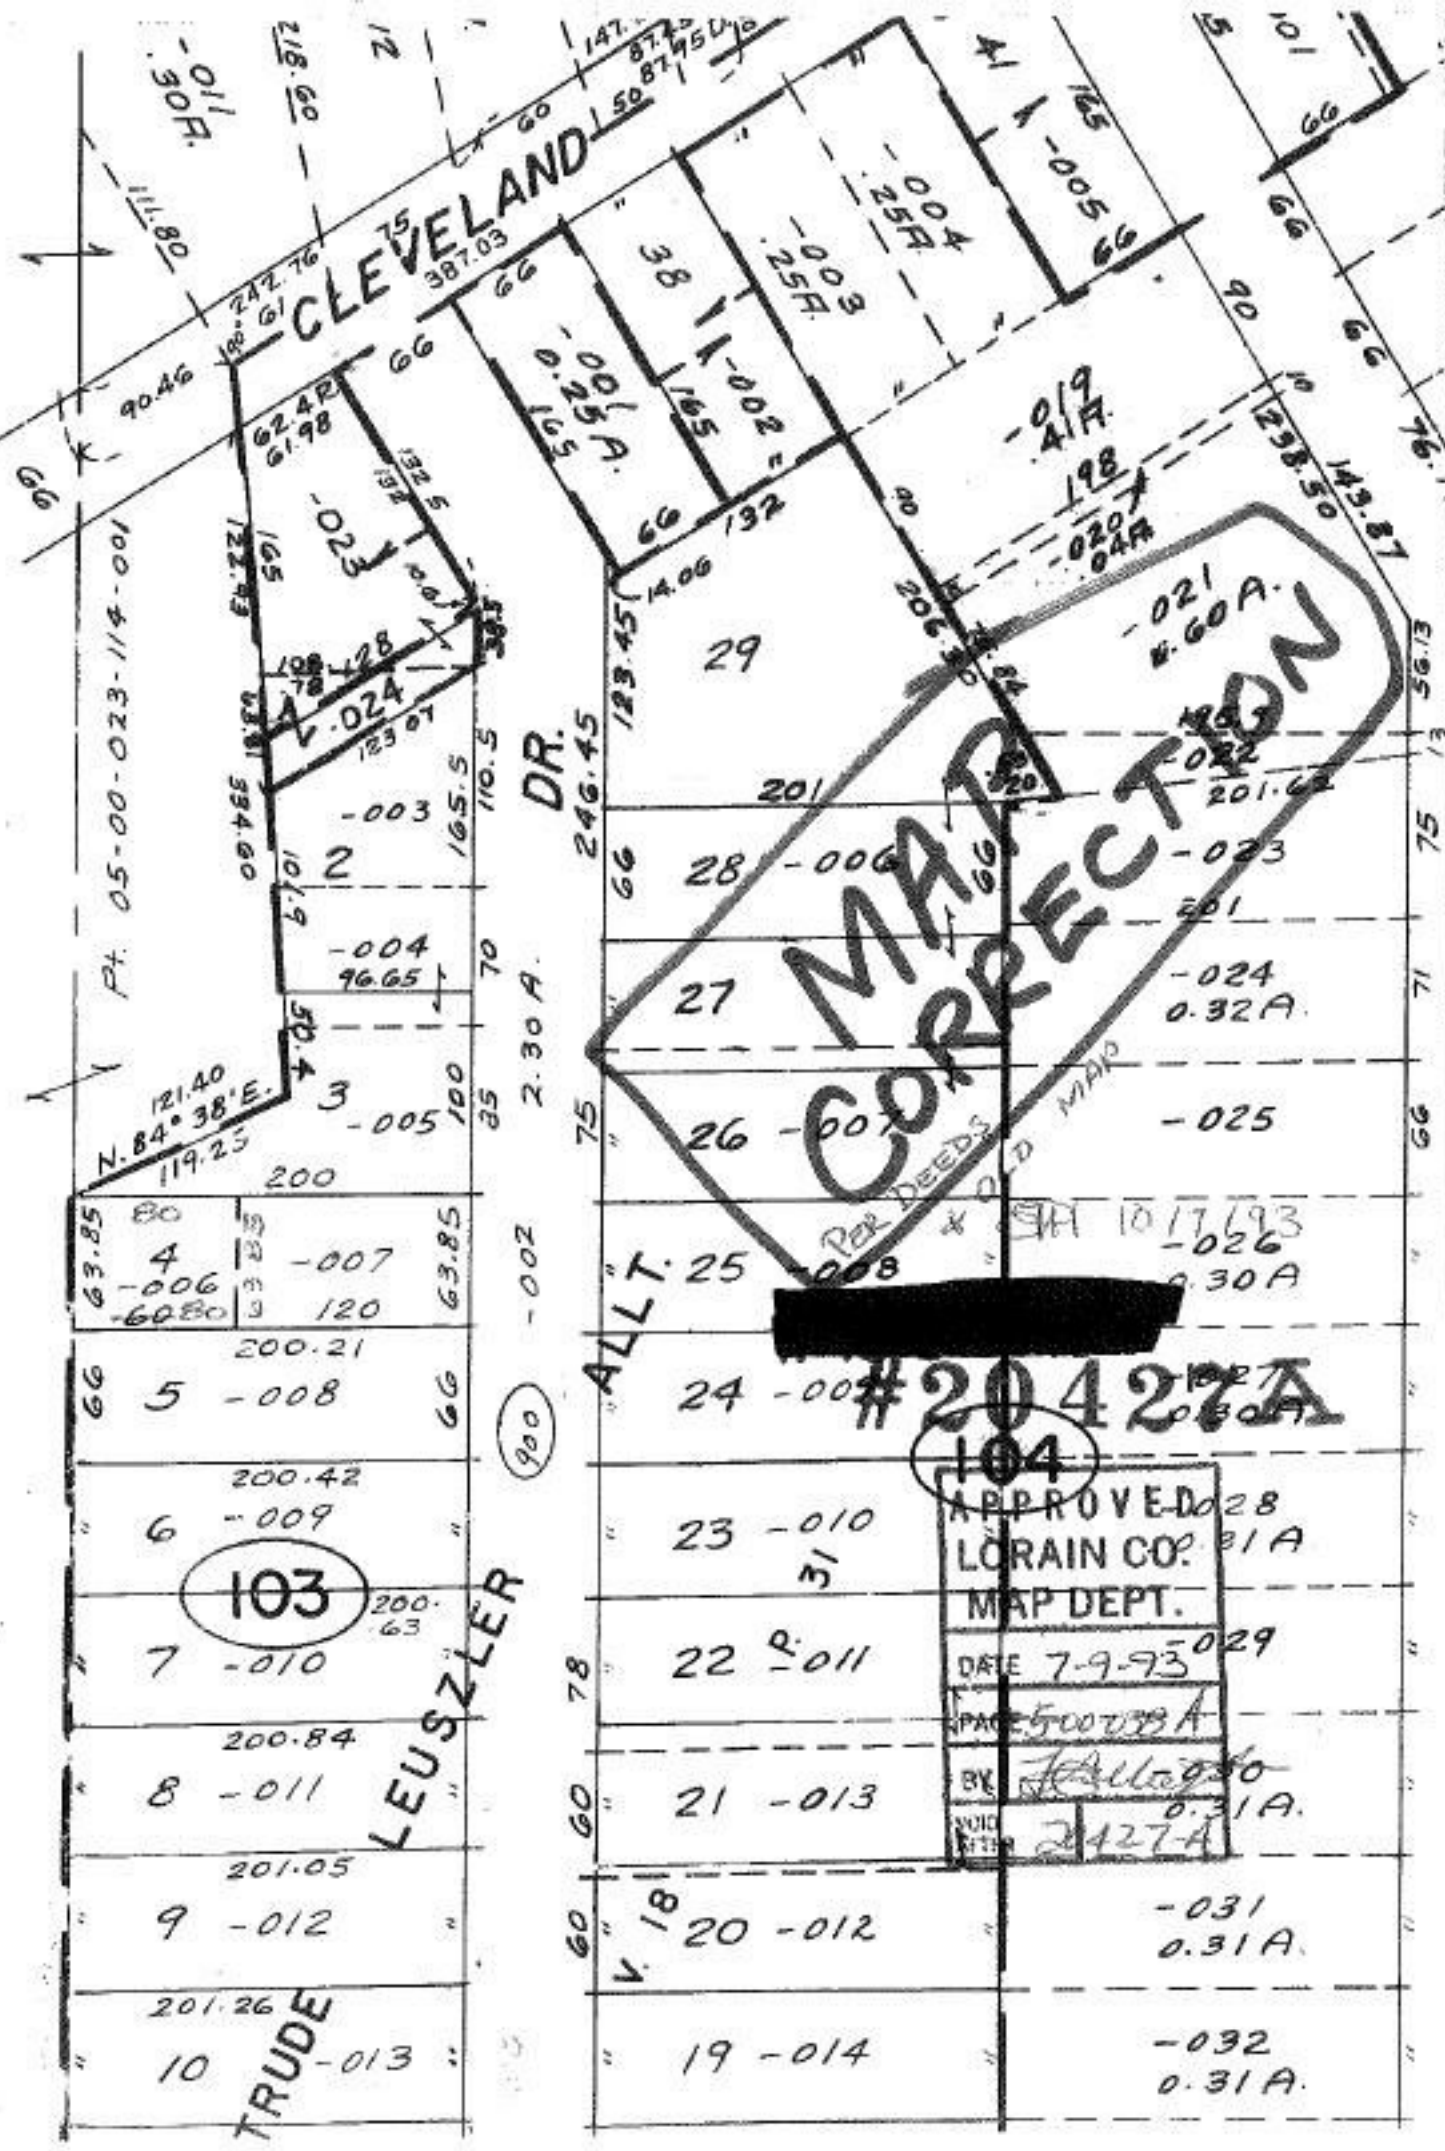

63.85	80		
4	-006	120	63.85
200.21			
66	5	-008	66
	6	-009	
	7	-010	
	8	-011	
	9	-012	
	10	-013	

103

LEUSZLER

TRUDE

900

DR.

-002

2.30 A.

246.45

123.45

66

66

60

60

ALLT. 25

26

27

28

29

19

20

22

23

24

25

26

27

18

19

20

21

22

23

24

17

18

19

20

21

22

23

16

17

18

19

20

21

22

15

16

17

18

19

20

21

14

15

16

17

18

19

20

13

14

15

16

17

18

19

12

13

14

15

16

17

18

11

12

13

14

15

16

17

10

11

12

13

14

15

16

9

10

11

12

13

14

15

8

9

10

11

12

13

14

7

8

9

10

11

12

13

6

7

8

9

10

11

12

5

6

7

8

9

10

11

4

5

6

7

8

9

10

3

4

5

6

7

8

9

2

3

4

5

6

7

8

1

2

3

4

5

6

7

0

1

2

3

4

5

6

0

1

2

3

4

5

6

0

1

2

3

4

5

6

0

1

2

3

4

5

6

0

1

2

3

4

5

6

0

1

2

3

4

5

6

0

1

2

3

4

5

6

0

1

2

3

4

5

6

0

1

2

3

4

5

6

0

1

2

3

4

5

6

0

1

2

3

4

5

6

0

1

2

3

4

5

6

0

1

2

3

4

5

6

0

1

2

3

4

5

6

0

1

2

3

4

5

6

0

1

2

3

4

5

6

0

1

2

3

4

5

6

0

1

2

3

4

5

6

0

1

2

3

4

5

6

0

1

2

3

4

5

6

0

1

2

3

4

5

6

0

1

2

3

4

5

6

0

1

2

3

4

5

6

0

1

2

3

4

5

6

0

1

2

3

4

5

6

0

1

2