

2043

20

-015  
10.27 A.

-014  
~~-010~~  
~~15.75 A.~~  
5.48 A.

APPROVED  
LORAIN CO.  
MAP DEPT.

DATE 8-22-68

6-75

BY

*Grace*

9/26/69 R.K.



500

N.

Pt. -001  
Pt. 3.13 A.

Y.

C.

242.80

72°53'

1308.8

506.07

184°18'

24.76

176.25

137.12

Ditch

137.13

172°46'

124.17

98.46

143°32'30"

367.77

374.27

515.23


293.81

1238

104.63

22°15"

C-002  
0.30 A.

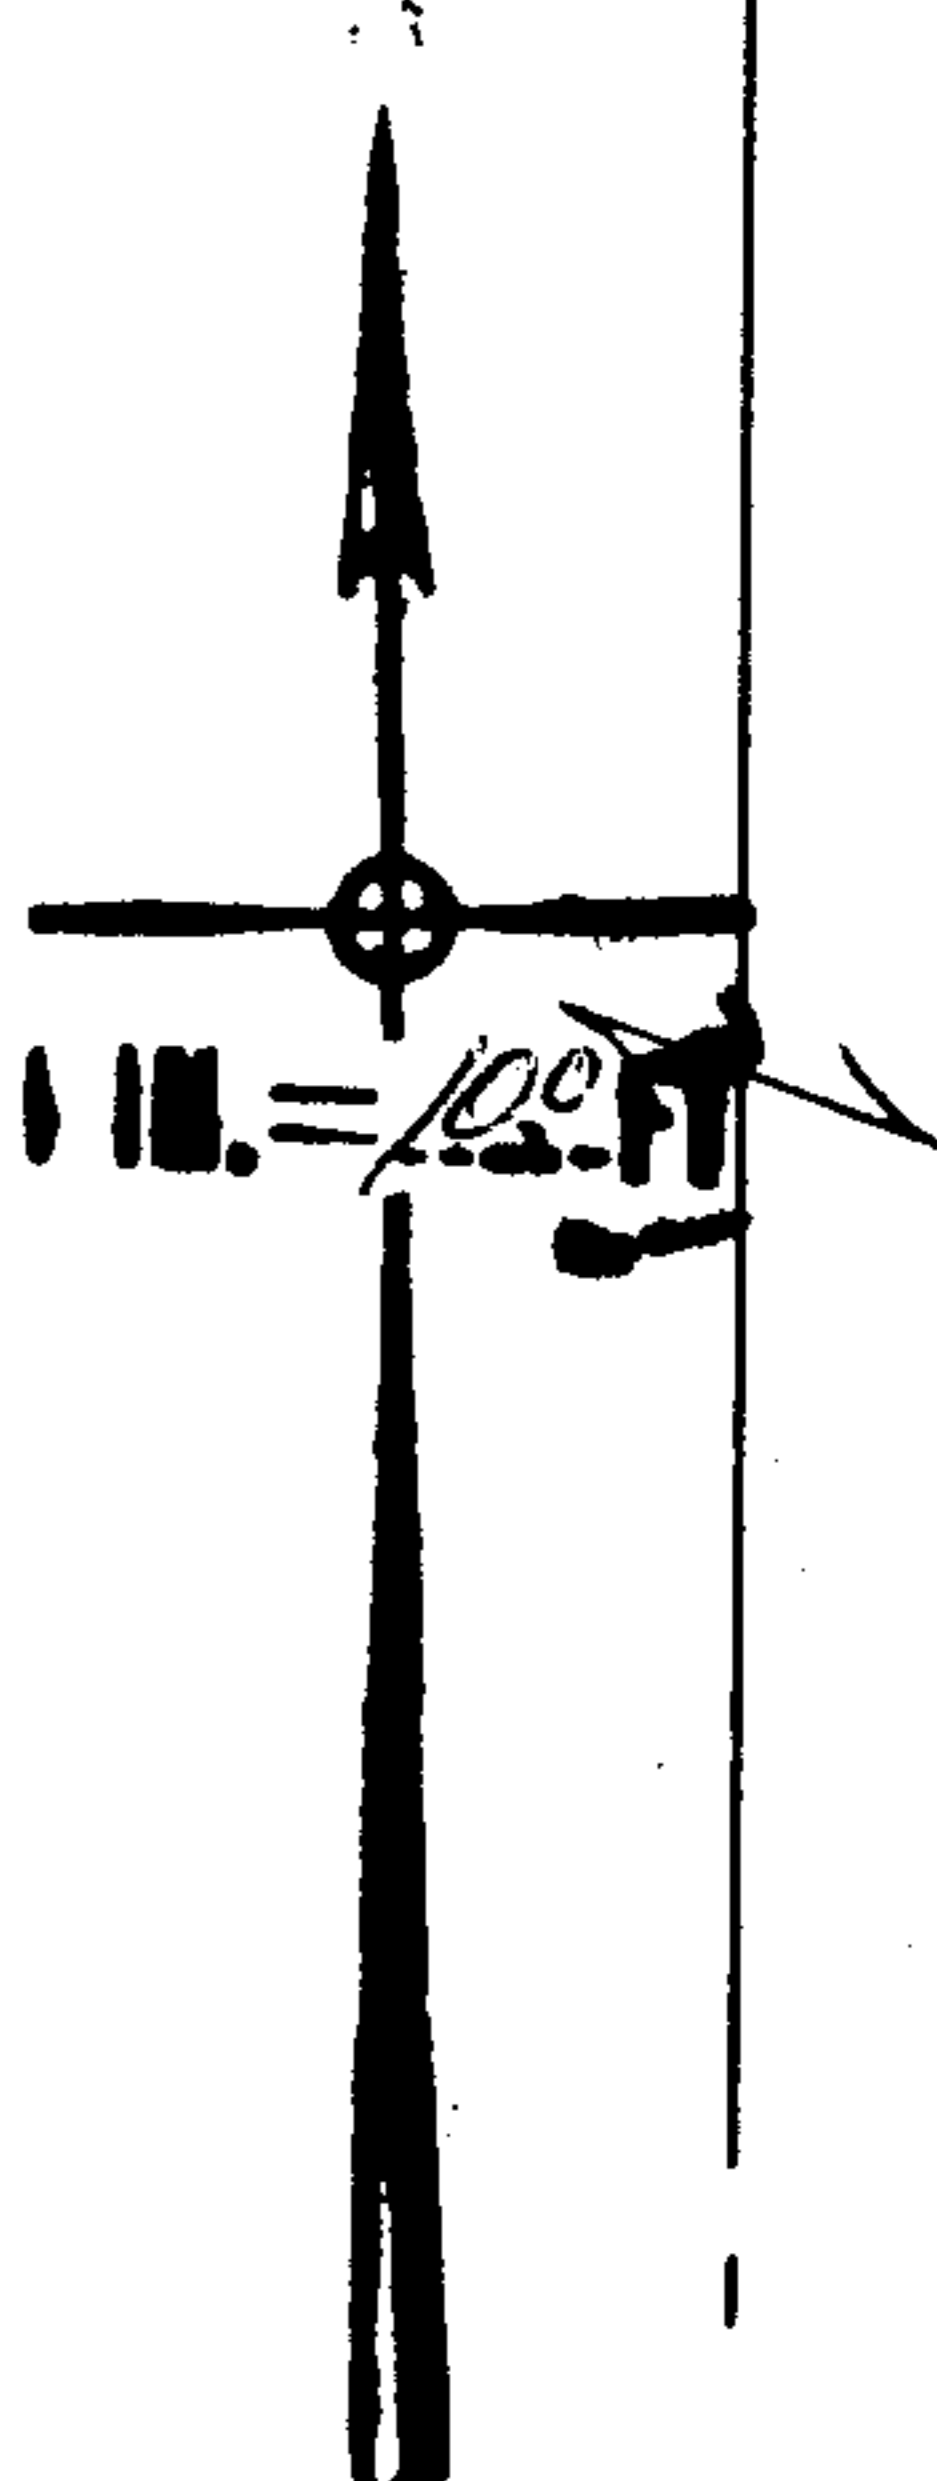

69.86

60.63

71.2

104.85

92.31

11.74

100.70

99.74