


Parcel Incorrectly Numbered  
 on Split No. 20198 BY T. McManis  
 Transfer Sheet DATED 1-11-93  
 NUMBER 8.  
 .043  
 10.77 A.

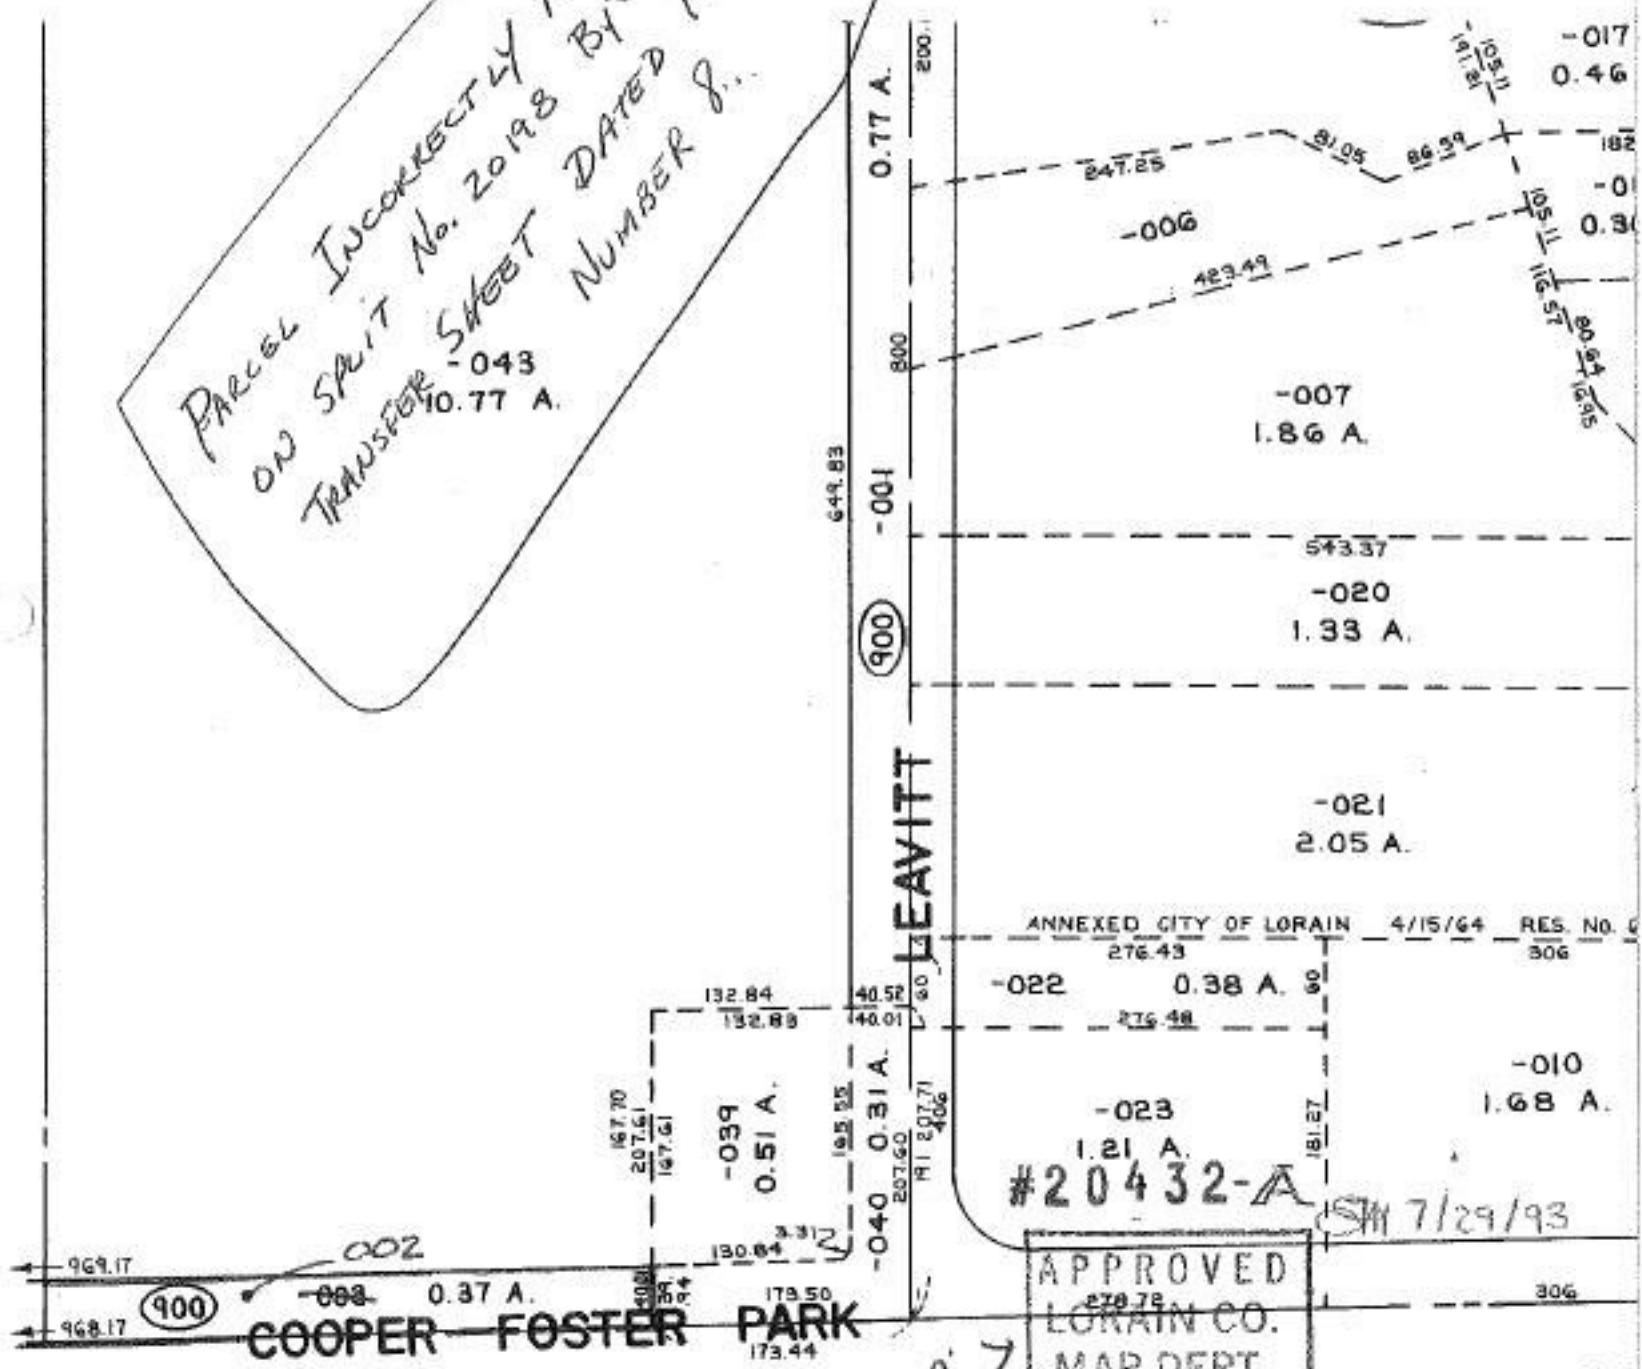

Parcel No.  
 CORRECTION

APPROVED	
LORAIN CO.	
MAP DEPT.	
DATE	7/6/93
PAGE	2-02-003
BY	T. McManis
VOID AFTER	20432-A

SEE 5-00-04