


SEE 6-114

1241.21

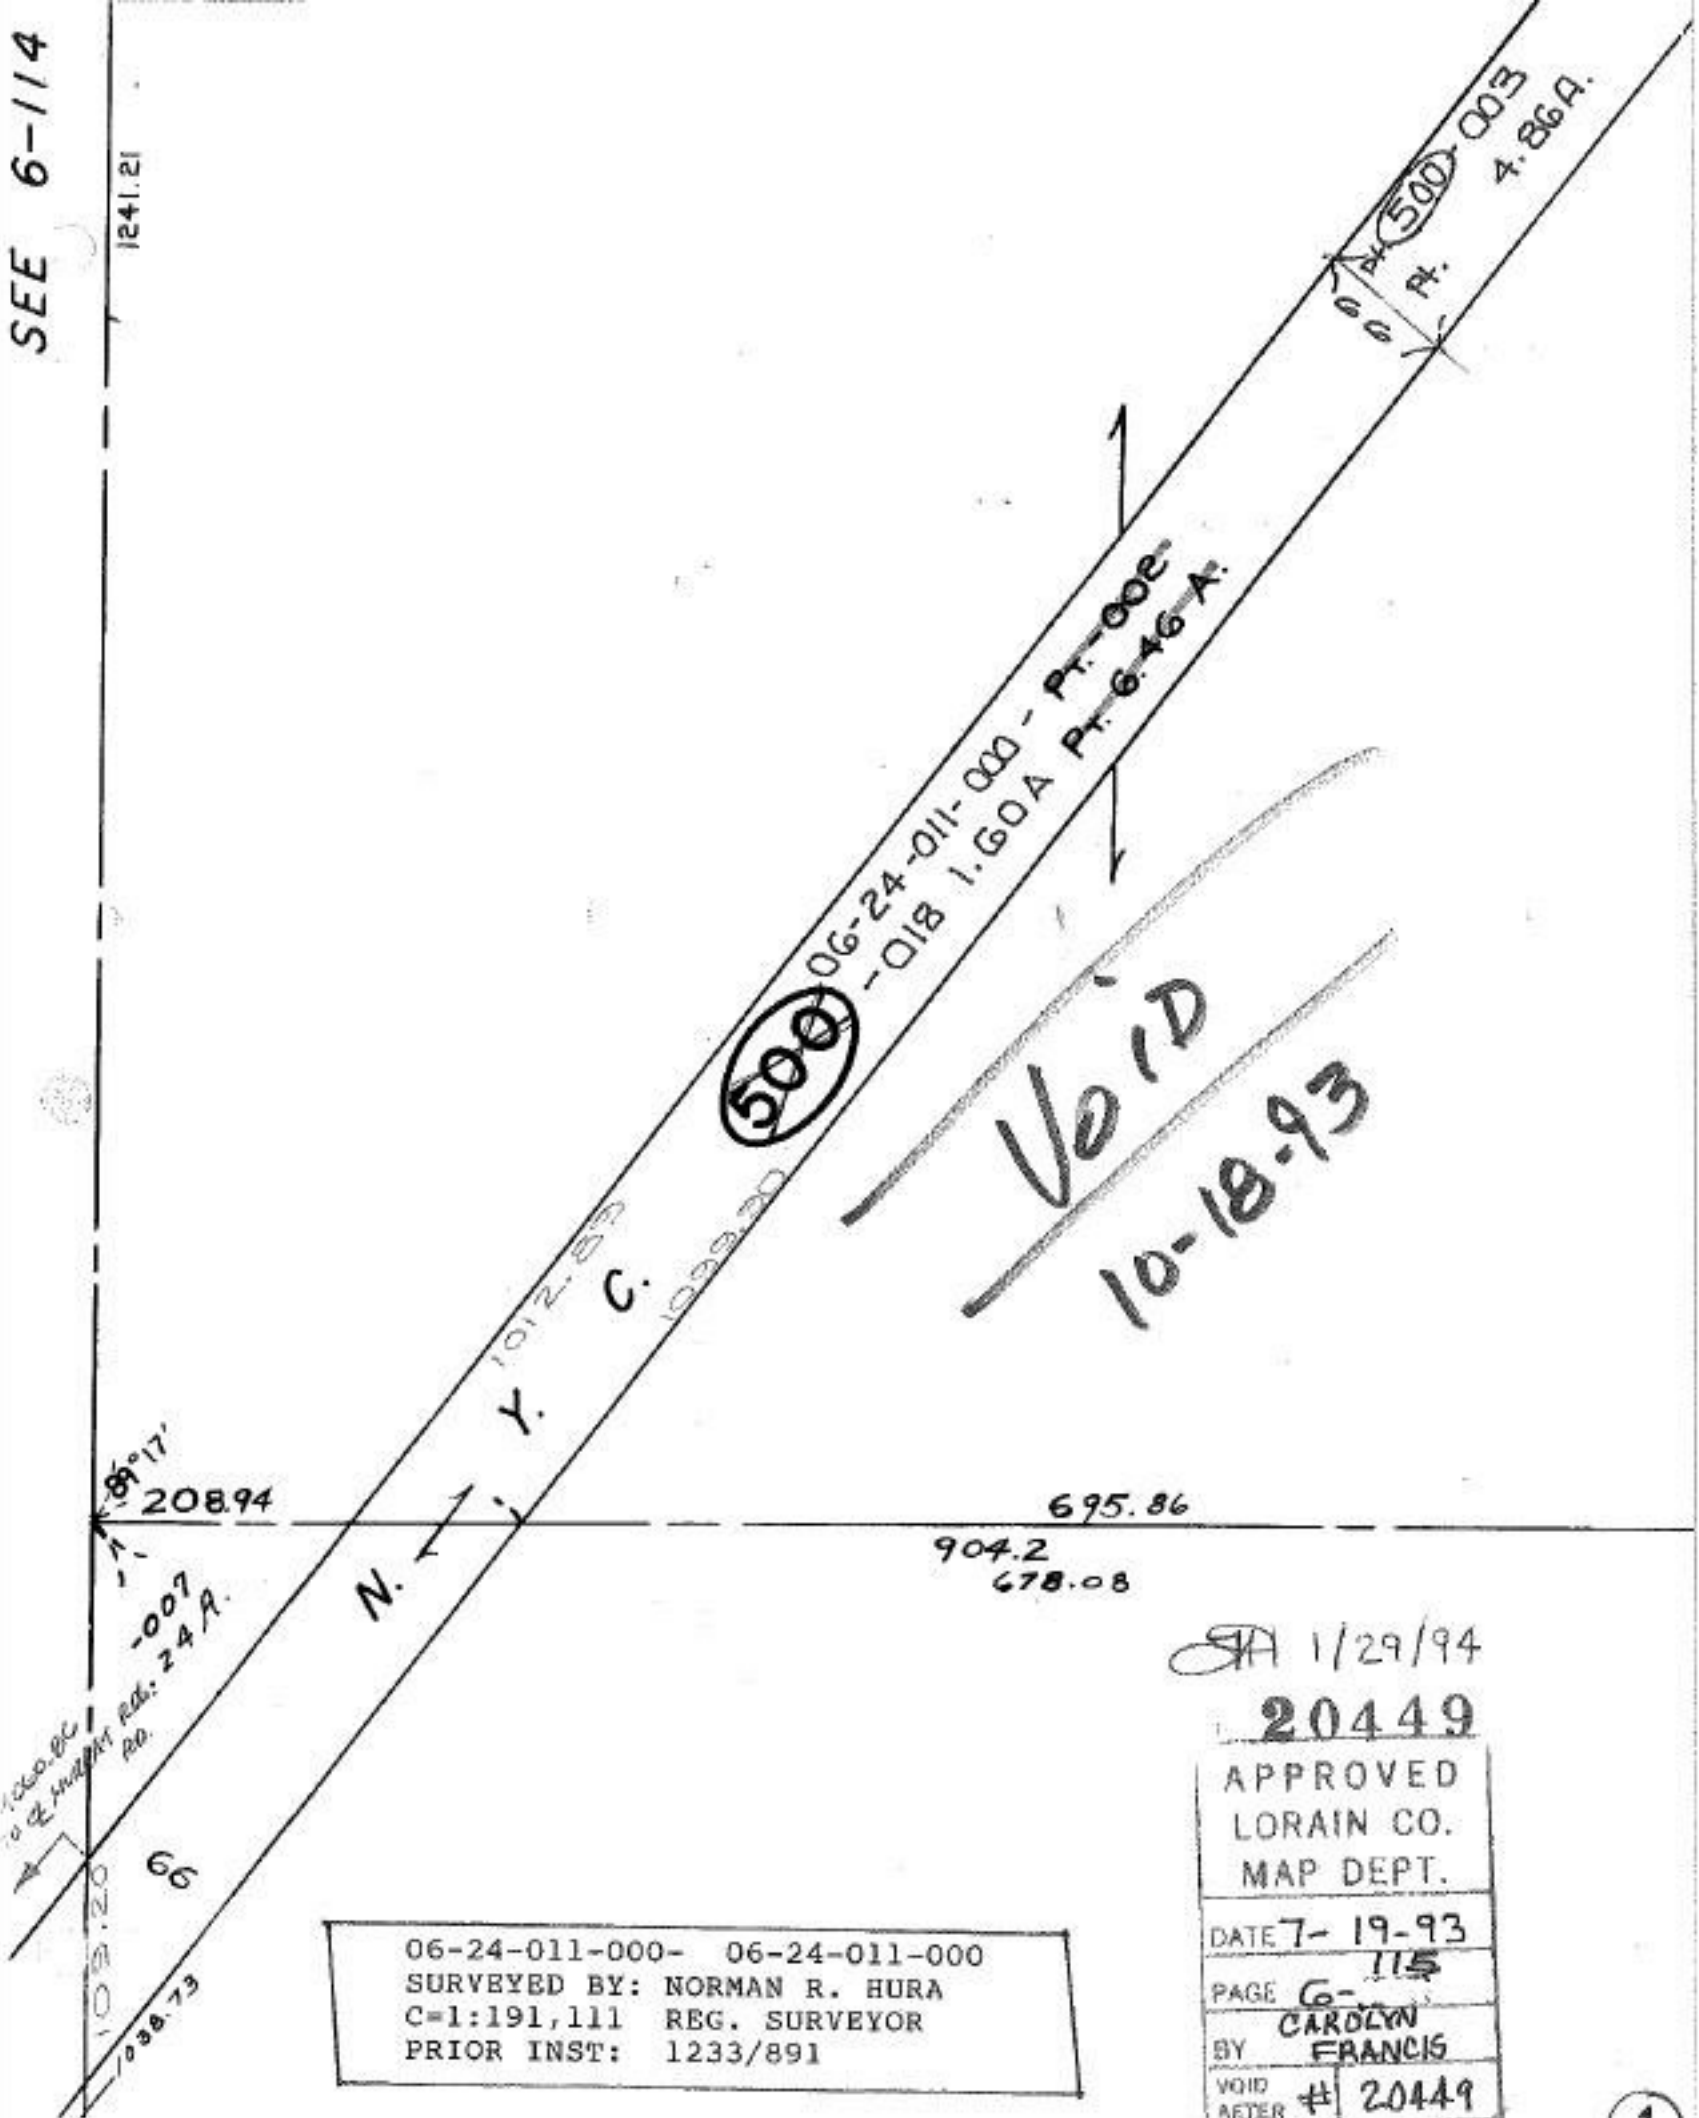

500

500

VOID
10-18-93

06-24-011-000- 06-24-011-000
 SURVEYED BY: NORMAN R. HURA
 C=1:191,111 REG. SURVEYOR
 PRIOR INST: 1233/891

SA 1/29/94
 20449
 APPROVED
 LORAIN CO.
 MAP DEPT.
 DATE 7-19-93
 PAGE 6-115
 BY CAROLYN FRANCIS
 VOID AFTER # 20449

1