


Pt.-011
Pt. 29.58 A. **96**

06-24-011-500-002 G.46 A
L.60 A
4.86 A

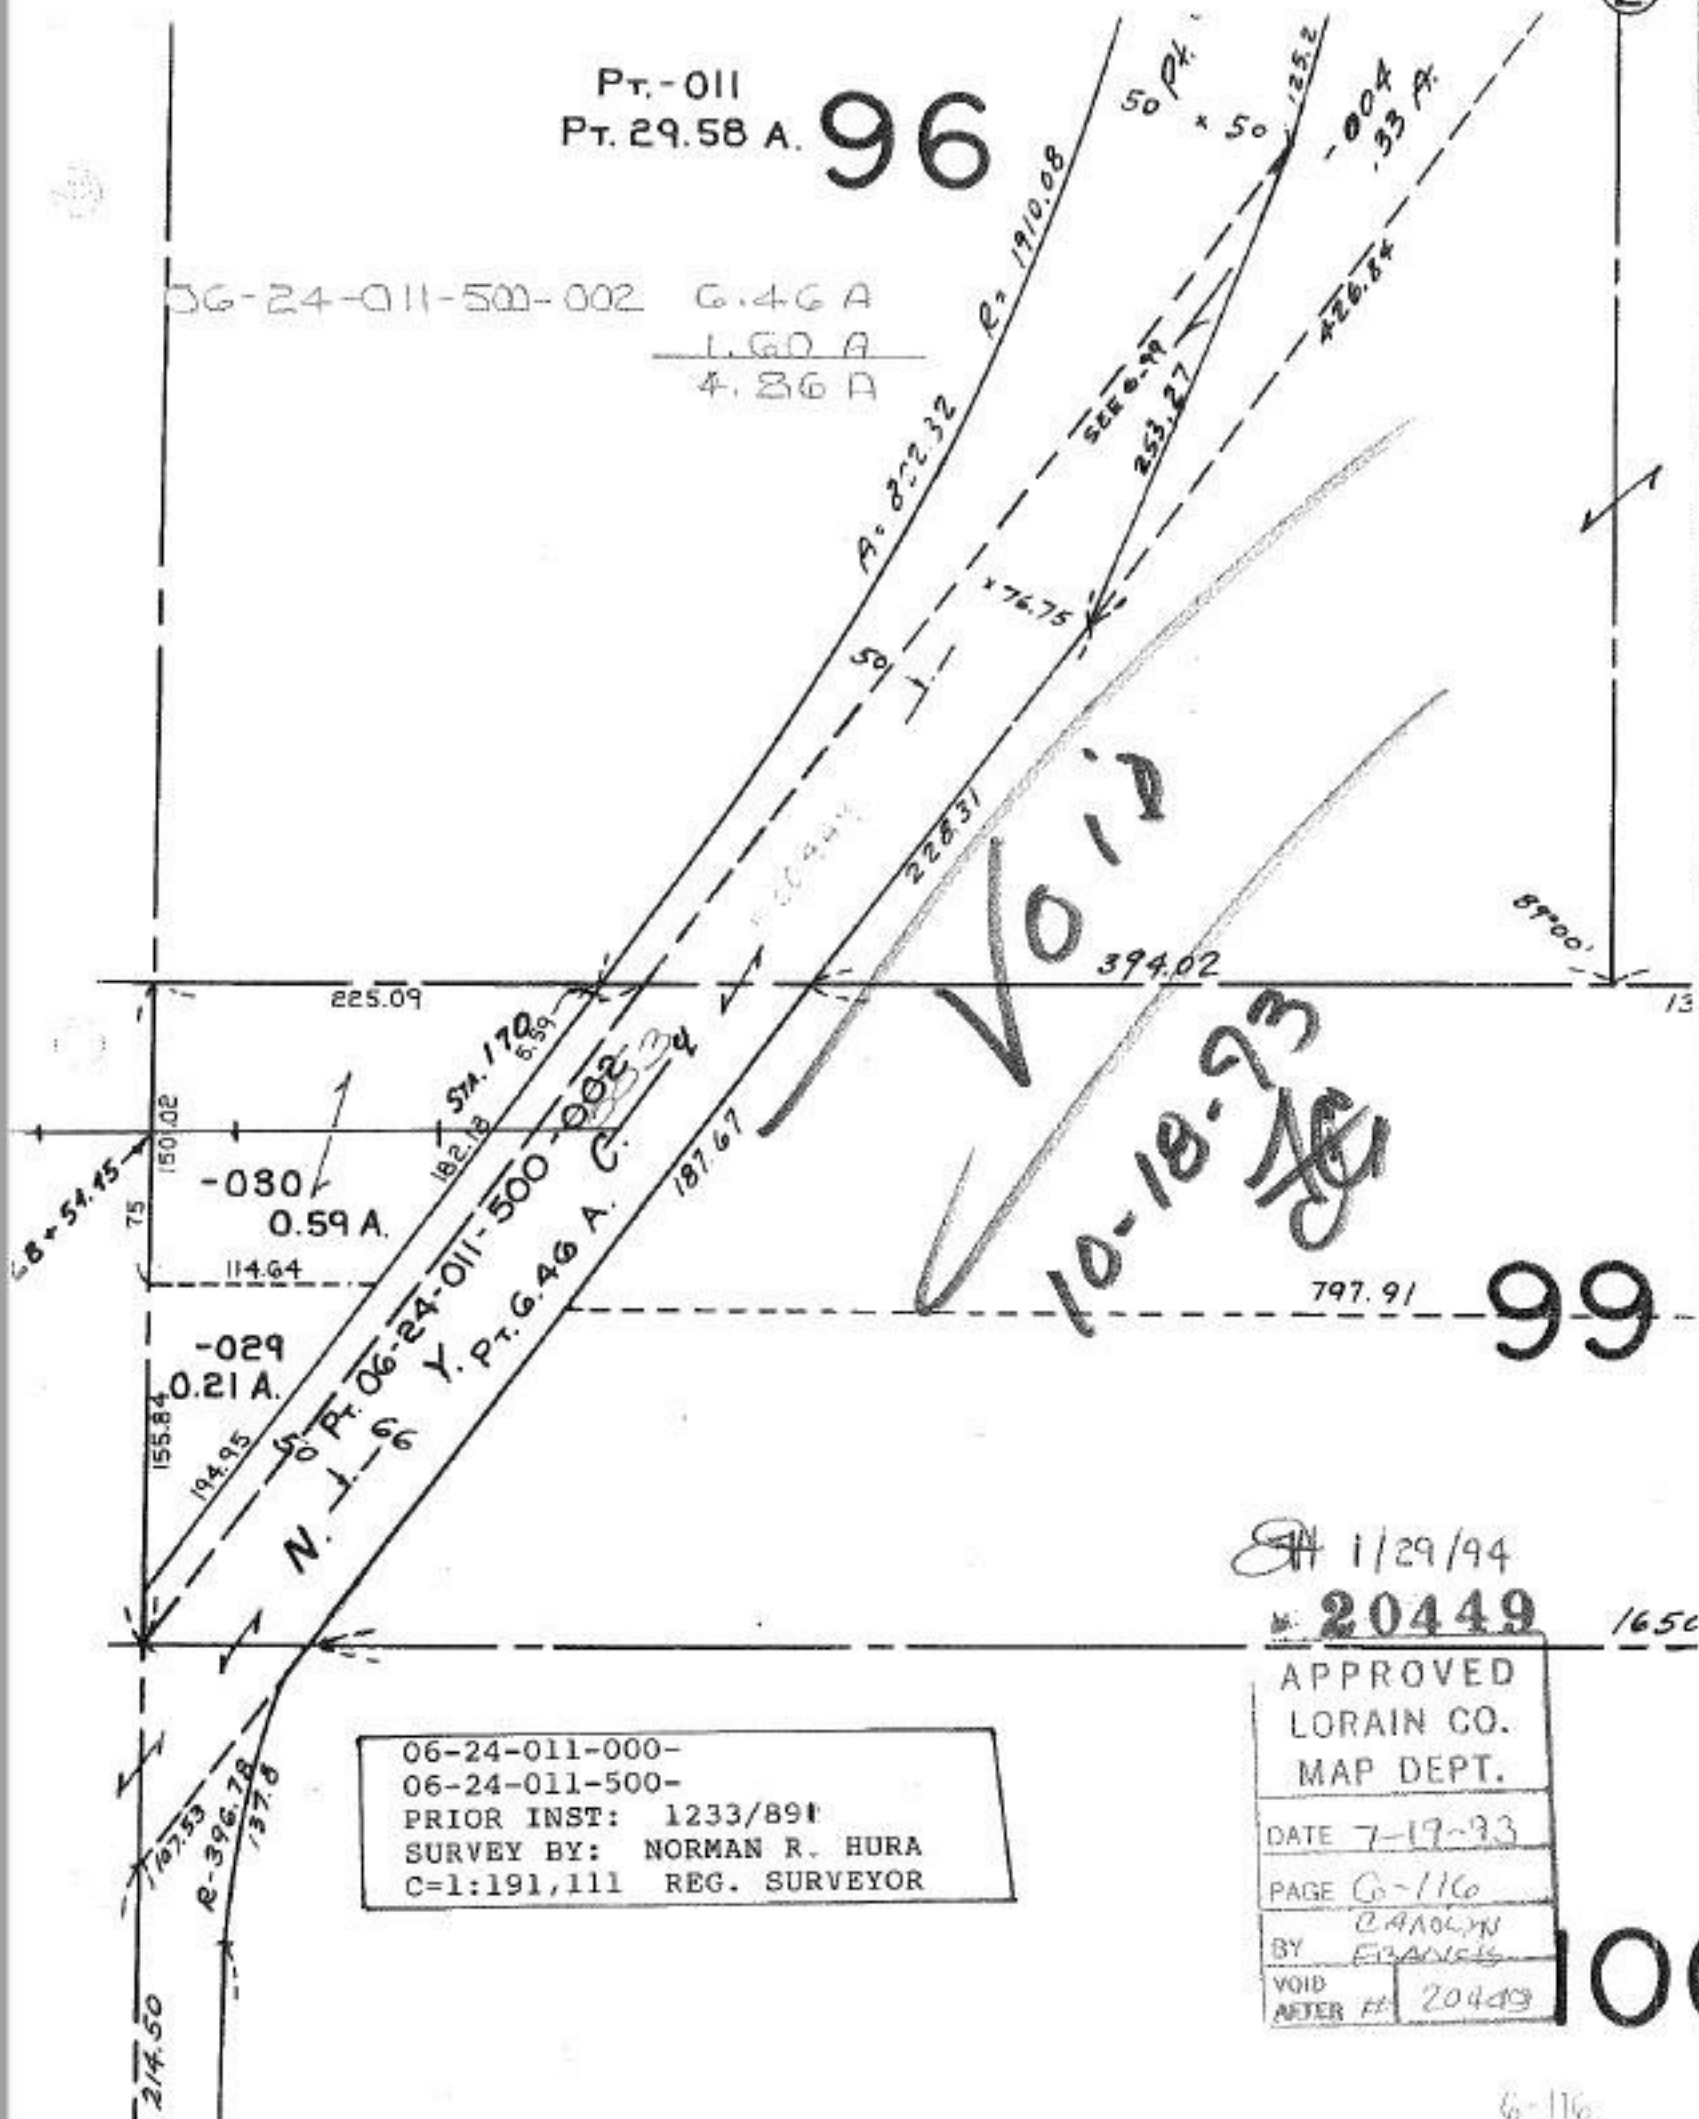

06-24-011-000-
06-24-011-500-
PRIOR INST: 1233/89†
SURVEY BY: NORMAN R. HURA
C=1:191,111 REG. SURVEYOR

1/29/94
20449

APPROVED
LORAIN CO.
MAP DEPT.
DATE 7-17-93
PAGE 6-116
BY CAROLYN
FRANCIS
VOID AFTER # 20449

100