

5 A.
10

724.08


-006
45.50 A.

48.31 A
1.01 A
47.30 A

HUGHES

2336.84

RD.

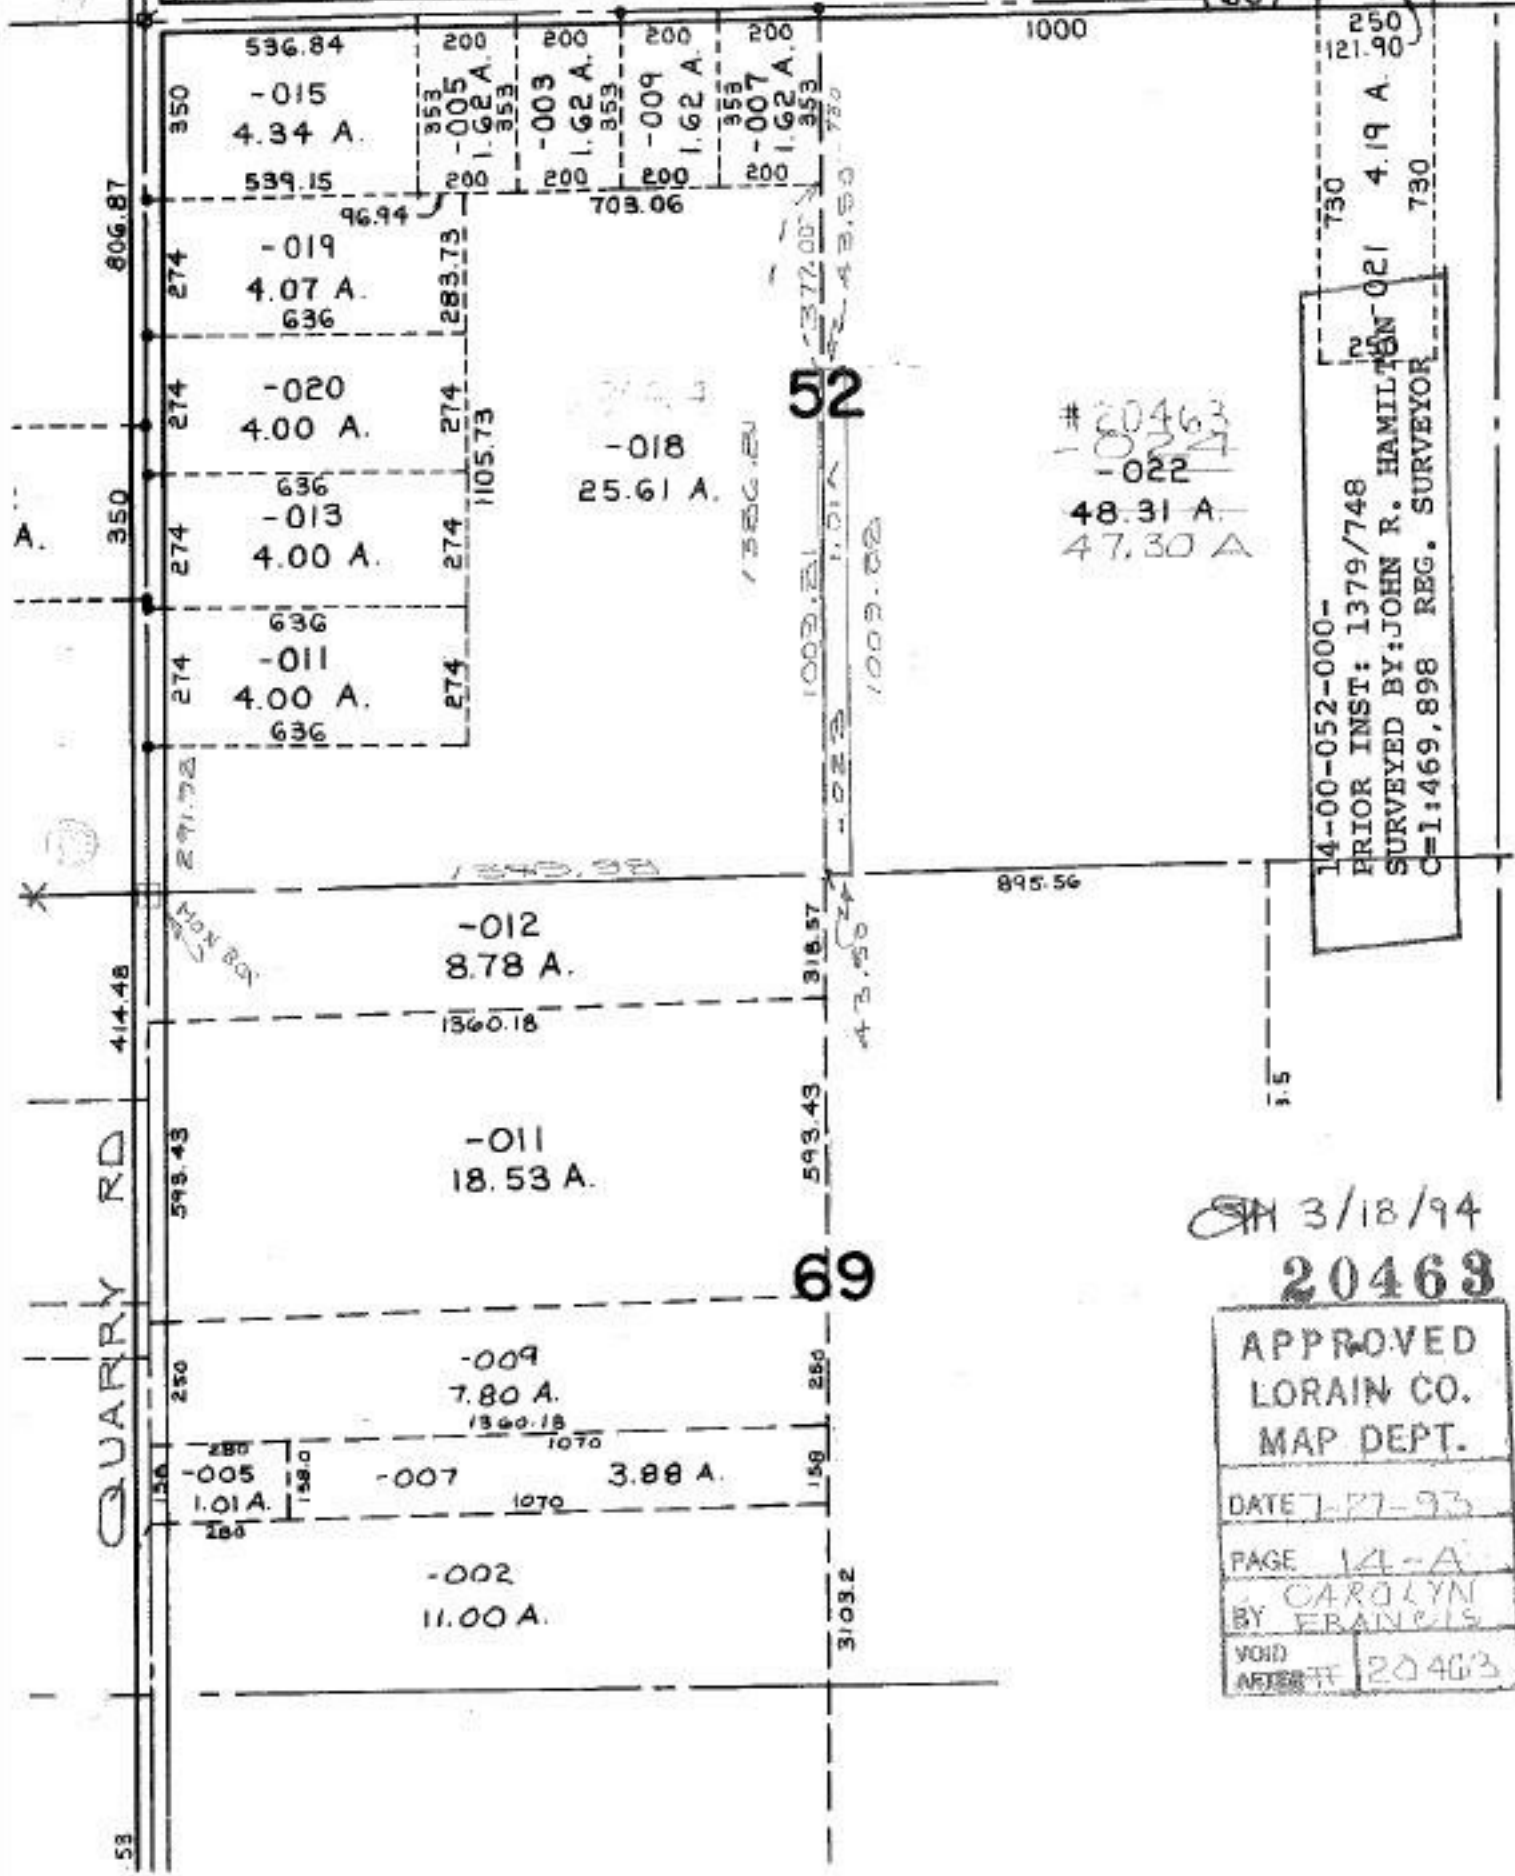

A.

52

#20463
-022
48.31 A.
47.30 A

14-00-052-000-
PRIOR INST: 1379/748
SURVEYED BY: JOHN R. HAMILTON 021
REG. SURVEYOR
C-1:469,898

3/18/94
20463

APPROVED
LORAIN CO.
MAP DEPT.
DATE 7-27-93
PAGE 14-A
BY CAROLYN
FRANCIS
VOID
AFTER 20463