


2

#045  
-039  
15.36 A.  
14.90 A.

USED OLD CENTERLINE OF  
STATE RT. 611

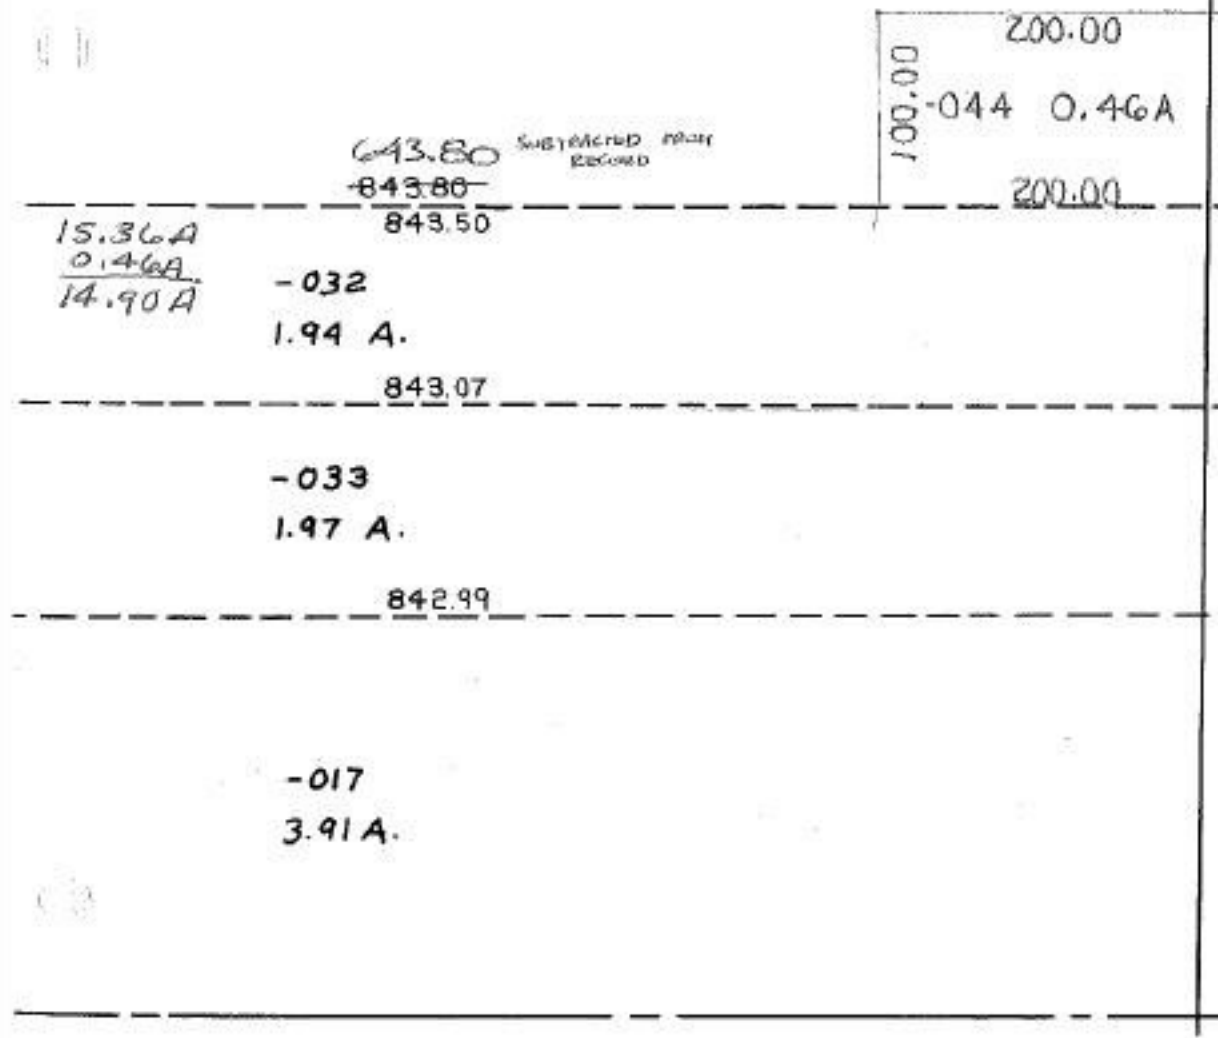

501

690.71  
790.71

1290.71 -  
TO OLD CENTERLINE  
OF ST. RT. 611

ABBE

03-00-017-102- PRIOR INST: DV.1359/812  
SURVEYED BY: KS ASSOC. C=1: INF.



500.00

1/20/94  
20470

APPROVED
LORAIN CO.
MAP DEPT.
DATE 7-28-93
PAGE 3-00-017B
BY CAROLYN
FRANCIS
VOID AFTER # 20470