


BUTTERNUT PARK ST.

100 100 100 140.08 377.04 631.60
RNUT PARK 298.40 1780.68
TE PASSED 1/24/89 1267.12 410.04

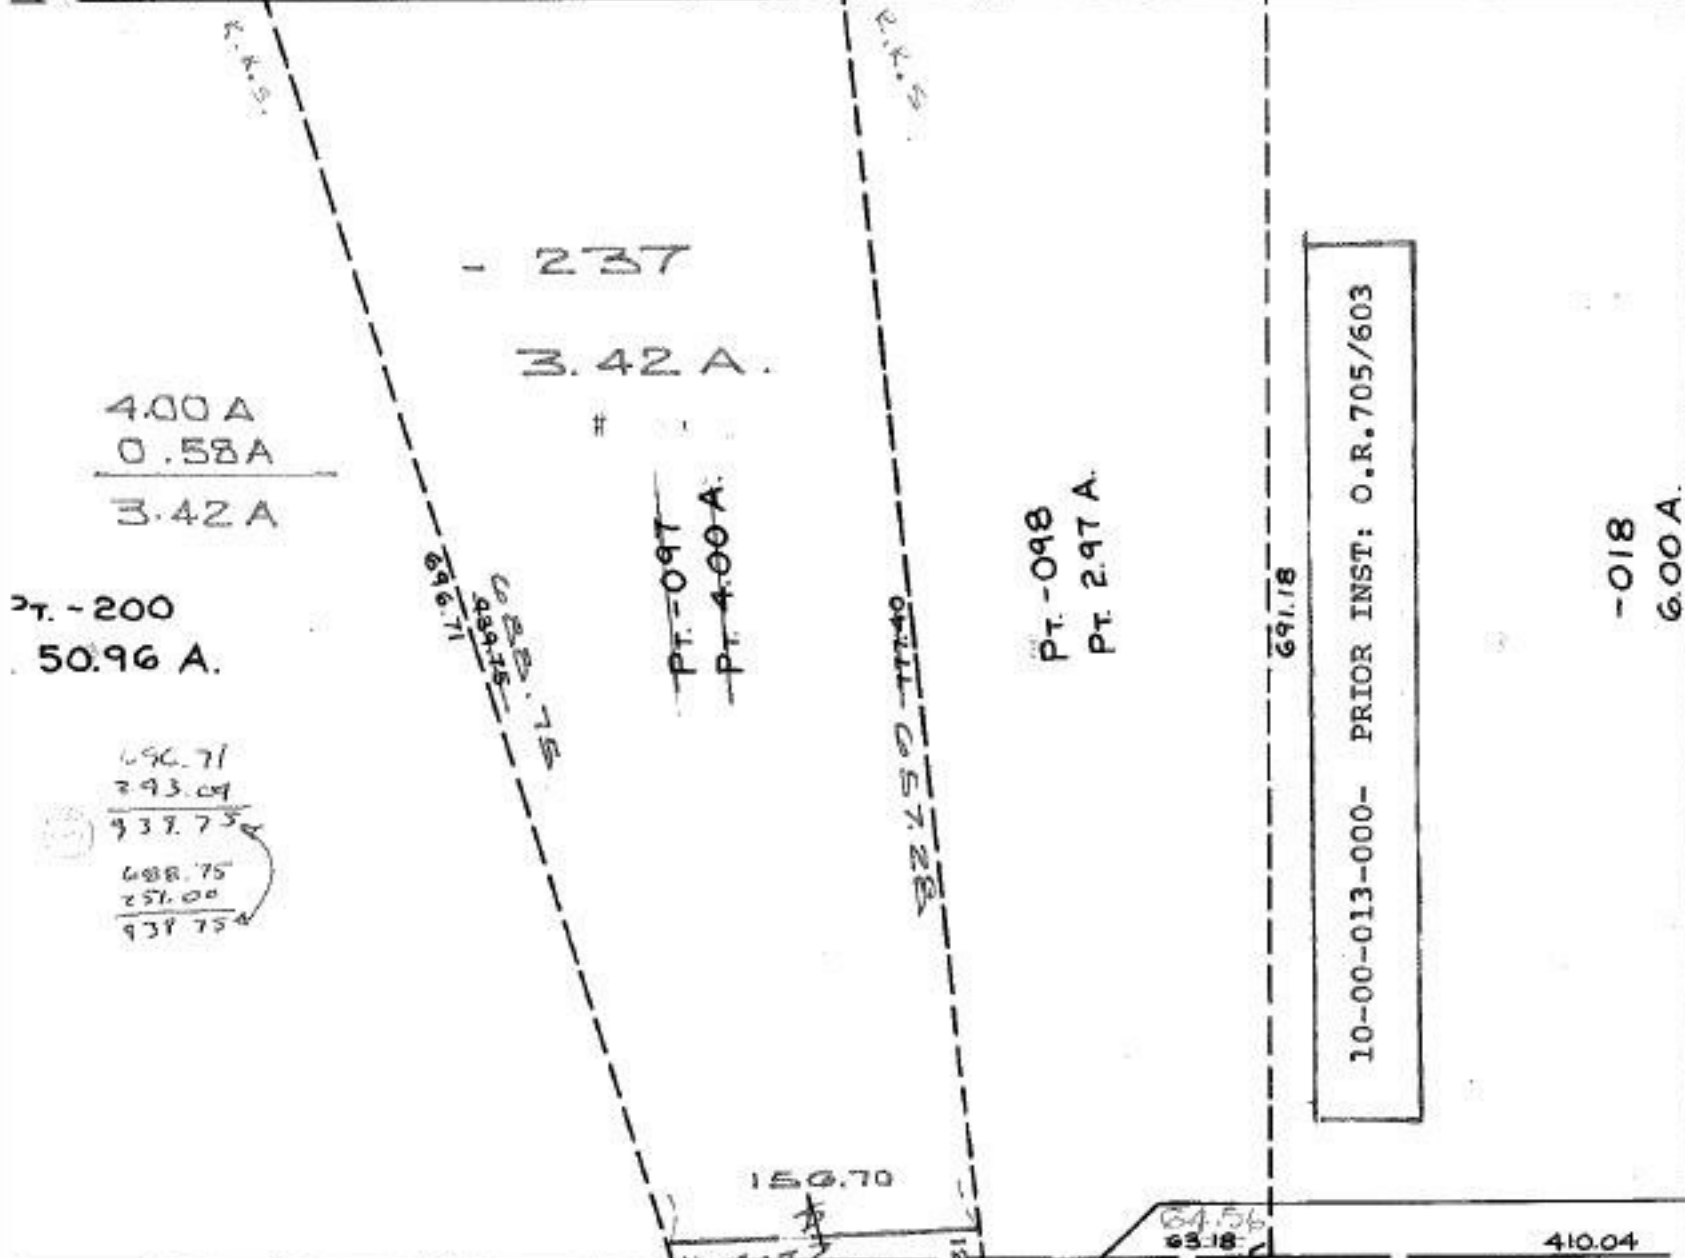


4.00 A
0.58 A
3.42 A
PT. - 200
50.96 A.

696.71
293.04
939.75
688.75
251.00
939.75

SEE 10-00-013-F
NICKLE-PLATE
DIAGONAL

3/2/94

20472
APPROVED
LORAIN CO.
MAP DEPT.
DATE 8-3-93
PAGE 10-00-013-B
BY CAROLYN FRANCIS
VOID AFTER # 20472

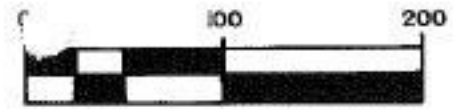

ADI ICI E TWD