


5.22 A.
 0.17 A.
 5.05 A.

COOPER-FOSTER-PARK
 RD.

IRON ROD IN
 MON. BOX

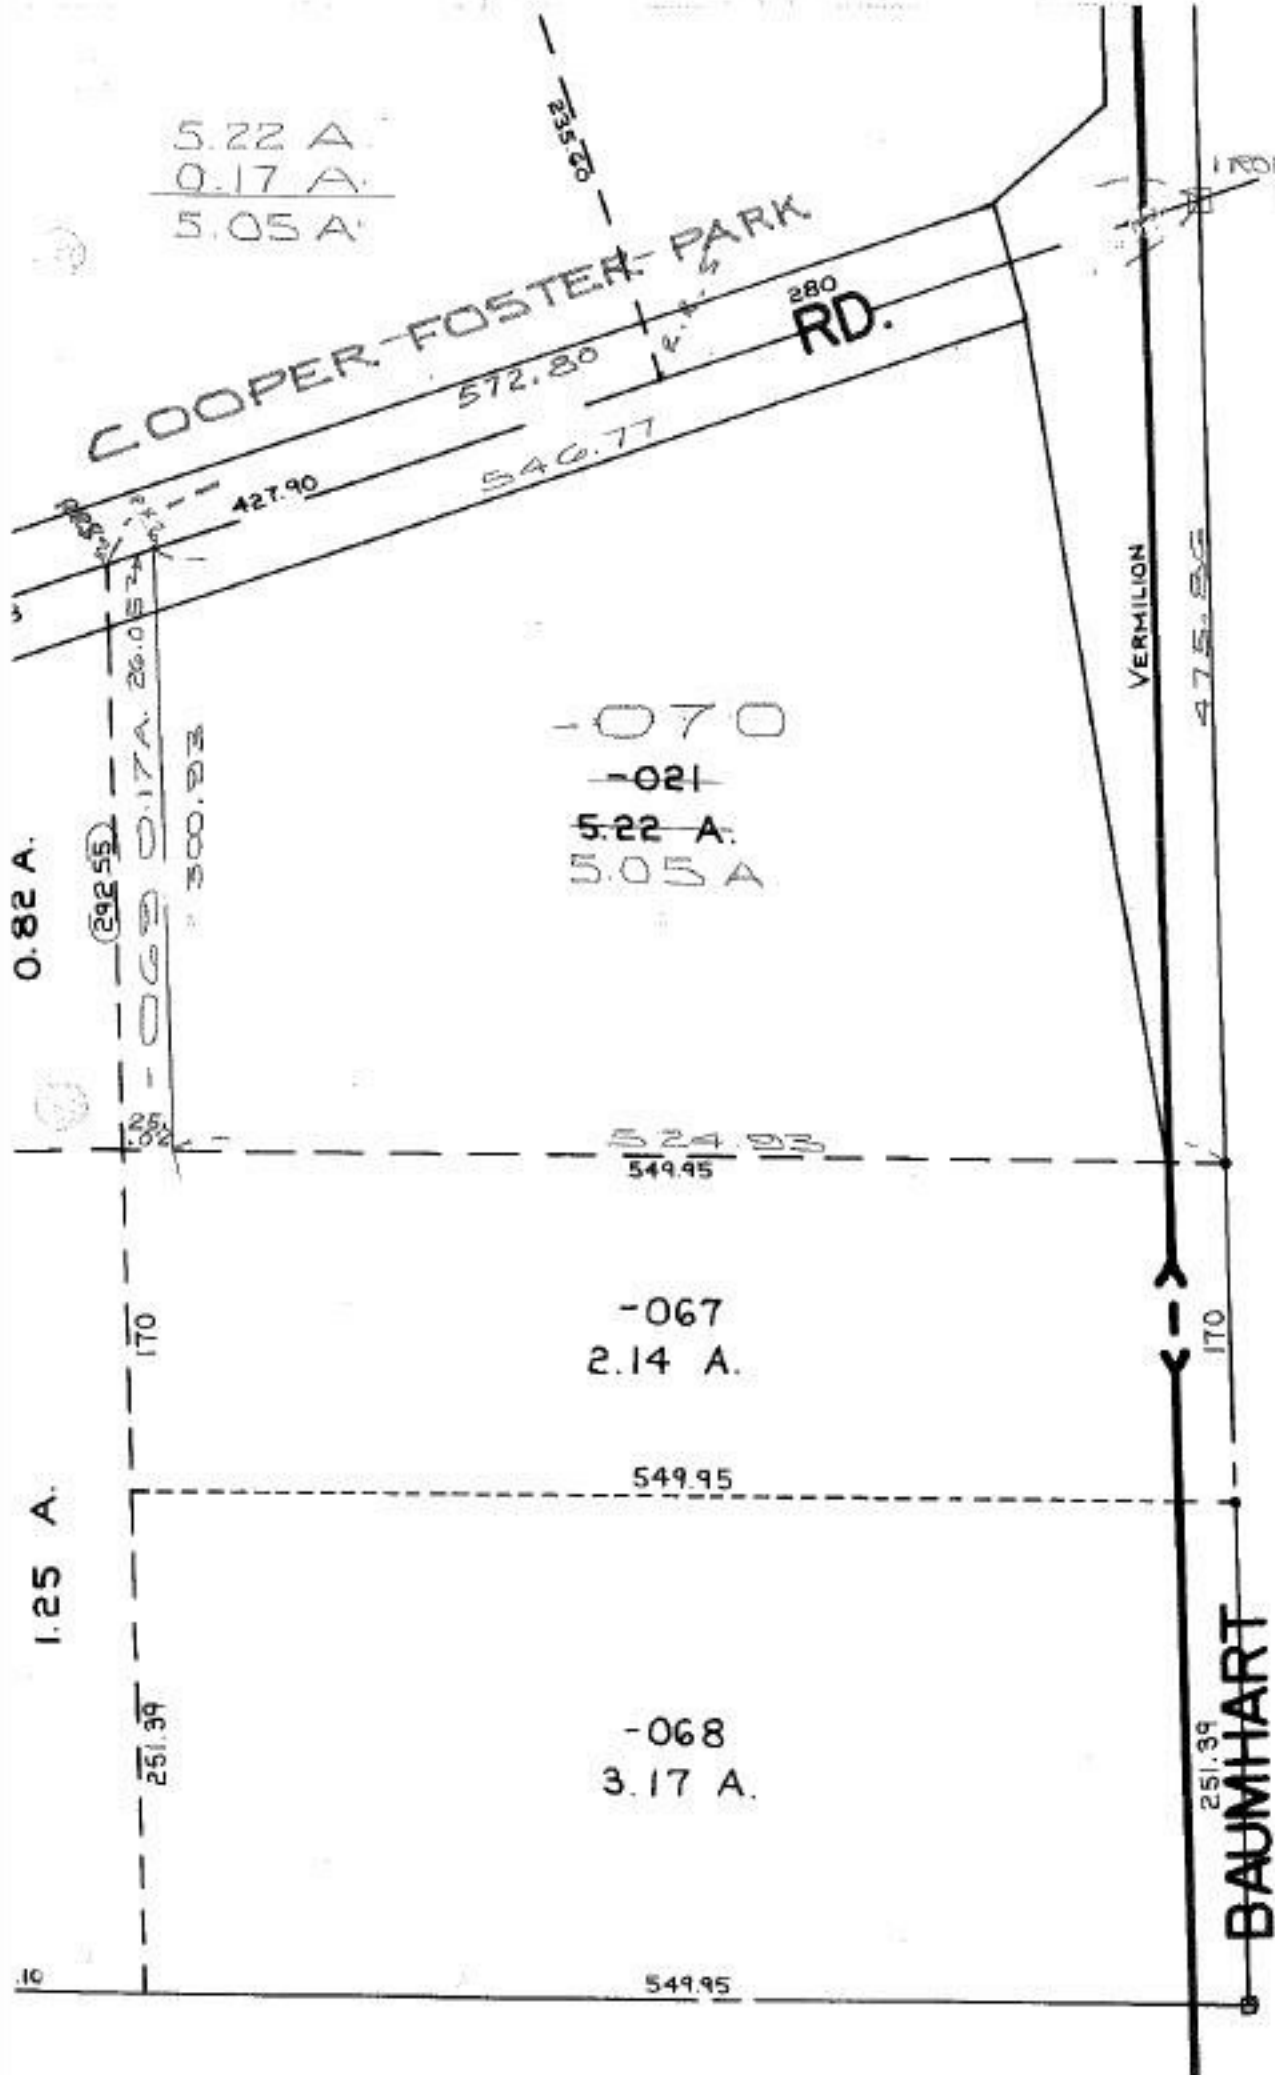

01-00-027-000- PRIOR INST: O.R. 565/541
 SURVEYED BY: CHARLES P. WARYU
 C=1:203,652 REG. SURVEYOR

10/22/93
 20474

APPROVED LORAIN CO. MAP DEPT.	
DATE	5-23
PAGE	1-00-027-B
BY	CAROLYN FRANKS
YOUR ORDER #	20474

0.82 A.

1.25 A.

-070
 -021
 5.22 A.
 5.05 A.

-067
 2.14 A.

-068
 3.17 A.

251.39
 BAUMHART