


SEE I-00-030-B

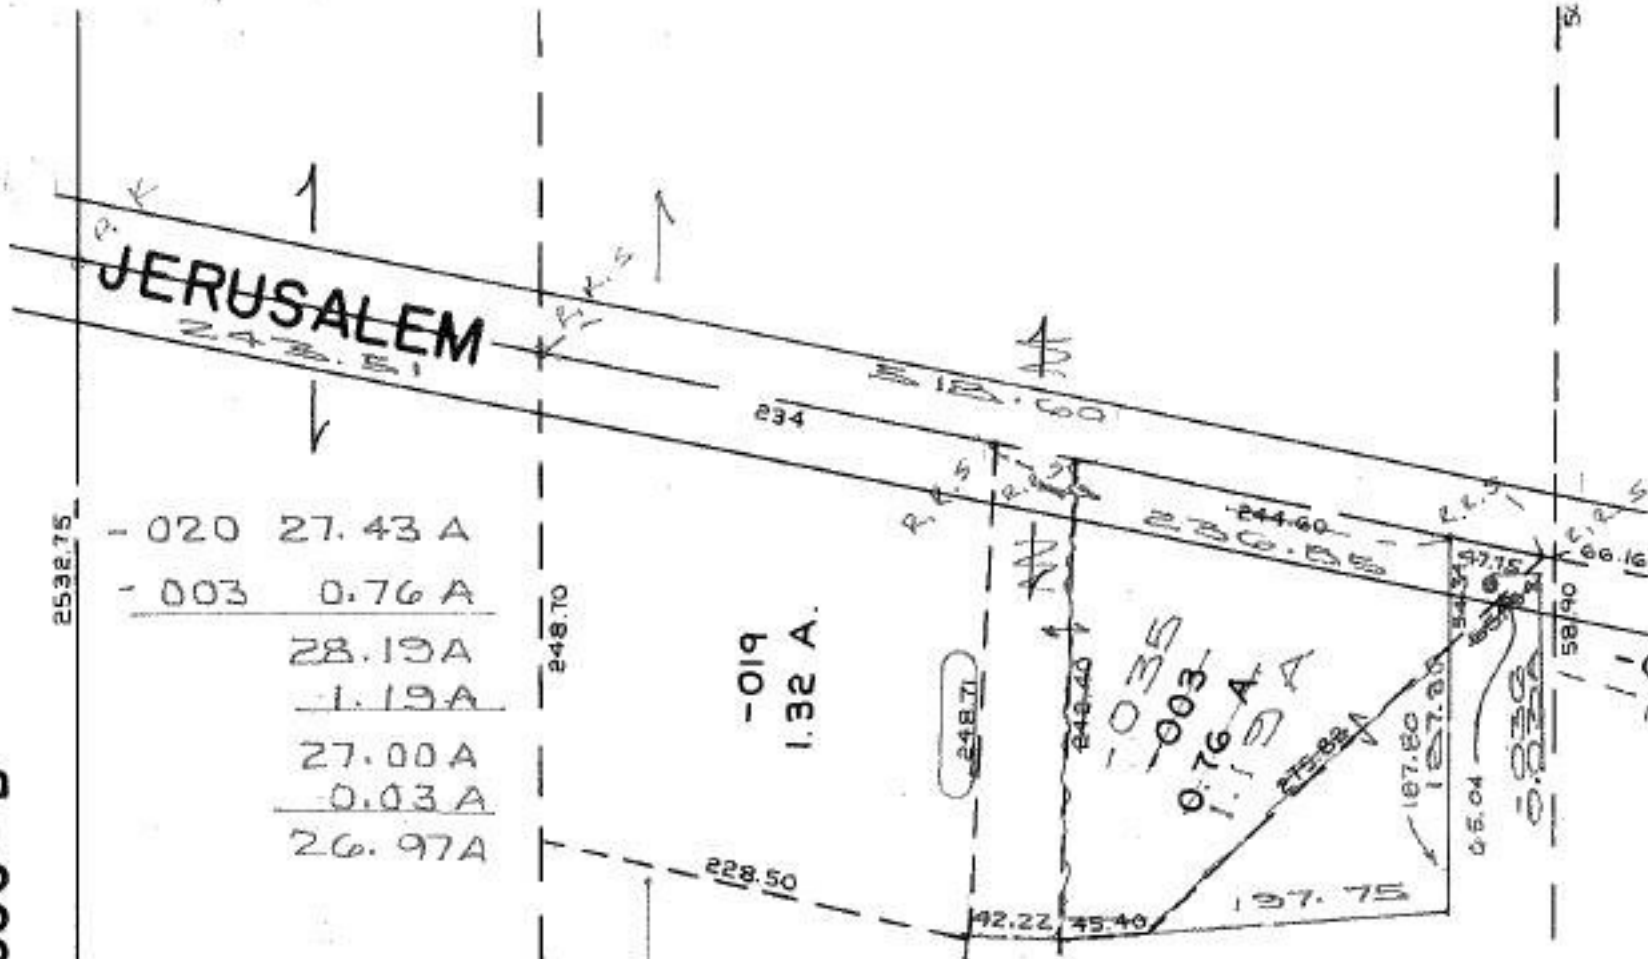

01-00-029-000-  
 PRIOR INST: DV.1374/277  
 SURVEYED BY:  
 CHARLES P. WARYU REG. SURV.  
 1.19 ac. C=1:35,937  
 0.03 ac. C=1:52,094

9/23/93  
 20477

APPROVED  
 LORAIN CO.  
 MAP DEPT.  
 DATE 8-10-93  
 PAGE 00-029-A  
 CAROLYN  
 BY FRANCIS  
 VOID # 20477

-037  
~~-020~~  
 27.43 A.  
 26.97 A.