


LAKE-CLEVELAND-SANDUSKY  
AKA LIBERTY AVE RD.

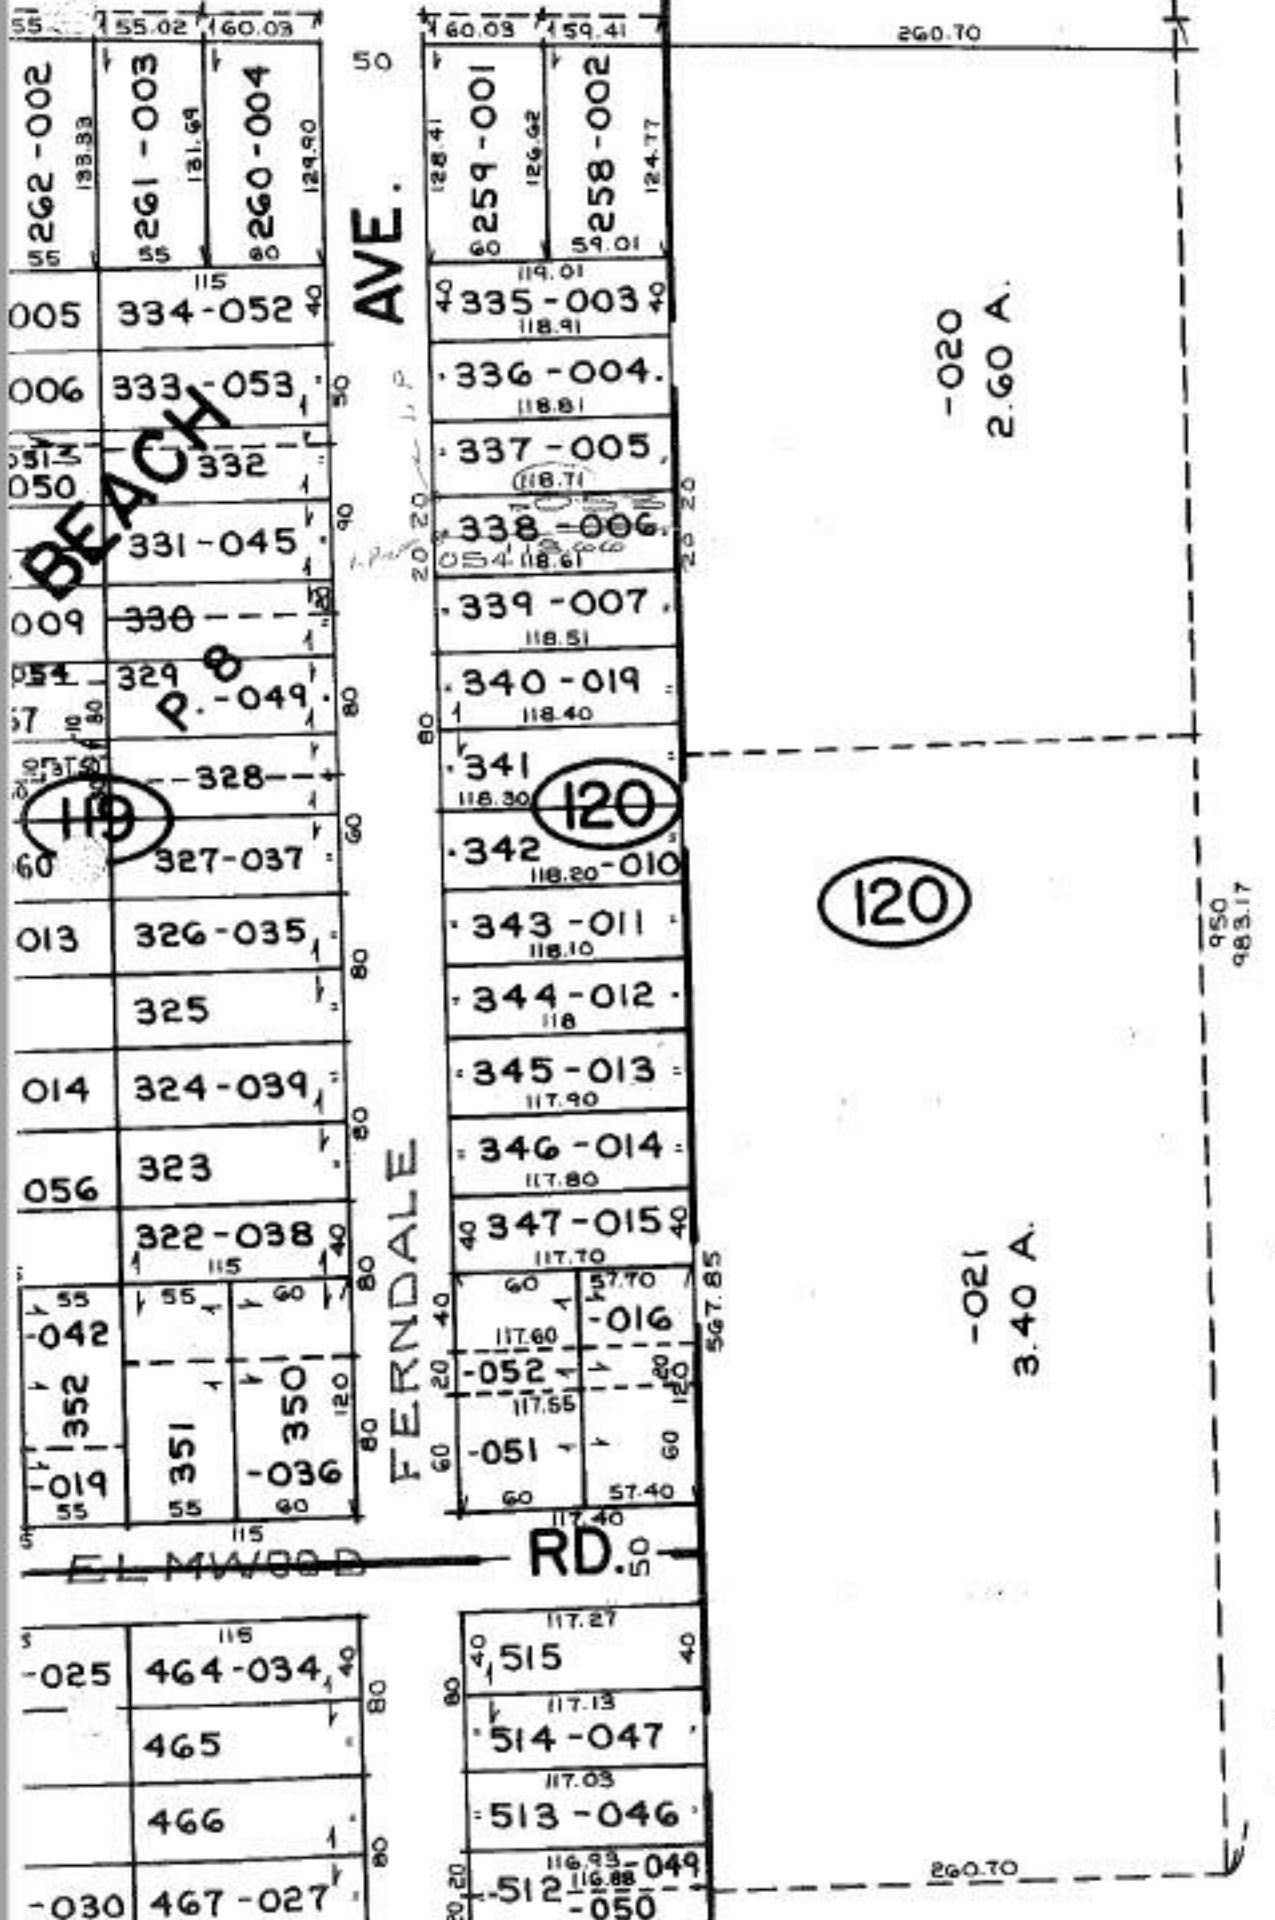

01-00-004-120- PRIOR INST: 8/1416/792  
SURVEYED BY: MICHAEL G. HURA REG. SURVEYOR  
~~XXXXXXXXXX~~

9/23/93  
20478

APPROVED  
LORAIN CO.  
MAP DEPT.  
DATE: 8-26-93  
PAGE: 1-00-004-C  
CAROLYN  
BY FRANCIS  
VOID  
ORDER # 20478

-004-D