




183-000 TAX
MAP INFO

132
65.62
59.15
6.87
71.28
80.87
70.41
132.0
5.0

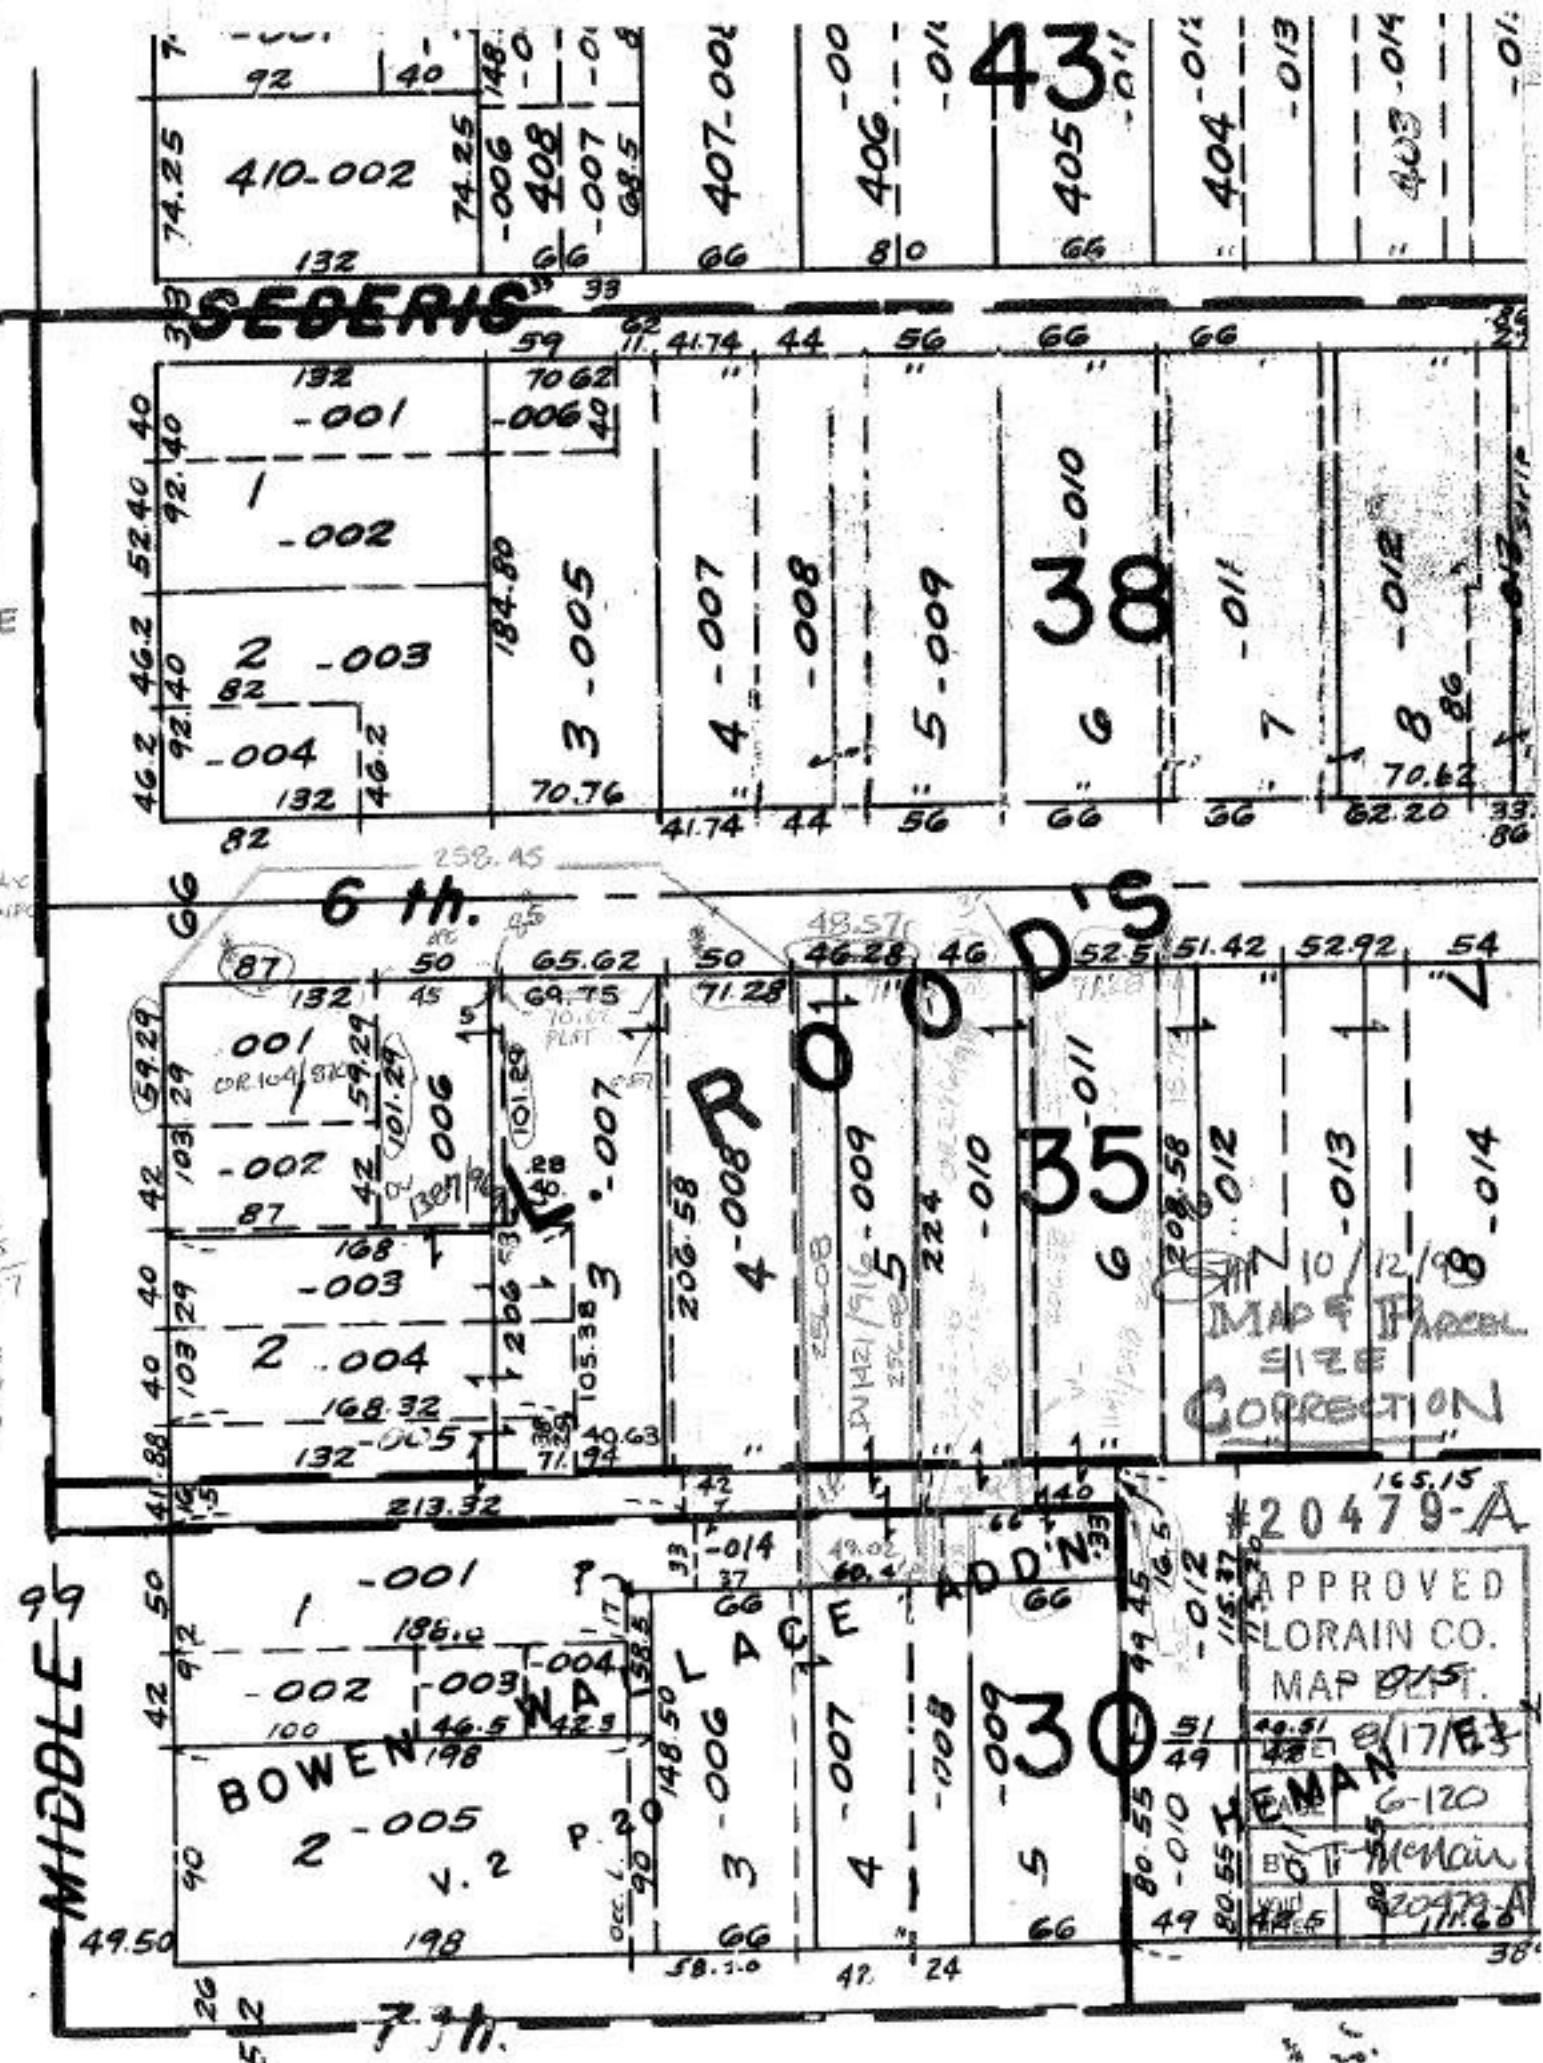

NOTE: MAP IS ENLARGED

#20479-A
APPROVED
LORAIN CO.
MAP 1925
EMAN
G-120
BY T. McMan
11.66