


DEED # 20484 A

- ② 16-00-001-101-003 28.55 a.
- ③ 16-00-002-101-001 15.42 a.
- ④ 16-00-002-101-002 1.62 ac
- ⑤ 16-00-002-101-003 13.27 a.
- ⑥ 16-00-019-101-001 1.5 ac
- 16-00-001-101-002 1.50

* POSITION ONLY

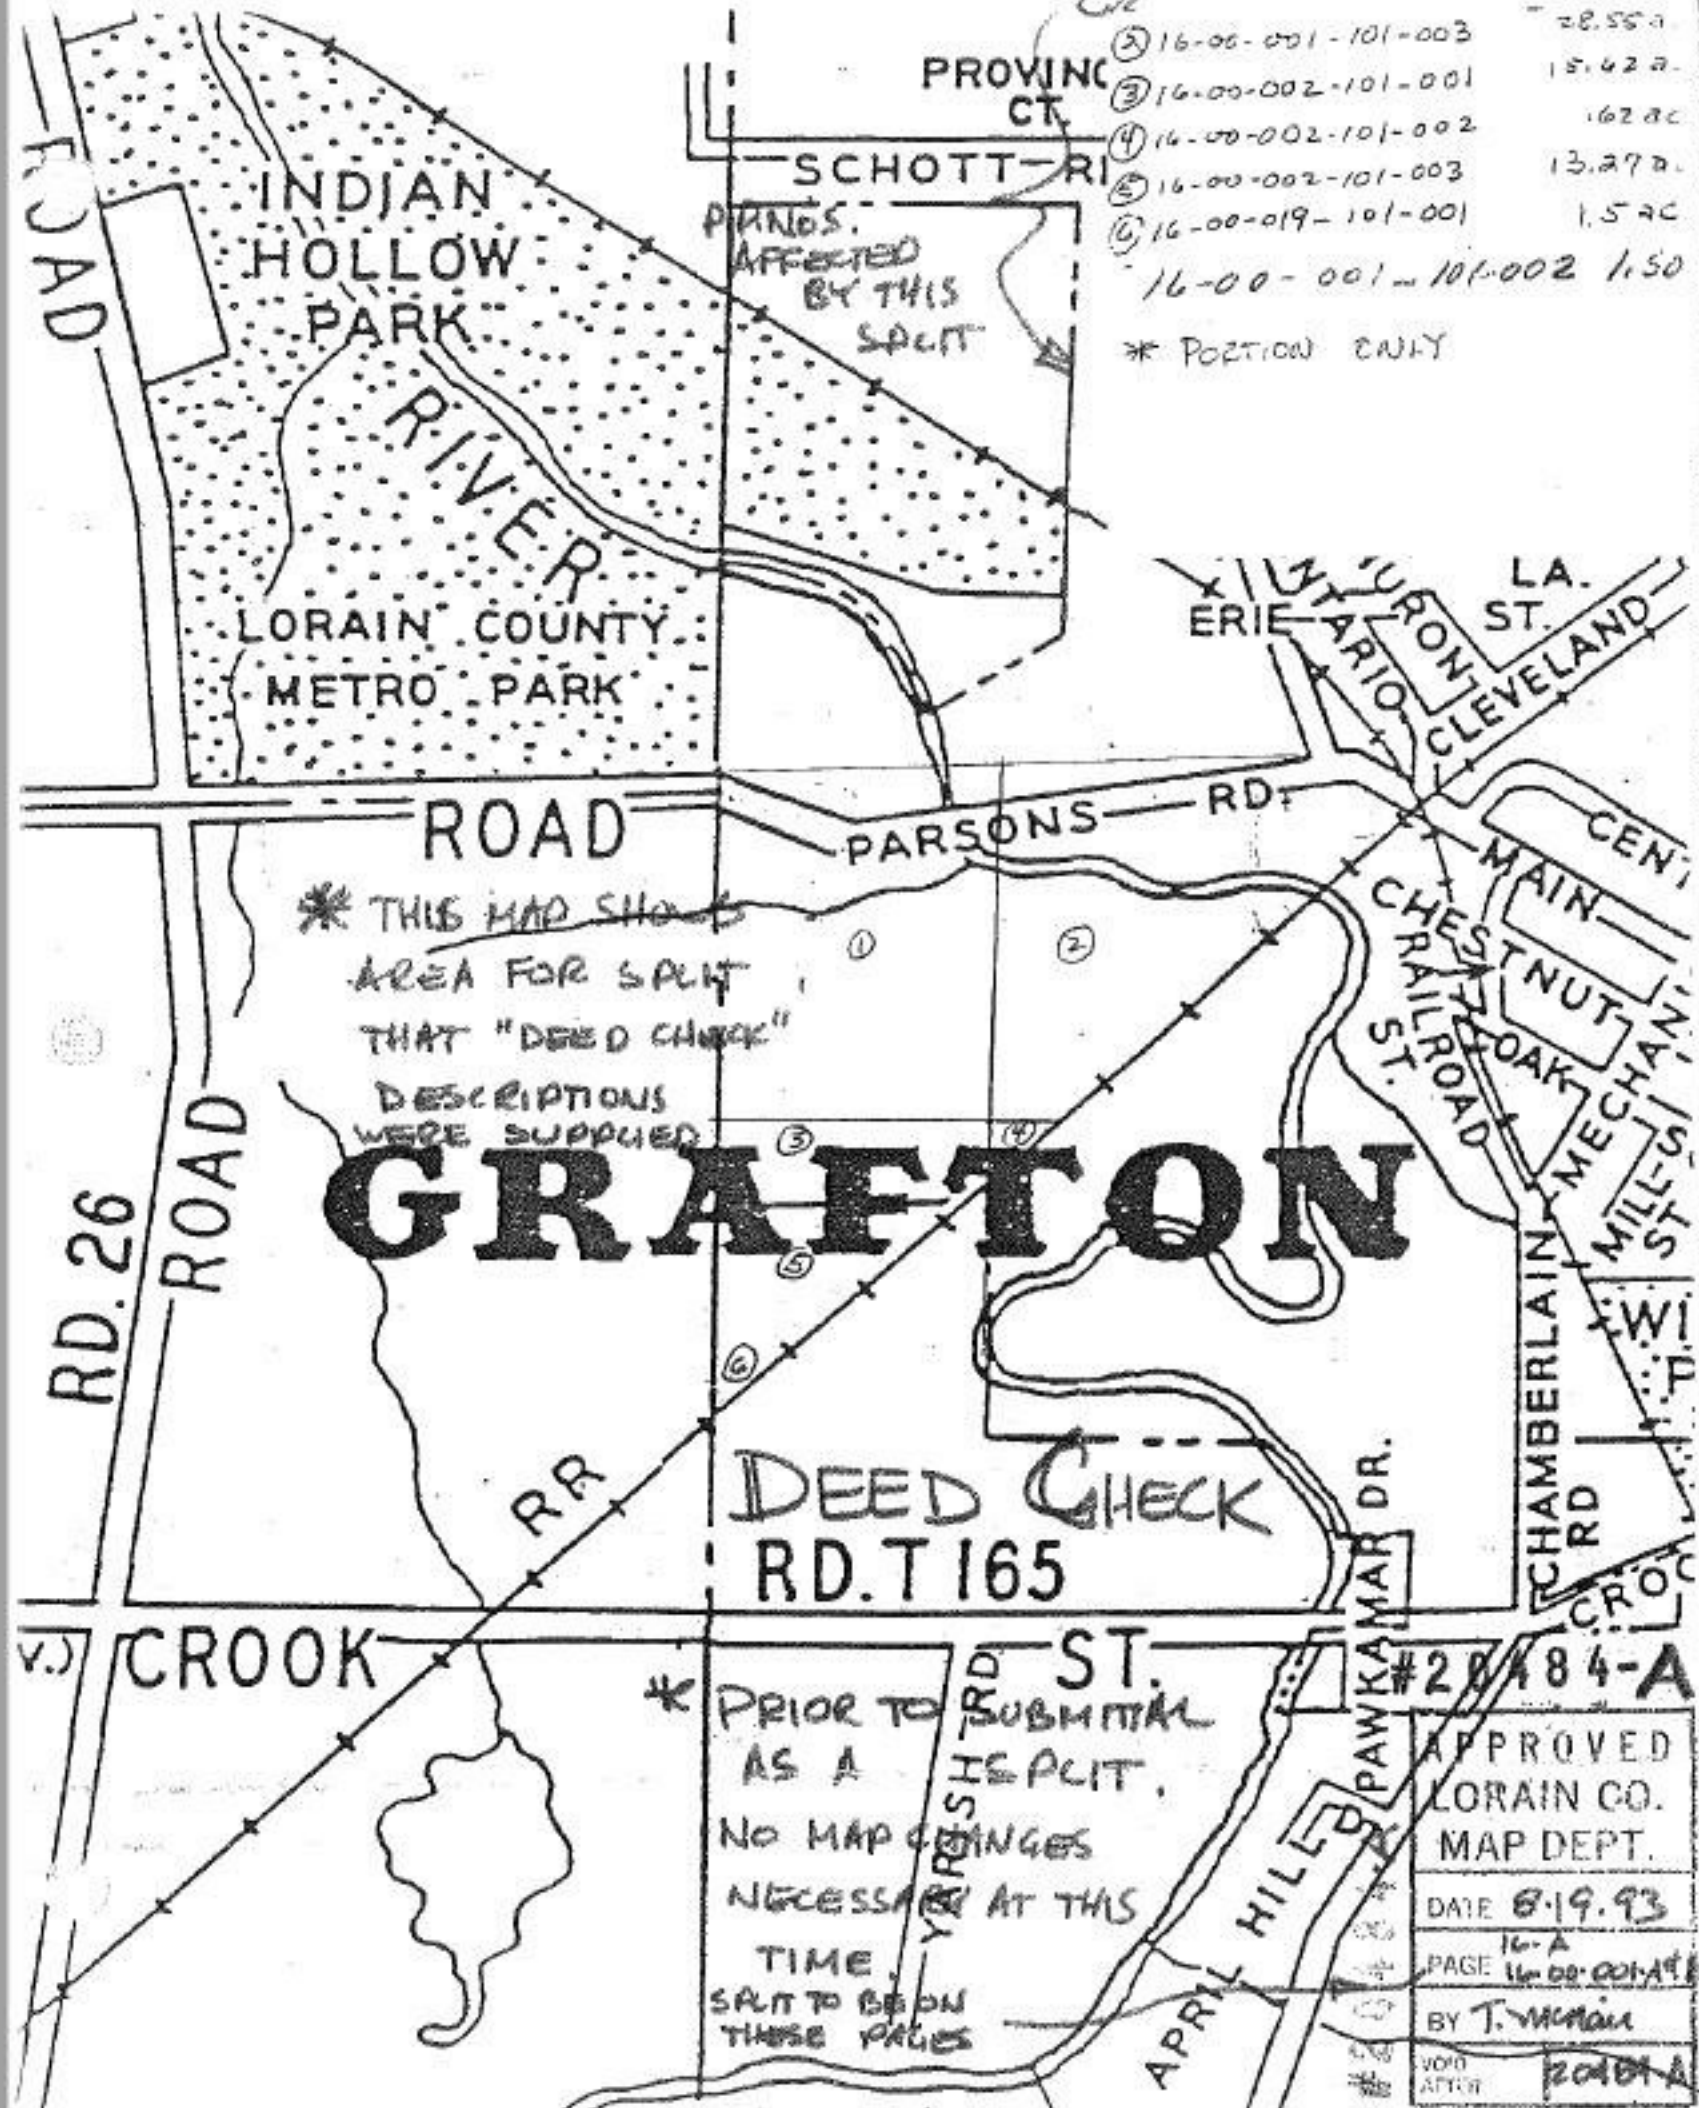

* THIS MAP SHOWS
 AREA FOR SPLIT
 THAT "DEED CHECK"
 DESCRIPTIONS
 WERE SUPPLIED

GRAFTON

DEED CHECK
 RD. T 165

* PRIOR TO SUBMITTAL
 AS A SPLIT,
 NO MAP CHANGES
 NECESSARY AT THIS
 TIME.
 SPLIT TO BE ON
 THESE PAGES

20484-A

APPROVED
LORAIN CO.
MAP DEPT.
DATE 8-19-93
PAGE 16-A
BY T. McMan
VOID AFTER 20484-A