


078-B

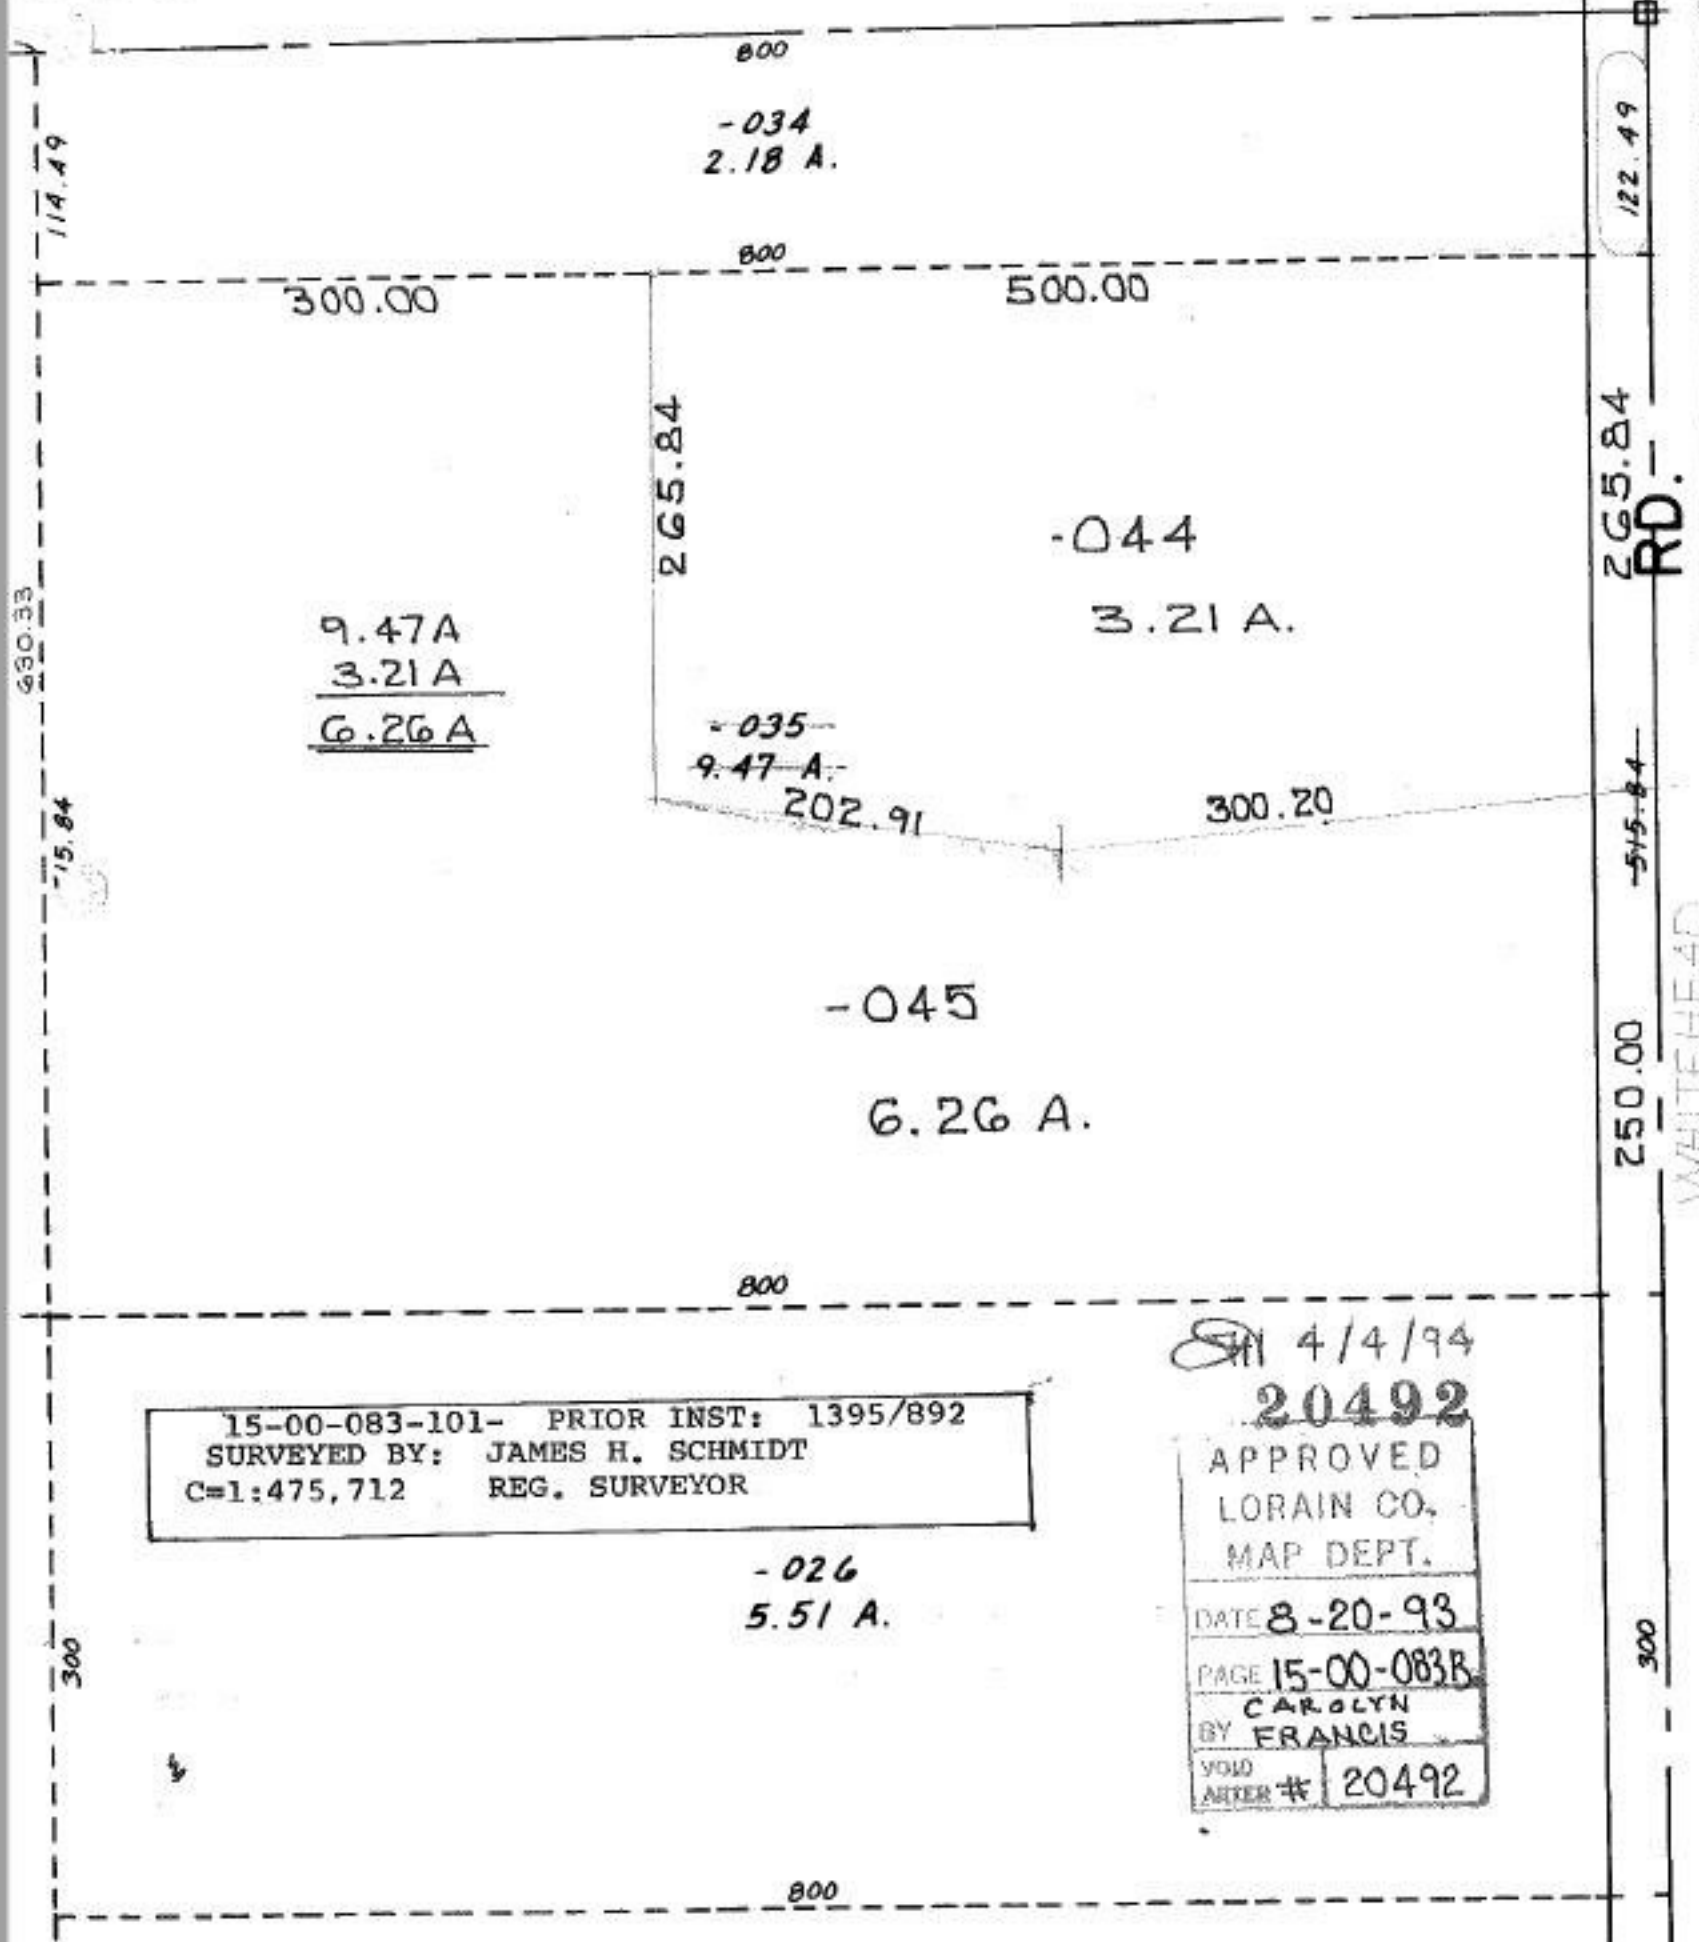

15-00-083-101- PRIOR INST: 1395/892  
 SURVEYED BY: JAMES H. SCHMIDT  
 C=1:475,712 REG. SURVEYOR

4/4/94  
 20492  
 APPROVED  
 LORAIN CO.  
 MAP DEPT.  
 DATE 8-20-93  
 PAGE 15-00-083B  
 BY CAROLYN  
 FRANCIS  
 VOID  
 AFTER # 20492

WHITEHEAD