


S 87° 52' 18" E

SEE 3-

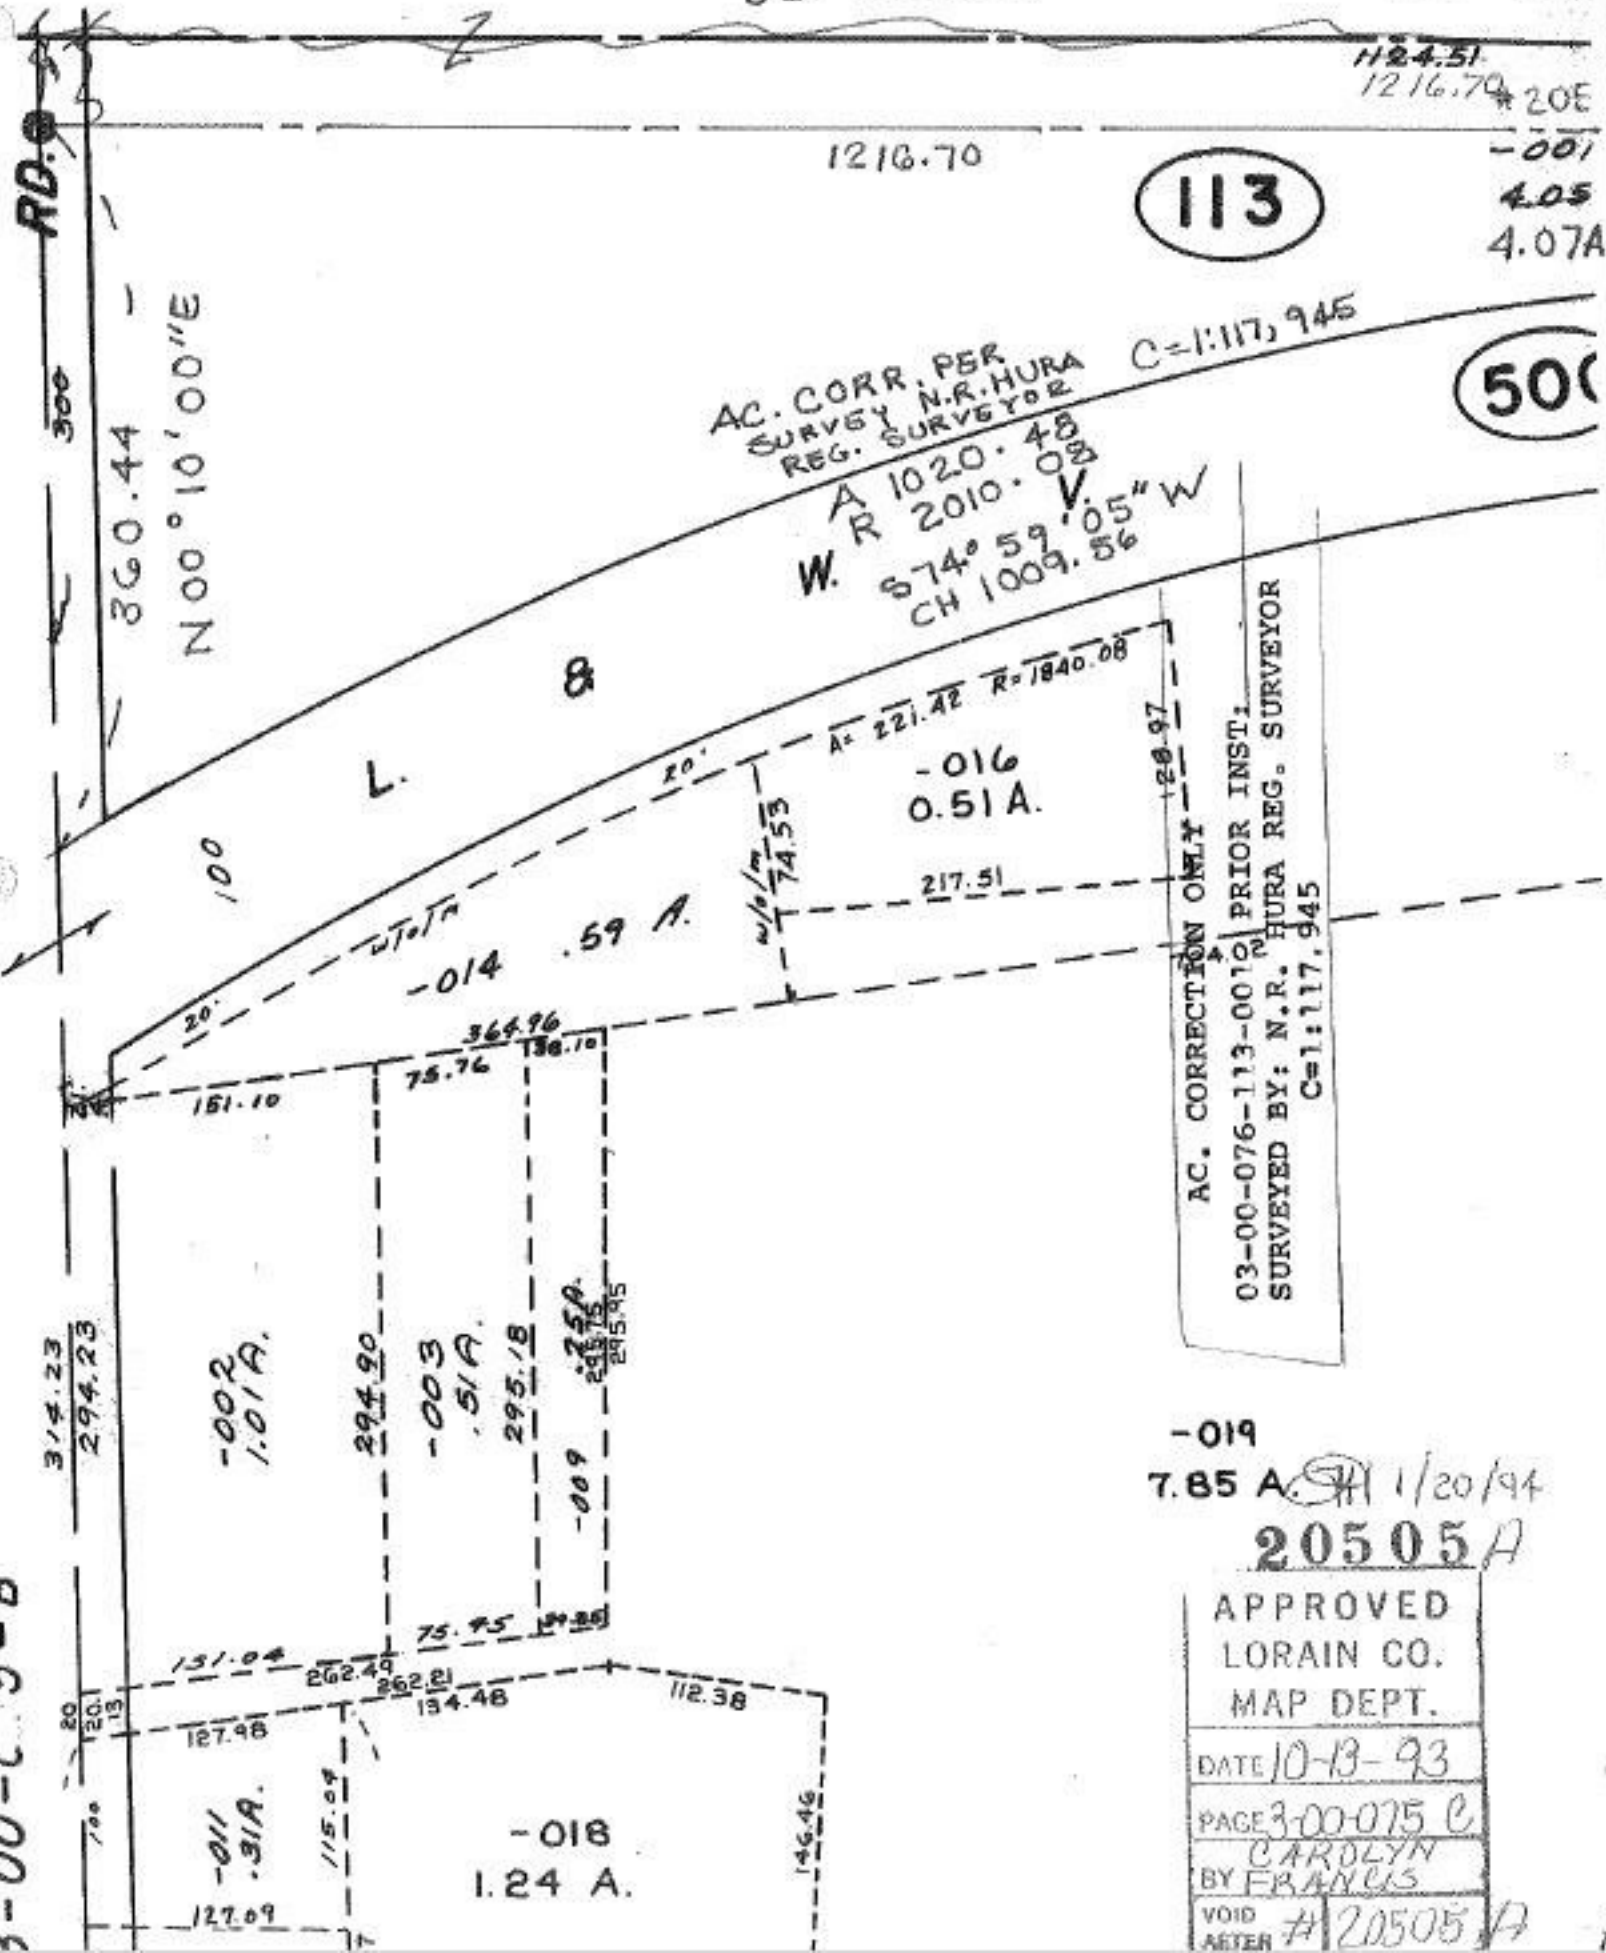

1124.51
1216.70

1216.70

113

-001
4.05
4.07A

AC. CORR. PER
SURVEY N.R. HURA
REG. SURVEYOR

C=1:117,945

500

A 1020.48
W. R 2010.08
S 74° 59' 05" W
CH 1009.56

AC. CORRECTION ONLY
03-00-076-113-0010 PRIOR INST.
SURVEYED BY: N.R. HURA REG. SURVEYOR
C=1:117,945

-016
0.51 A.

-014 .59 A.

-002
1.01 A.

-003
.51 A.

-009
2.50 A.

-019
7.85 A. 1/20/94
20505 A

APPROVED
LORAIN CO.
MAP DEPT.

DATE 10-13-93

PAGE 3-00-075 C

CAROLYN
BY FRANCIS

VOID
METER # 20505 A

-018
1.24 A.

3-00-L-15-B