


SEE 5-00-037-B

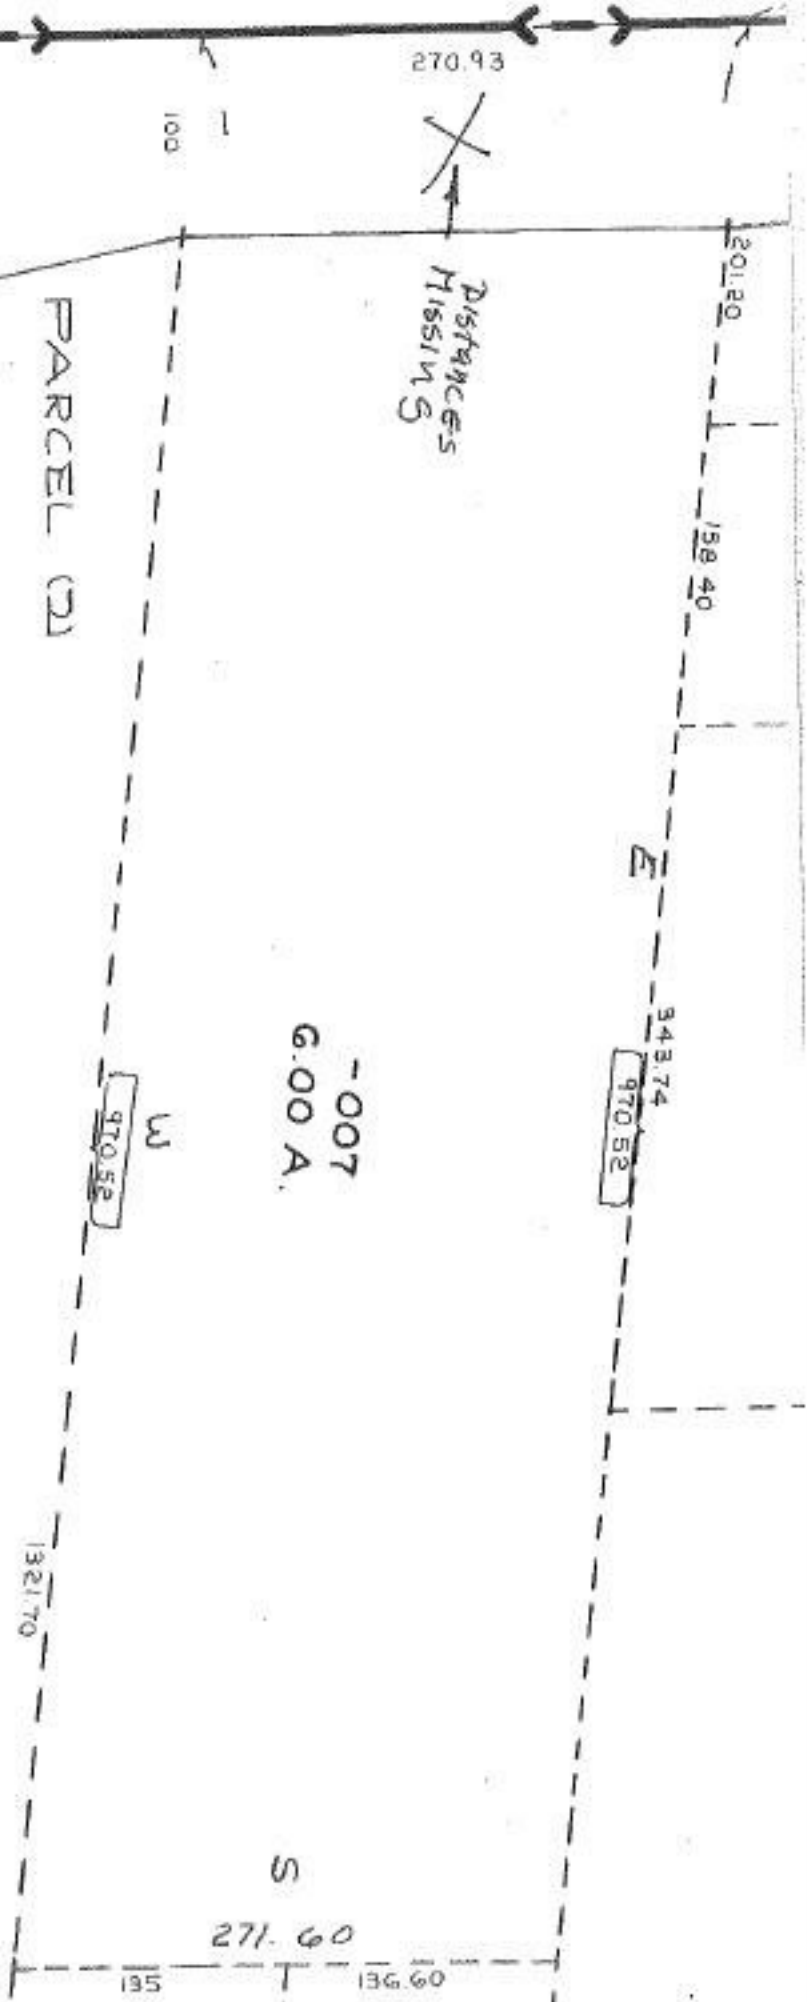

Distances Missing

-007
6.00 A.

PARCEL (2)

PLACE OF BEGINNING NEED MORE INFO
MUST HAVE DISTANCES ALL THE WAY
AROUND PARCEL.

05-00-044-000-001
REFERENCES IN R/W OF ST 58
IS IT BY EASMENT OR DEED ?

20507A

DEED CK.

APPROVED
LORAIN CO.
MAP DEPT.
DATE AUG 30 93
PAGE
BY CAROLYN FRANCIS
WORKS # 20507A