


-081
20.32 A.

NEED EXCEPTION FOR -070
NEED TO SHOW AMT DE AC
BEING CONVEY ~~50TH~~ PRIOR INST.
SHOULD BE ON THE OVERALL
DEED.

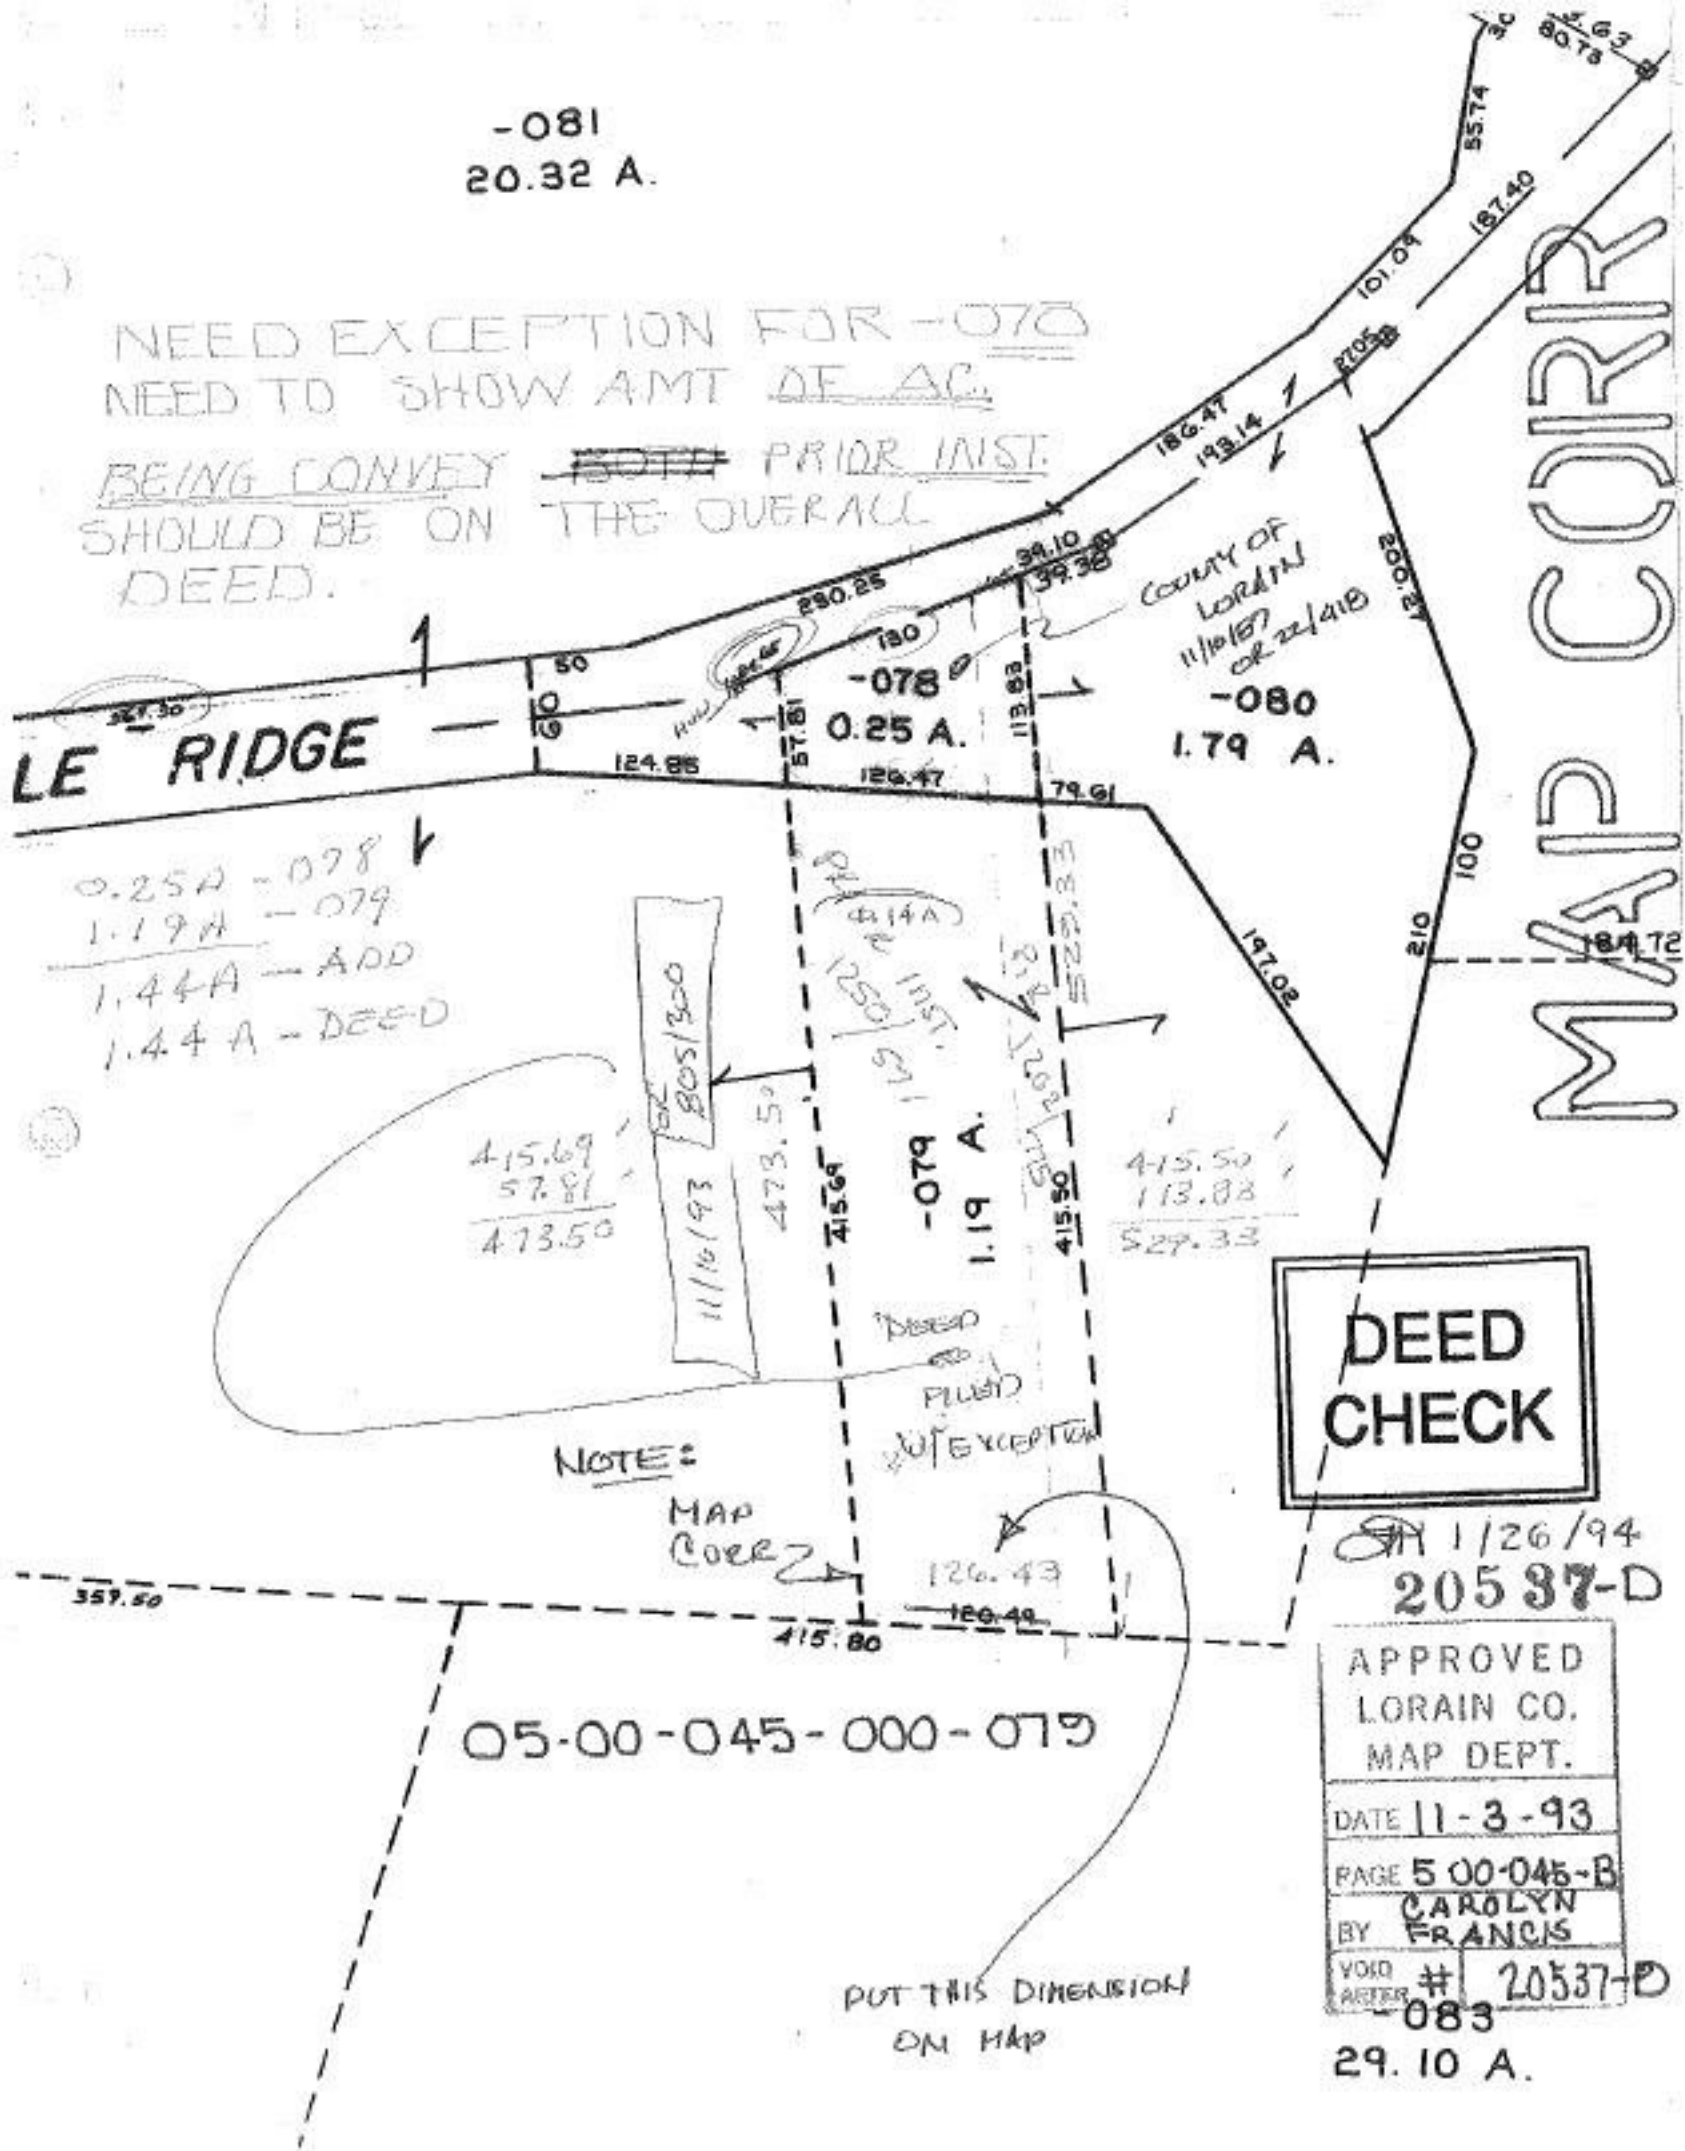

LE RIDGE

MAP CORR

0.25A - 078
1.19A - 079
1.44A - ADD
1.44A - DEED

415.69
57.81
473.50

11/16/93
805/300

DEED CHECK

1/26/94
20537-D

APPROVED
LORAIN CO.
MAP DEPT.

DATE 11-3-93

PAGE 5 00-045-B

BY CAROLYN FRANCIS

VOID AFTER # 20537-D

083
29.10 A.

05-00-045-000-079

PUT THIS DIMENSION ON MAP

NOTE:

MAP CORR

DEED PLUS EXCEPTION

COUNTY OF LORAIN
11/10/87
OR 22/418
-080
1.79 A.

-078
0.25 A.

-079
1.19 A.

357.50

415.80

126.43

126.49

124.88

57.81

126.47

79.61

197.02

210

100

184.72

290.25

39.10

39.38

113.88

200.27

186.47

143.14

101.04

187.40

55.74

4.63

80.78