


DETAIL-
NOT TO SCALE

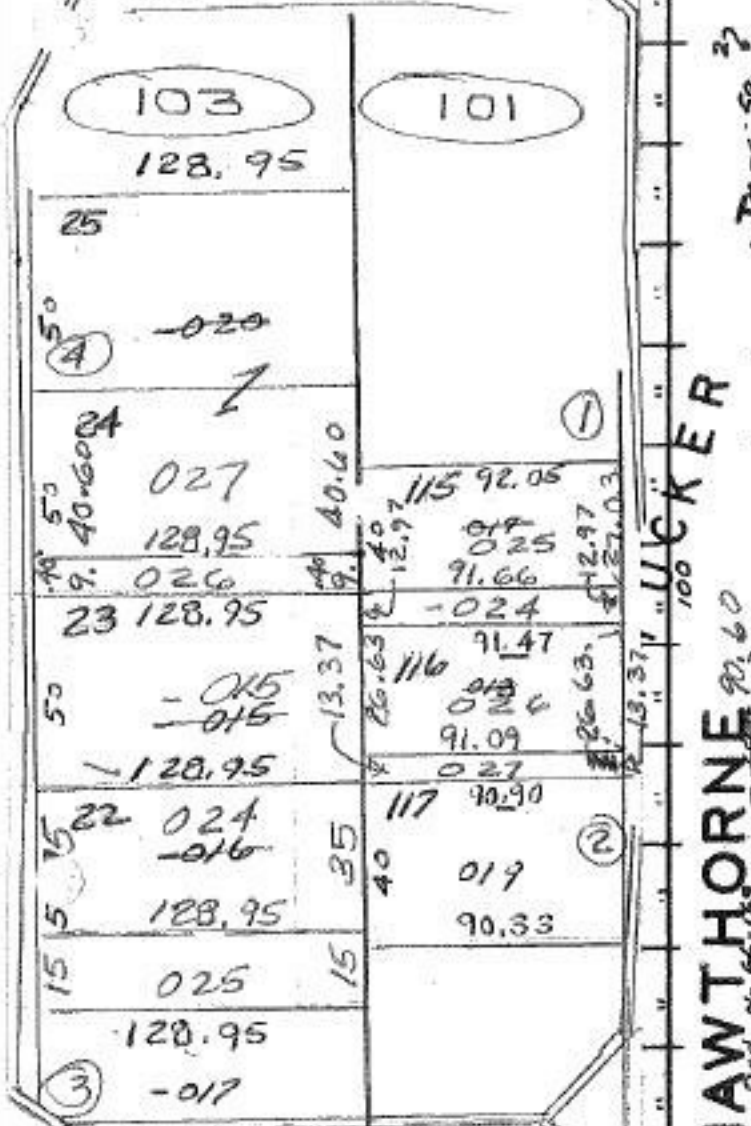

SPLIT OUT OF

Lot	Area	Sublot
①	12.97X 91.66	115
②	26.63X 91.47	116
③	35 X 128.95	22
④	9.40 X 128.95	24
①	REM 27.03X 92.05	115
②	REM 13.37 X 91.09	116
③	REM 15 X 128.95	22
④	REM 40.60 X 128.95	24

Lot	Area	Sublot
103	128.95	
101		
25		
24		
23	128.95	
22		
21		
Lot	Area	Sublot
103	128.95	
101		
25		
24		
23	128.95	
22		
21		
1/29/94
20537

APPROVED
LORAIN CO.
MAP DEPT.
DATE 10-1-93
PAGE 6-106
BY CAROLYN FRANCIS
YOUR ARTIST # 20537

500
06-25-012-101- 06-25-013-103-
PRIOR INST: O.R. 363/682
SURVEYED BY: KS ASSOC.
12.97X 91.66 C = 1.54 460 26.63X 91.47 C = 130.36
35X 128.95 AND 9.40X 128.95