


SEE 13-A

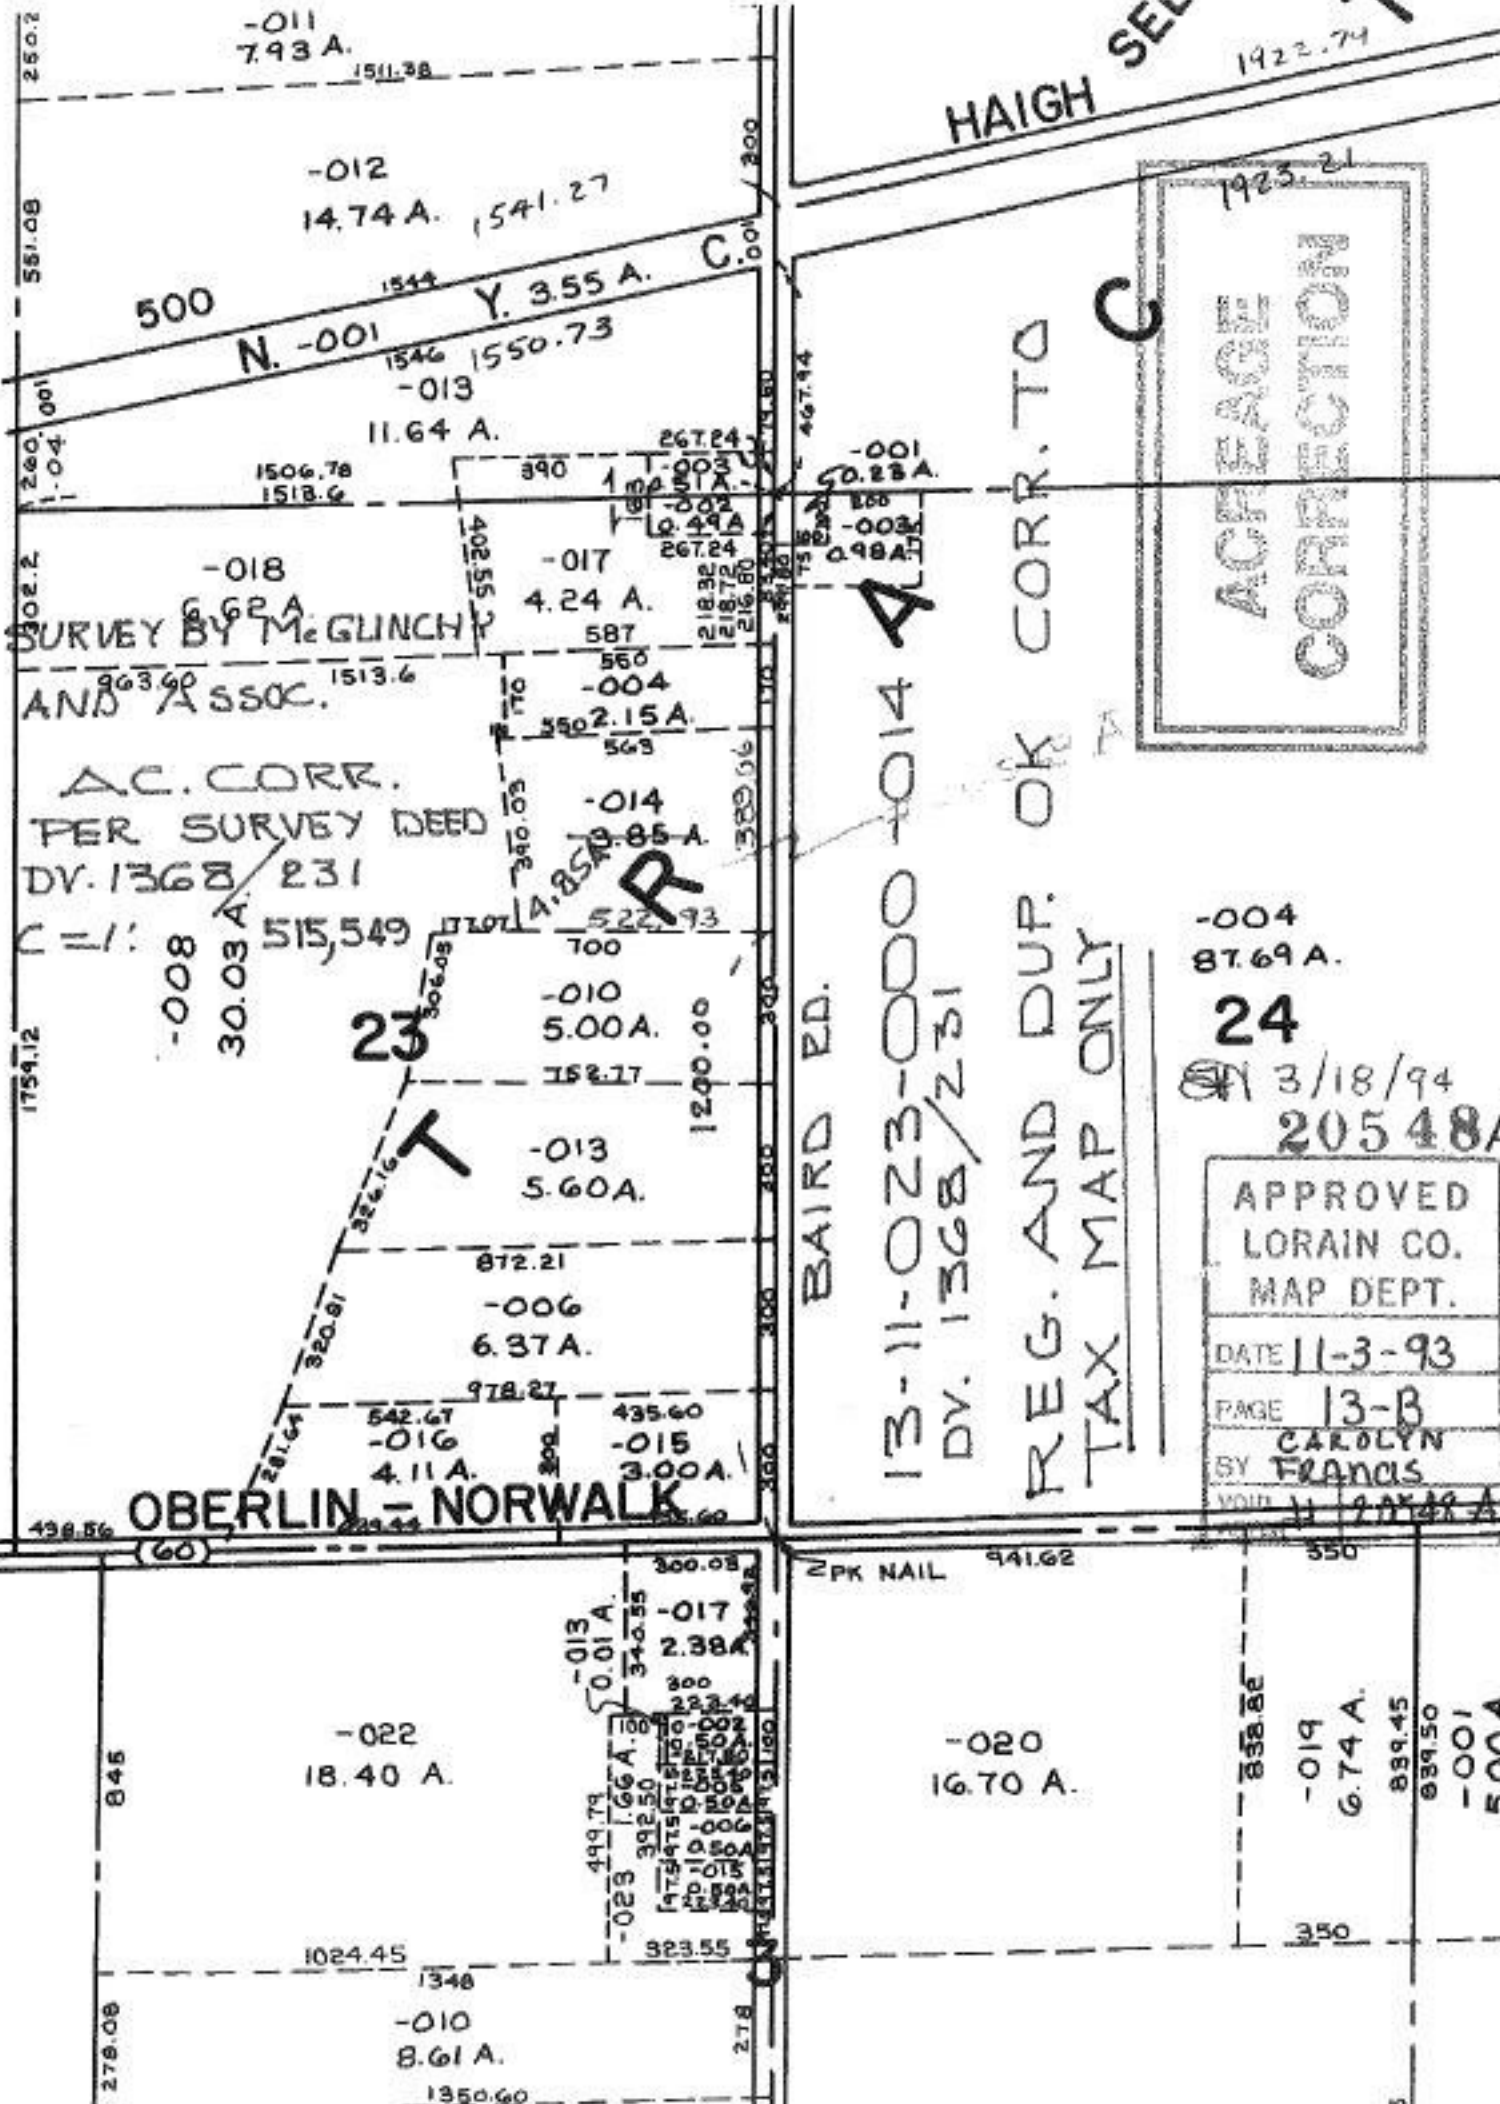

HAIGH SEL 1922.74

1923.21

ACREAGE CORRECTION

BAIRD RD.

13-11-023-000-014 A

DV. 1368/231

REG. AND DUP. OK CORR. TO TAX MAP ONLY

-004
87.69 A.

24

3/18/94

20548A

APPROVED
LORAIN CO.
MAP DEPT.

DATE 11-3-93

PAGE 13-B

BY CAROLYN FRANCIS

VOL 11 20548 A

20

845

278.08

1024.45

-022
18.40 A.

-010
8.61 A.

1350.60

-013
0.01 A.

-023
1.66 A.

-017
2.38 A.

-015
3.00 A.

-016
4.11 A.

300.08

340.55

300

392.50

300

323.55

300

300

300

ZPK NAIL 941.62

-020
16.70 A.

-019
6.74 A.

839.45

839.50

-001
5.00 A.

350

550