
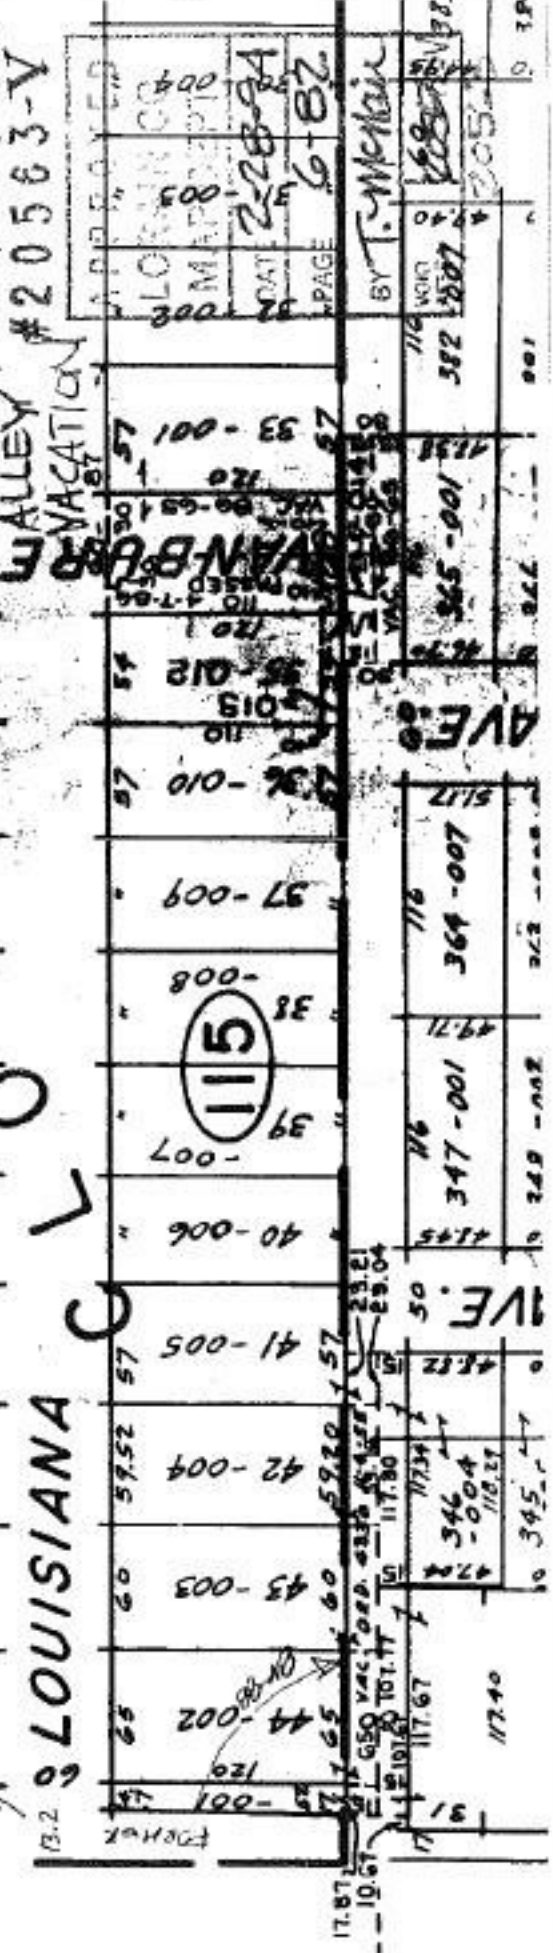
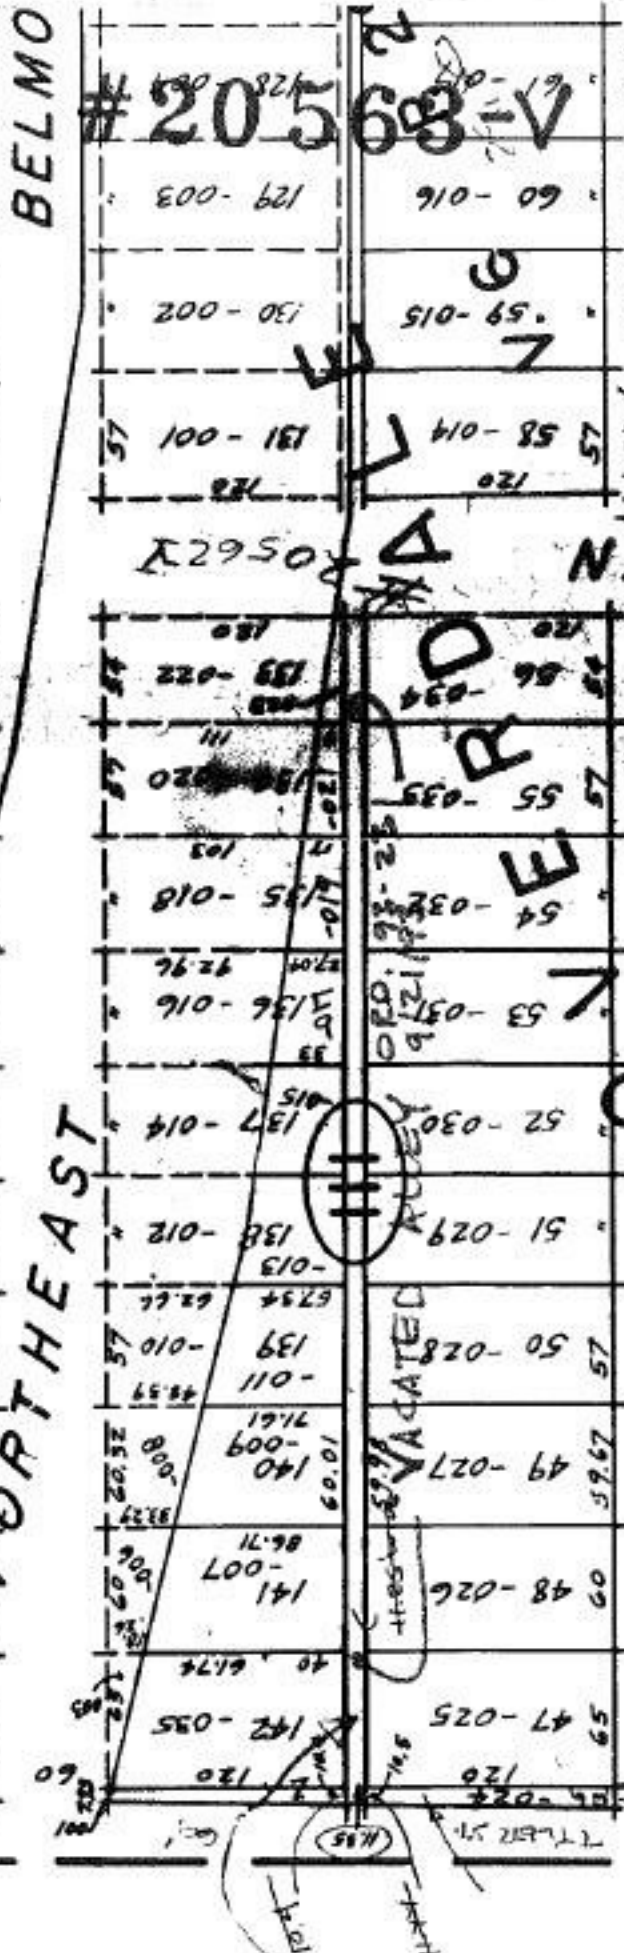


CA -003 #20522
86.1
198 A.

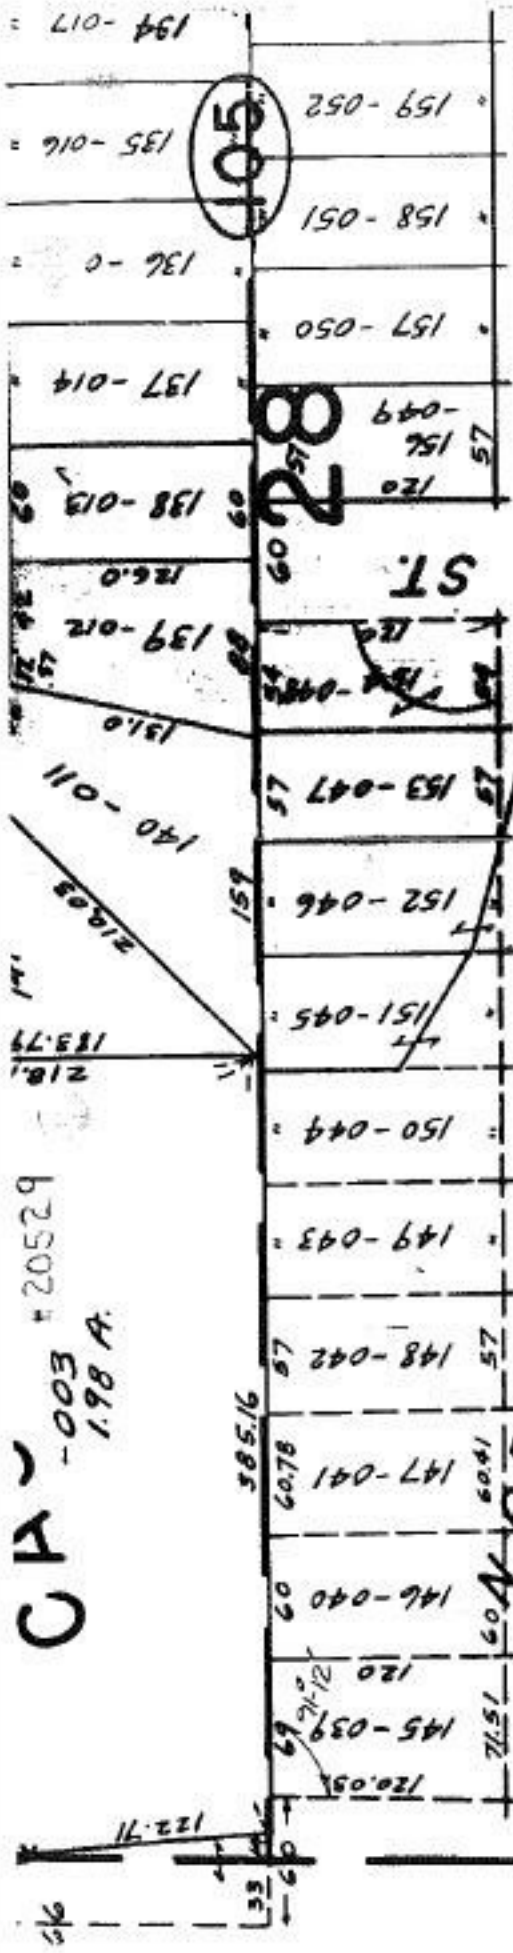

#20568-V
ALLEY #20563-V
VAN BUREN
VACATION

APPROVED
LOUISIANA CO
MAP DEPT
DATE 2-28-84
PAGE 6-82
BY T. McNeil
NO. 116
382 387 4 205

63V