
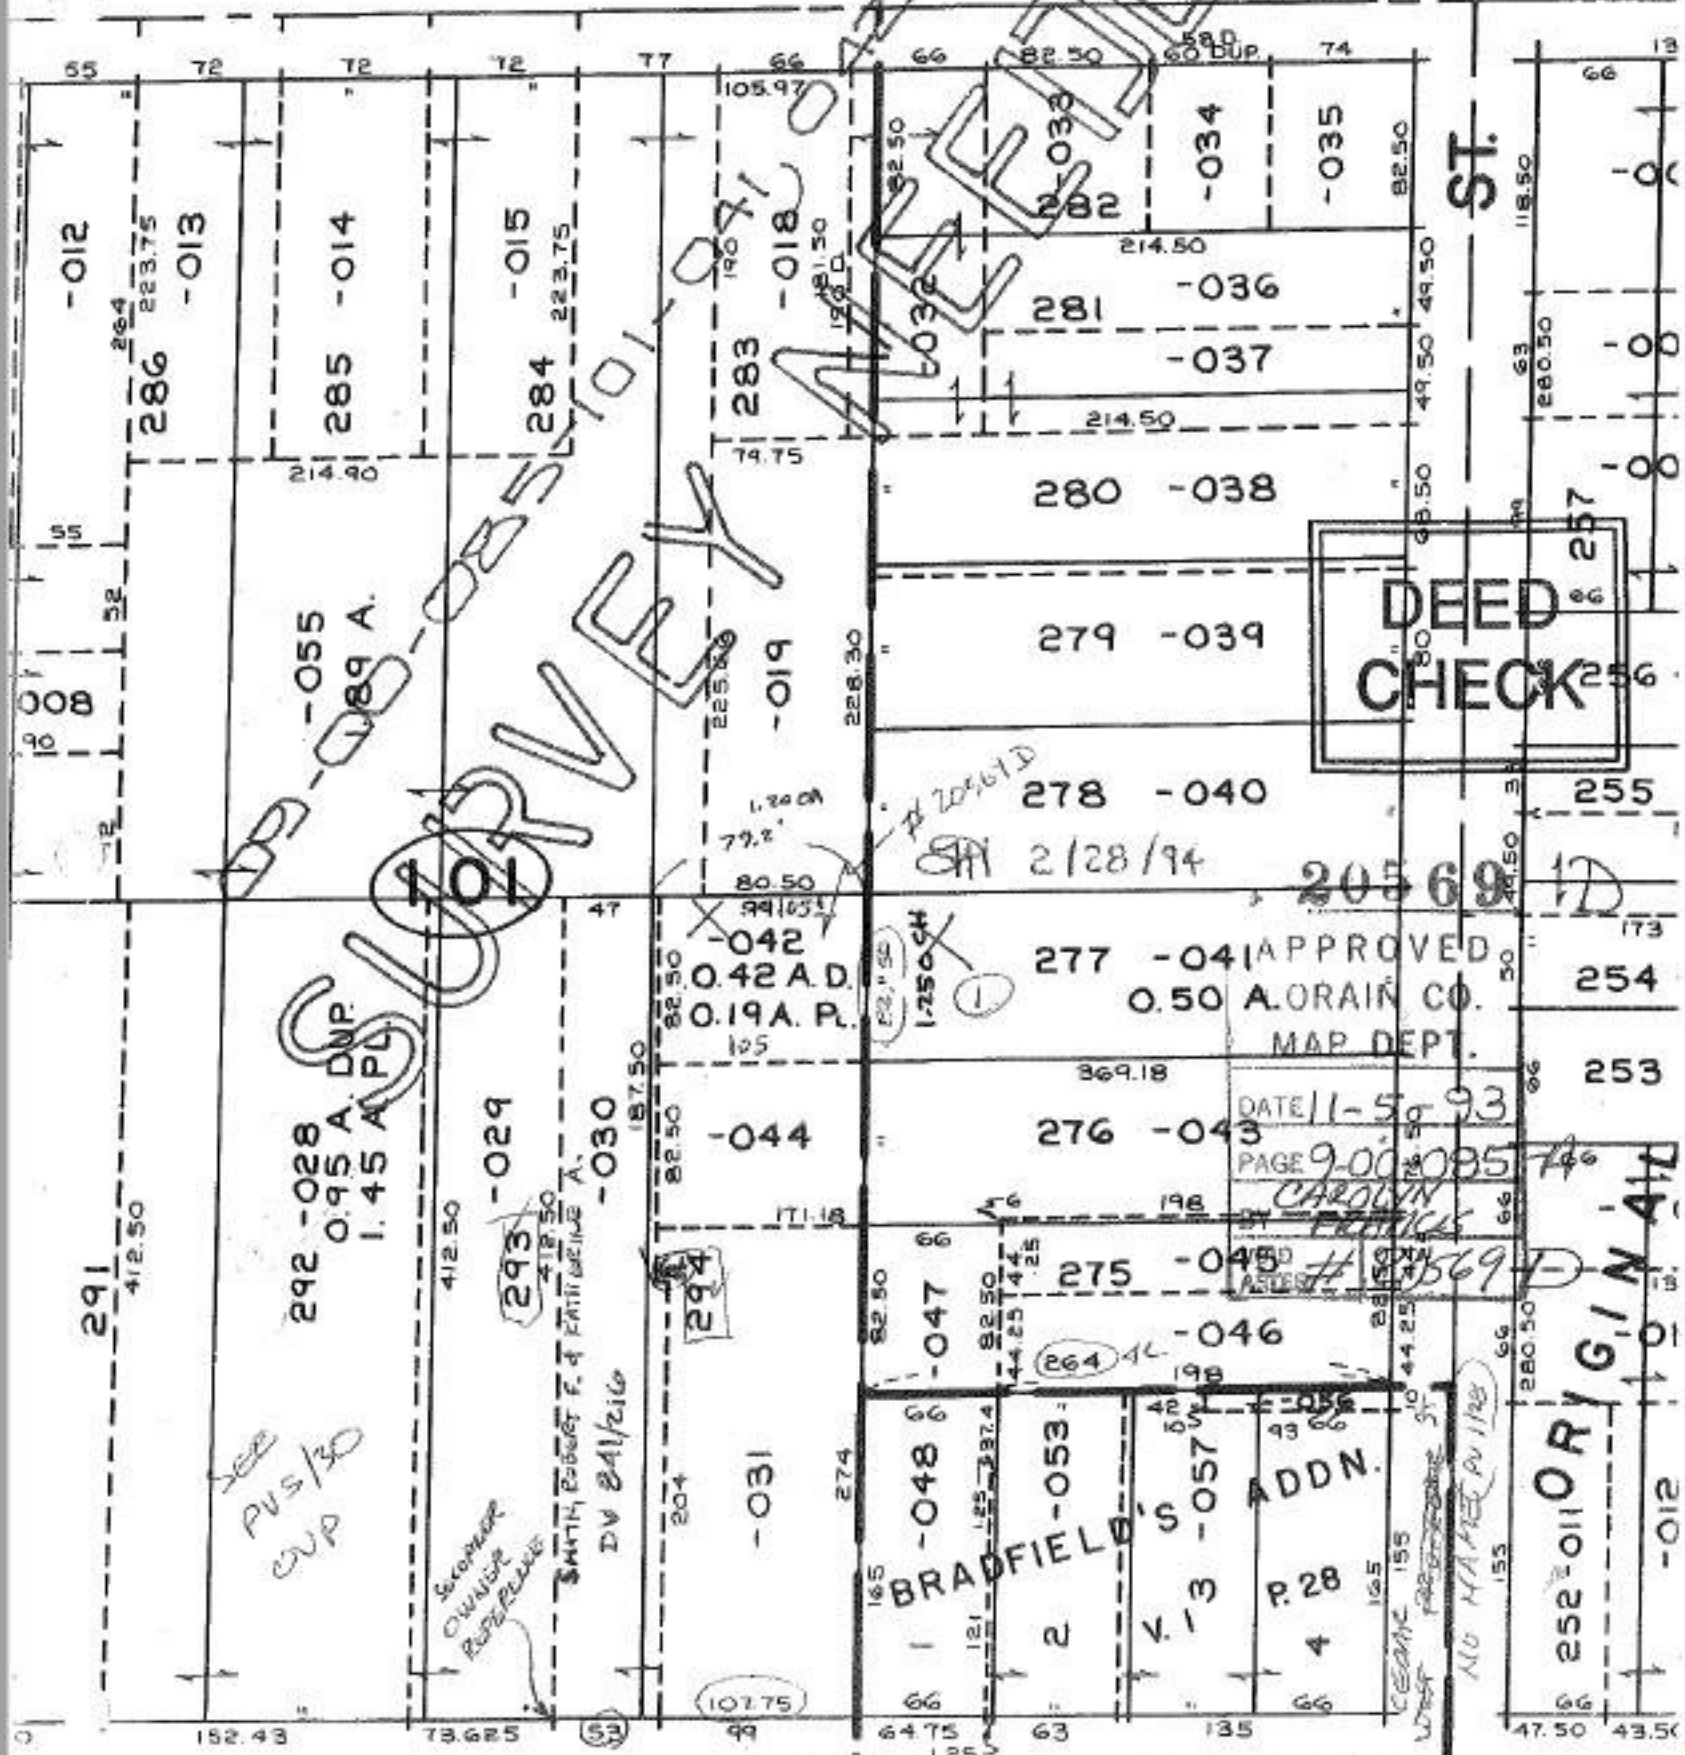


SEE 9-00-075-A

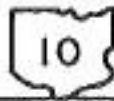

DEED CHECK

APPROVED
0.50 A. ORAIN CO.
MAP DEPT.

DATE 11-5-93

PAGE 9-00-085

CAROLYN FRANKS

20569

20569

ADDN.

P. 28

4

105

CREAM 155

WEST

NO MARKET PU 1/28

153

289 A.

0.95 A. DNP
1.45 A. PL

see
PVS/30
CVP

SMITH, ROBERT F. & PATRICIA A.
DV 2/1/20

COLLEGE

252 ORIGIN

ST.