


175144
2.69 A
16-45A

58

RD.

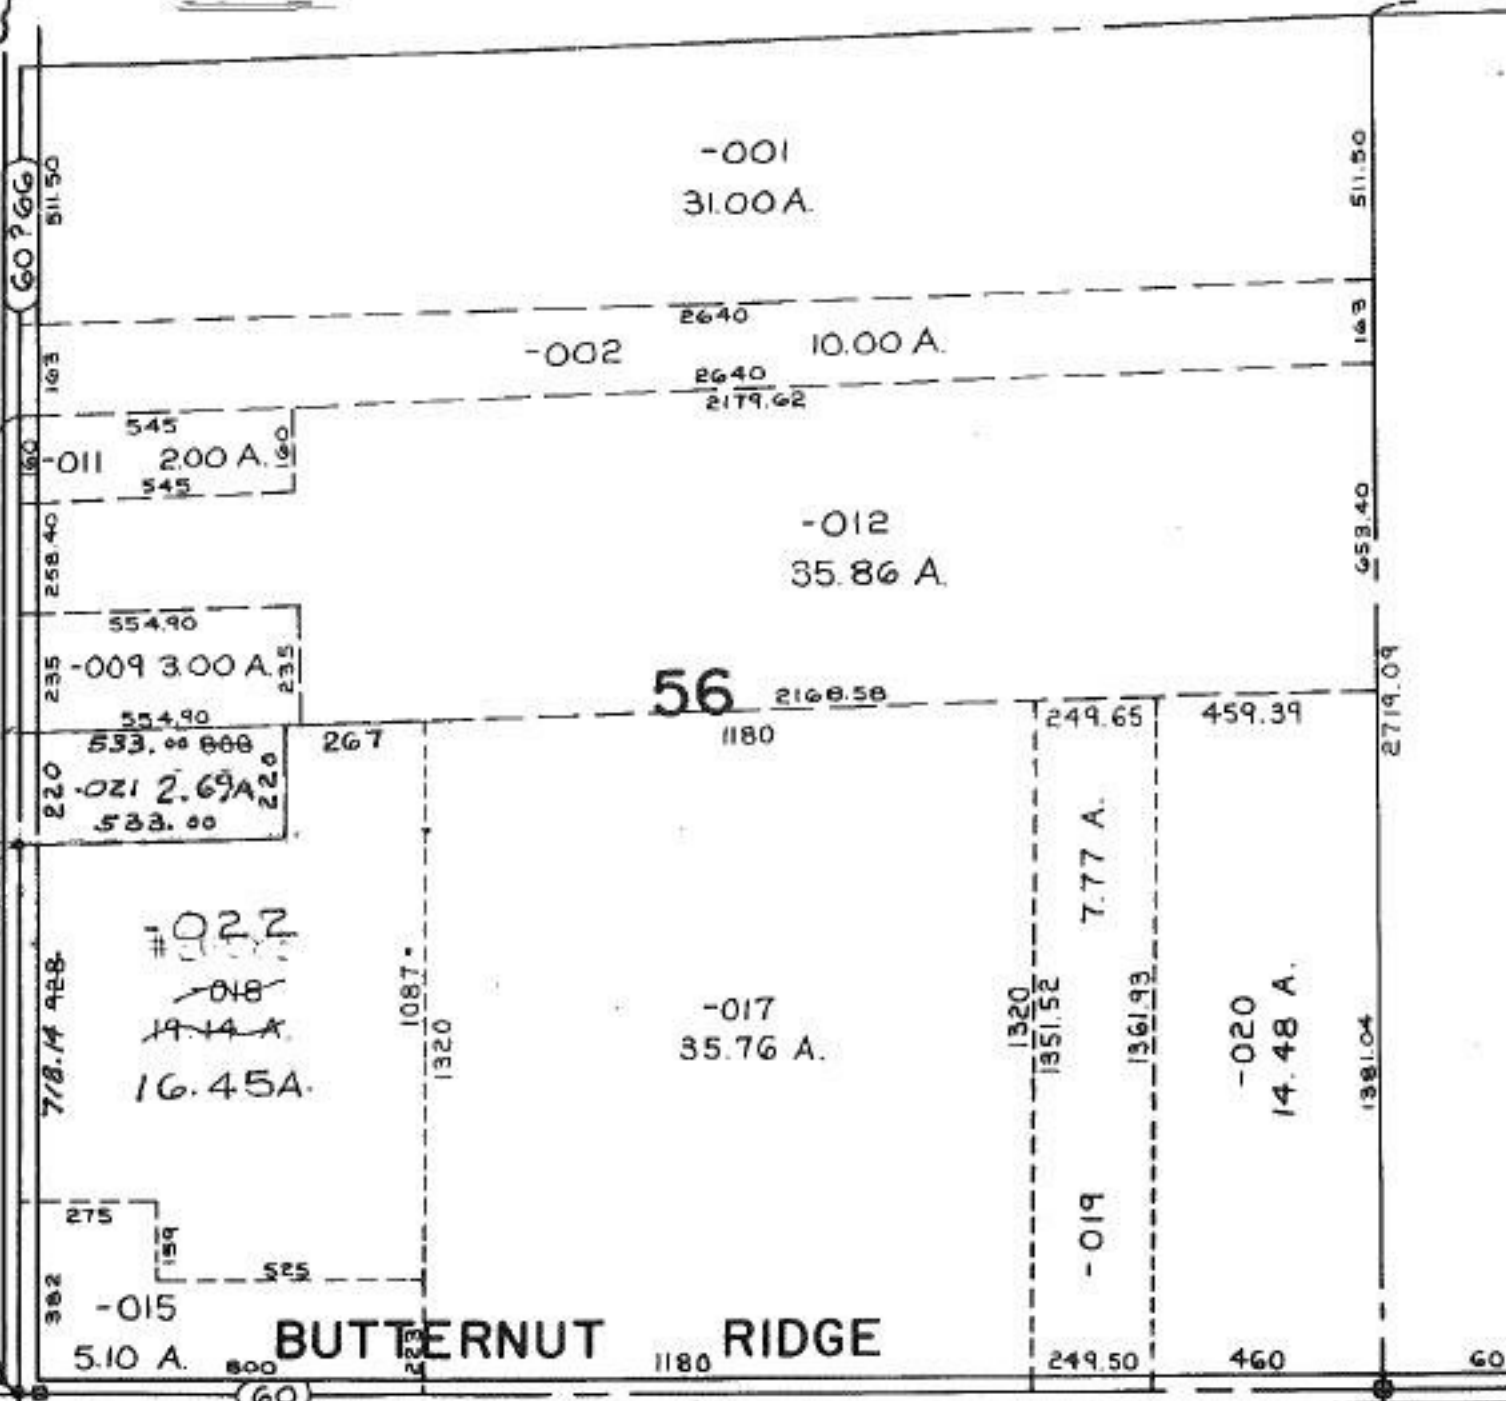

1320.14
1100.14
1980
718.14
928

#022
1914 A
16.45 A

BUTTERNUT RIDGE

P.P.NO. 09-00-056-000-
 PRIOR INST: O.R.370/332
 CLOSURER: C=1:INF.
 SURVEYED BY: NORMAN R. HURA
 REG. SURVEYOR

20583
 APPROVED
 LORAIN CO.
 MAP DEPT.
 DATE 10-28-93
 PAGE 9-G
 BY CAROLYN FRANCIS
 W&D # 20583

66-A