


2060



APPROVED  
 LORAIN CO.  
 MAP DEPT.  
 DATE 8-27-68  
 10-00-013A  
 BY *Grace*

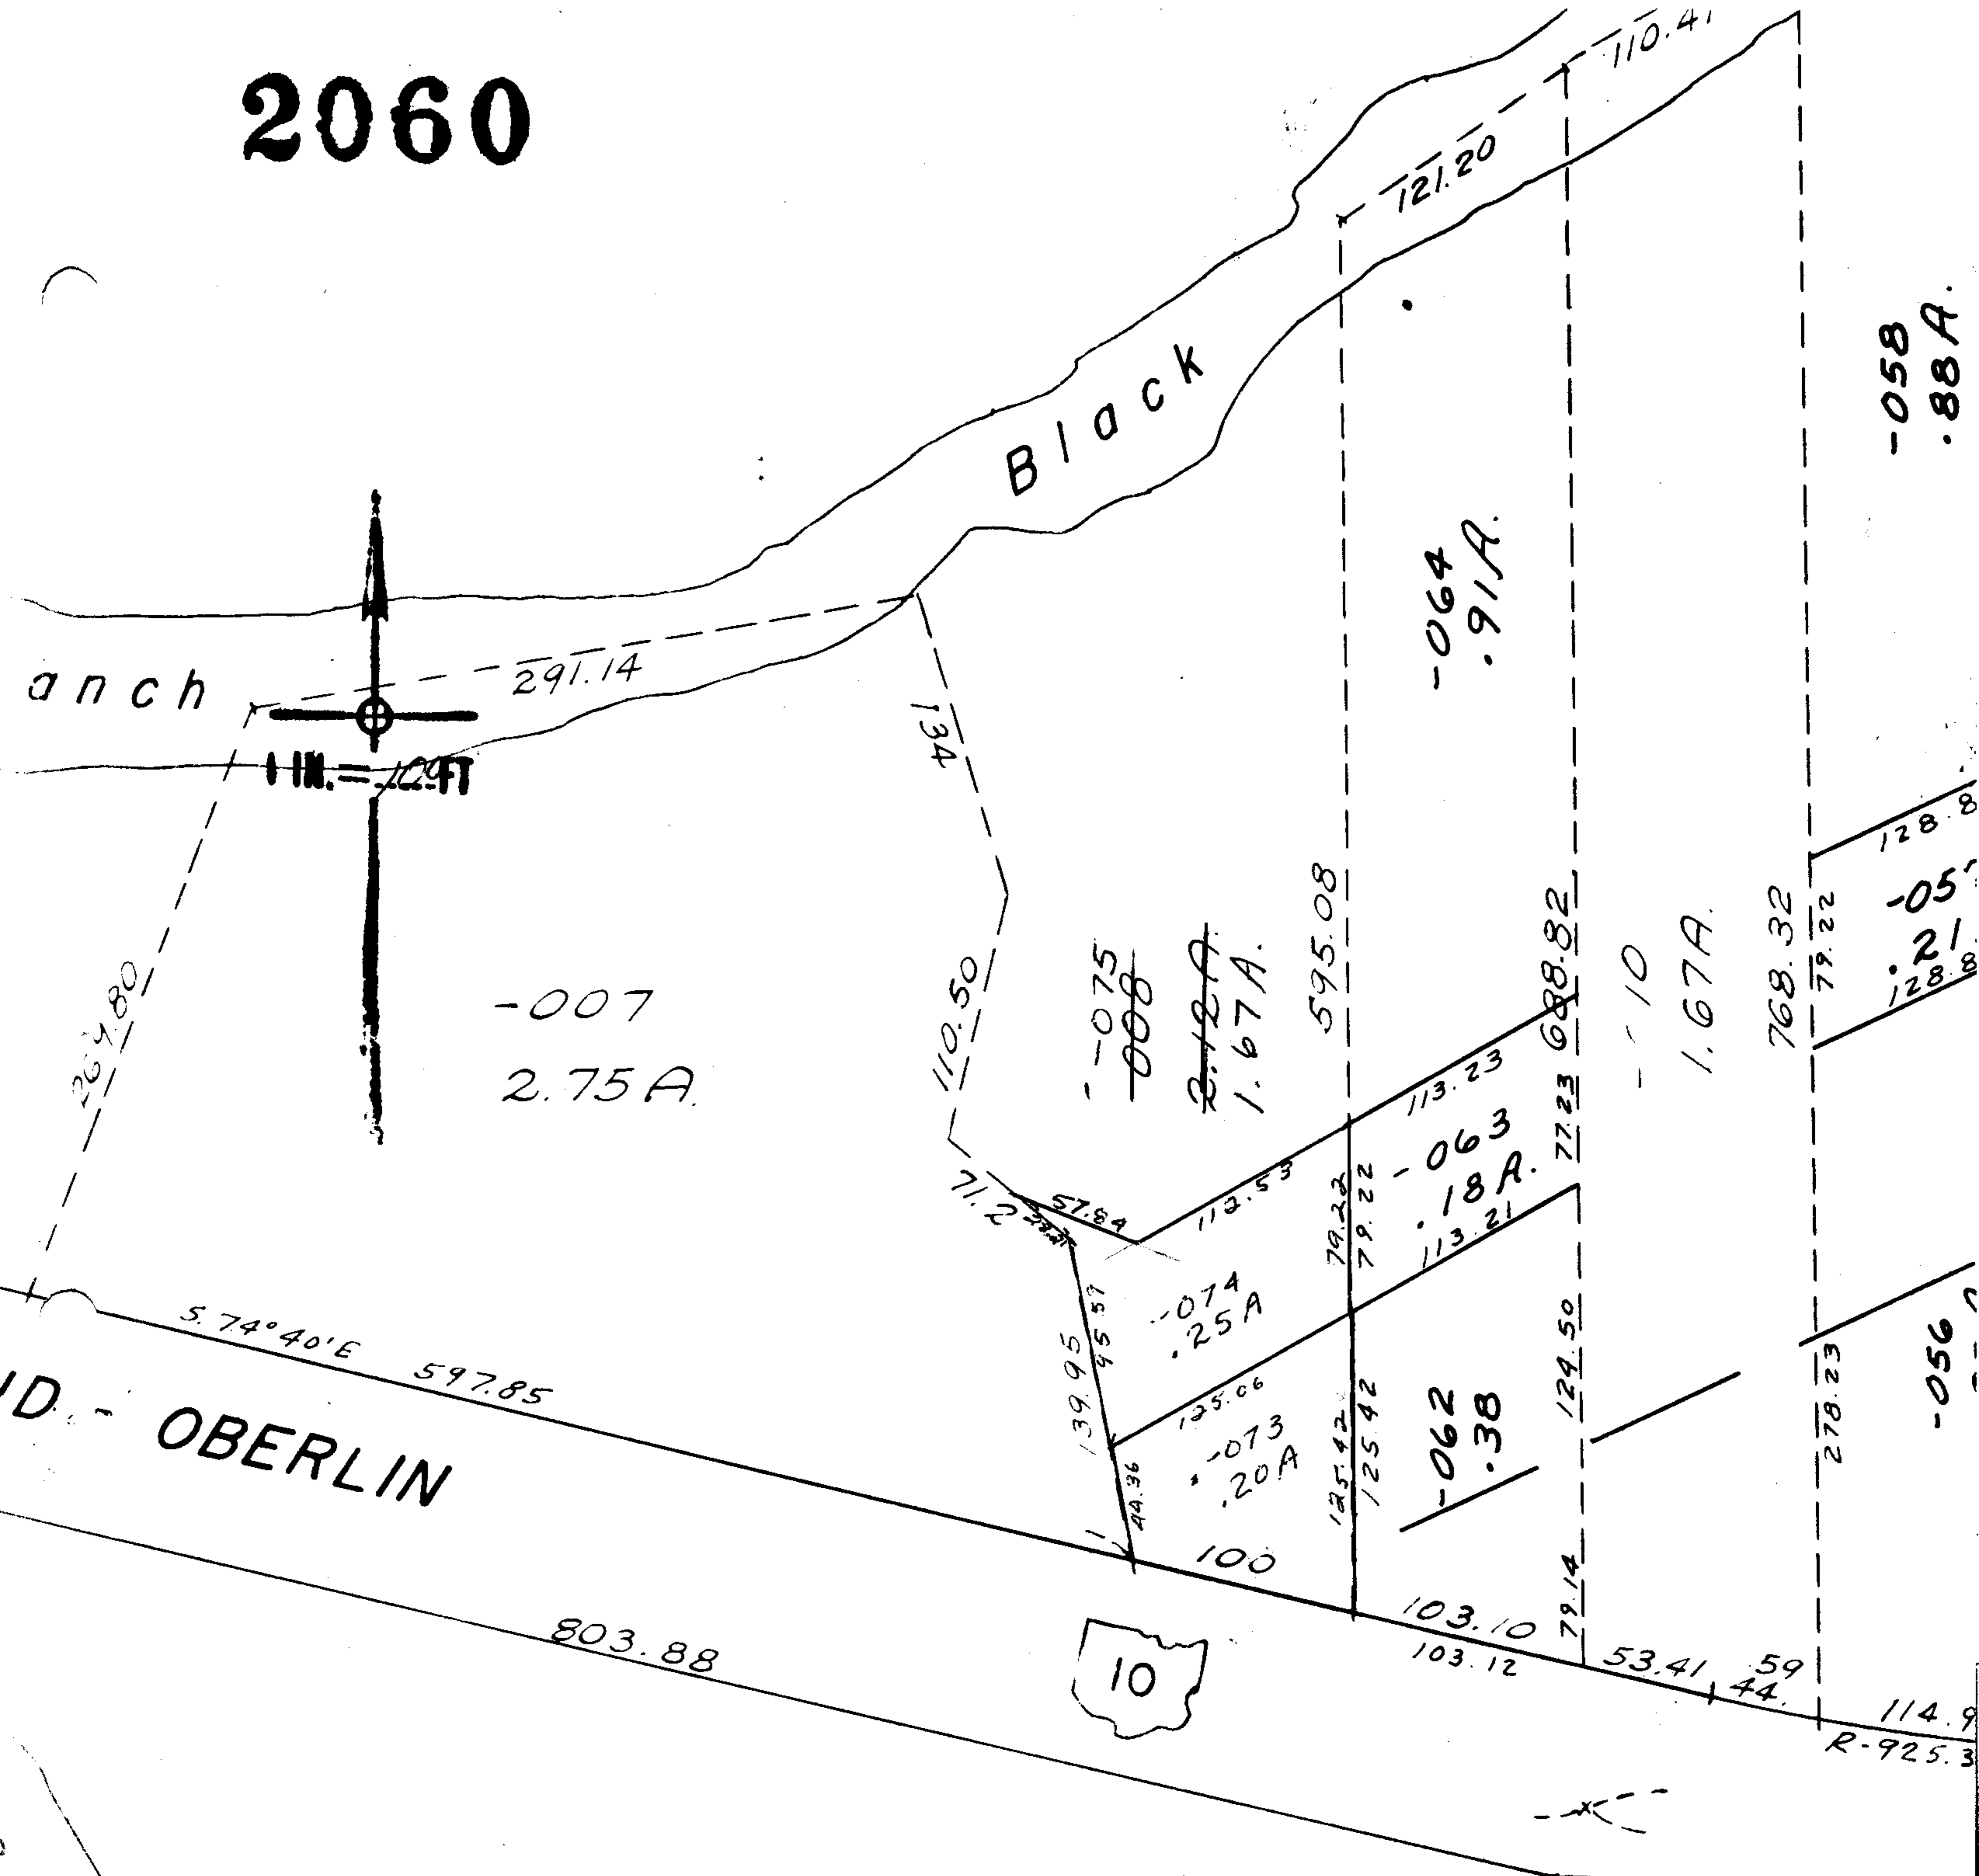

S.S.  
 7FB1082  
 Pt. 67.24A.

9/28/68 R.K.