


GARFIELD RD 472

RD. (50)

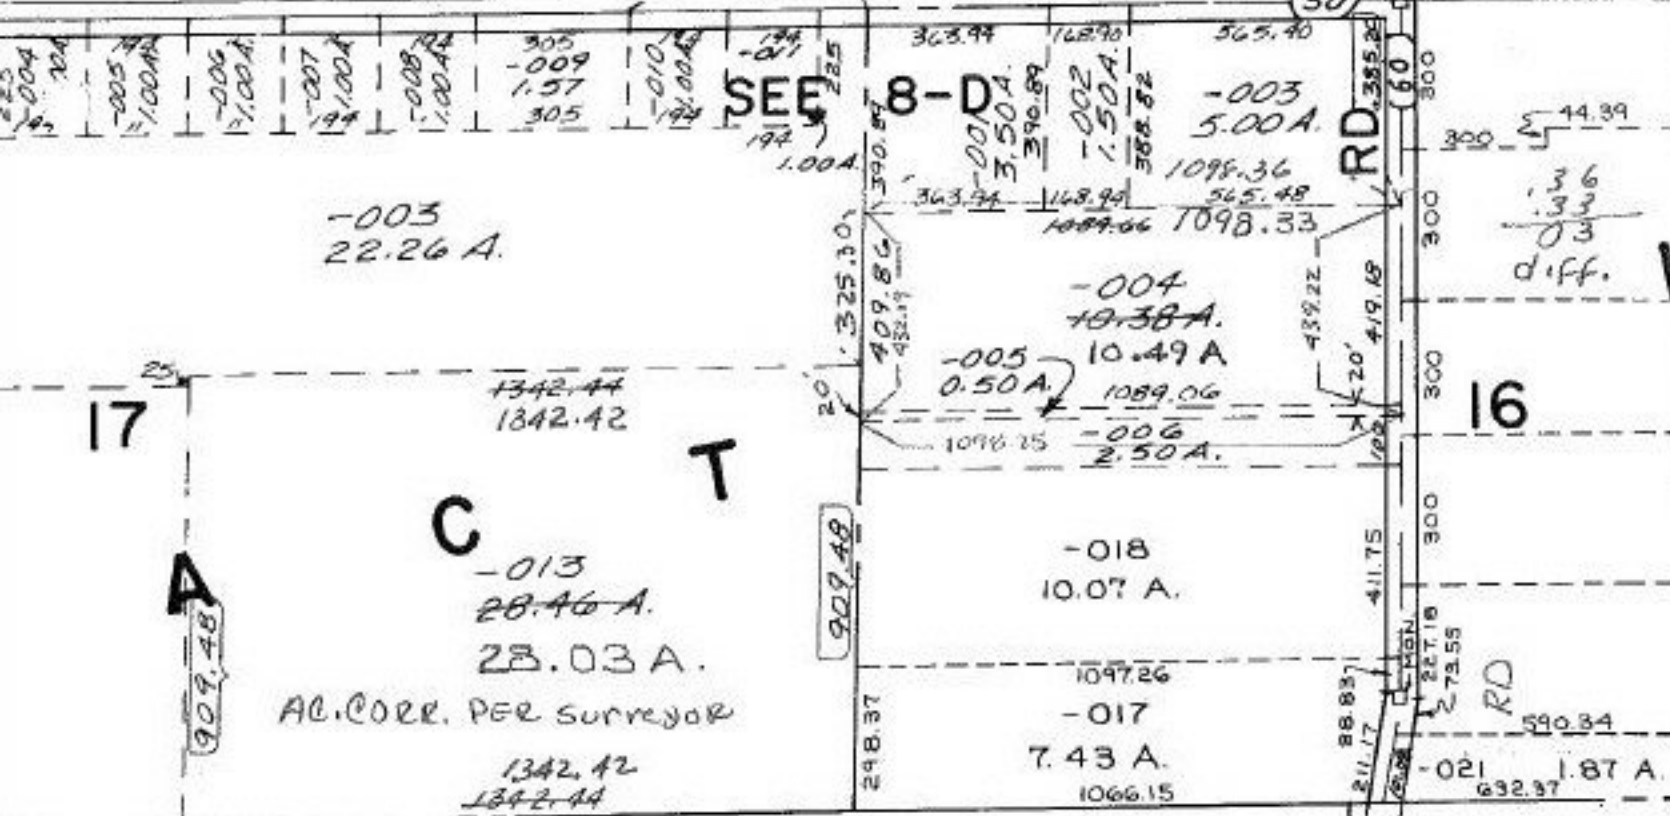

ACREAGE CORRECTION

08-15-017-000-
 PRIOR INST: 606 1523
 AC. CORR. PER SURVEY BY
 -001 EARL H HUNTER
 REG SURVEYOR
 47.70 A.

ACREAGE CORRECTION
 BAUMART

VOID
SEE 20770-A
 8/19/94

20602A

APPROVED
 ORAIN CO.
 MAP DEPT.

DATE 12-16-93

PAGE 8-H

CAROLYN FRANCIS

20602A