


E 3-JO-071-A

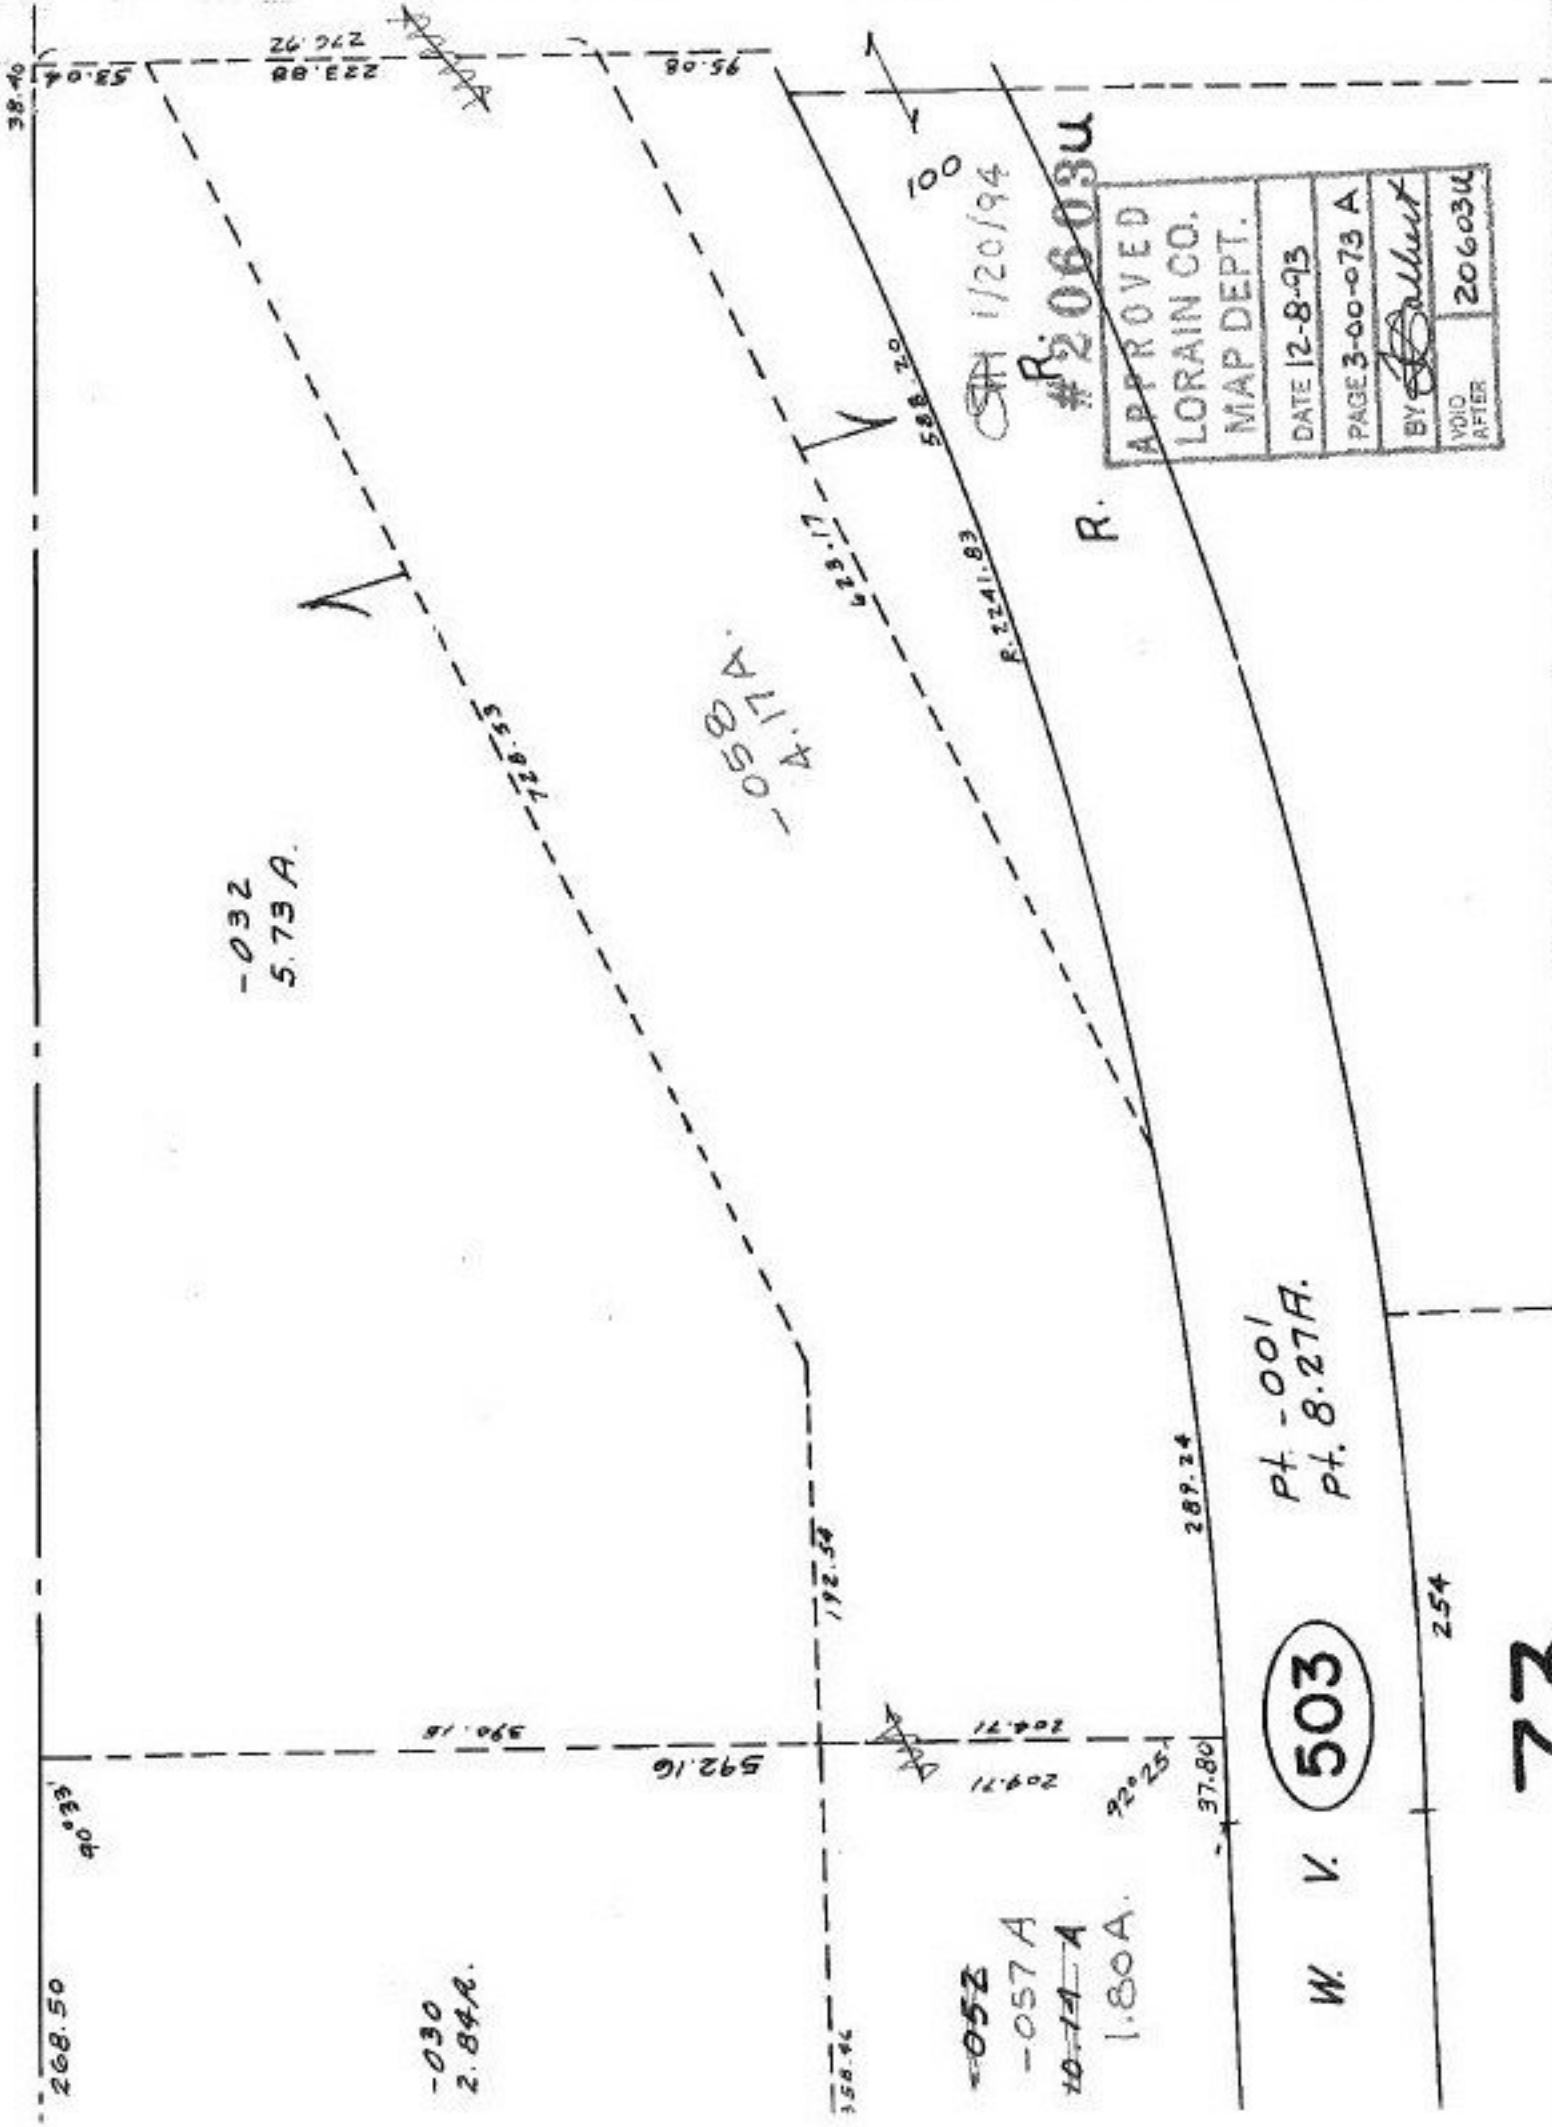

APPROVED
 LORAIN CO.
 MAP DEPT.
 DATE 12-8-93
 PAGE 3-00-073 A
 BY *[Signature]*
 VOID AFTER 20603U

W. V. 503

72