


2529.7
FROM REED 120

2899.70
COOLEY 2774.70

SEE 11-00-008-A

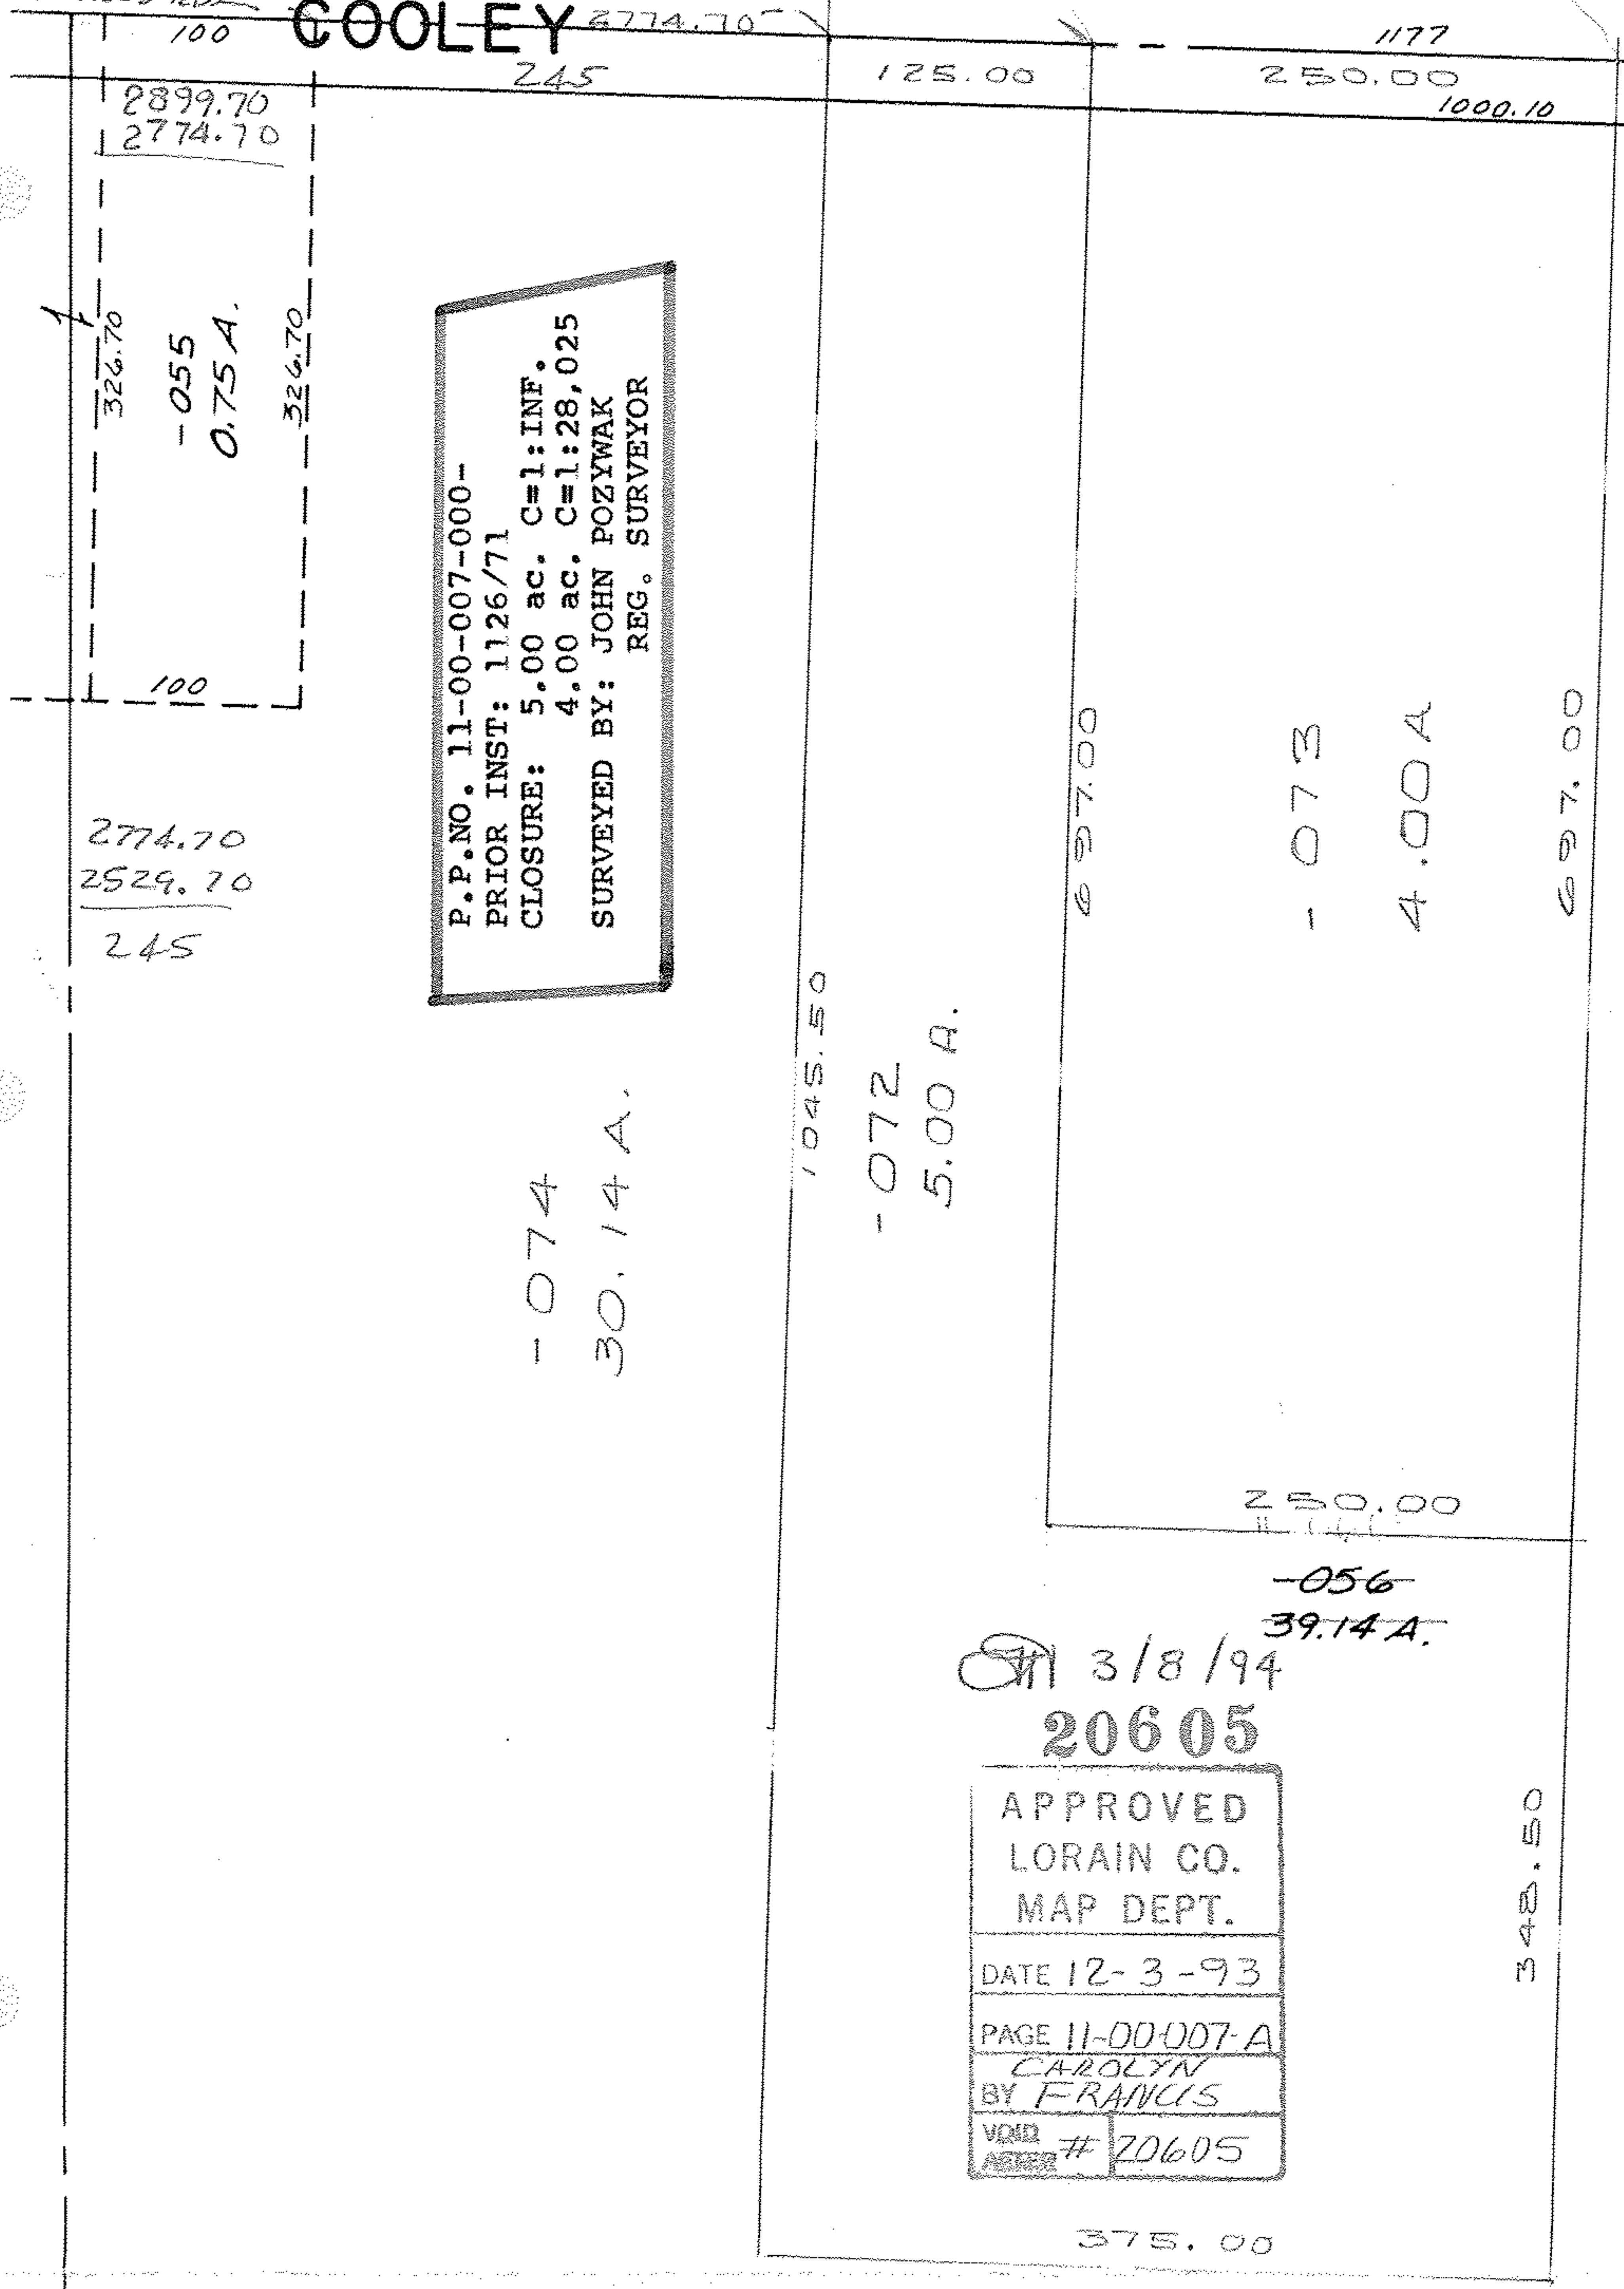

P.P. NO. 11-00-007-000-
 PRIOR INST: 1126/71
 CLOSURE: 5.00 ac. C=1:INF.
 4.00 ac. C=1:28,025
 SURVEYED BY: JOHN POZYWAK
 REG. SURVEYOR

3/8/94
20605
 APPROVED
 LORAIN CO.
 MAP DEPT.
 DATE 12-3-93
 PAGE 11-00-007-A
 CAROLYN
 BY FRANCIS
 VOID # 20605

348.50