


Medina Norwalk Rd

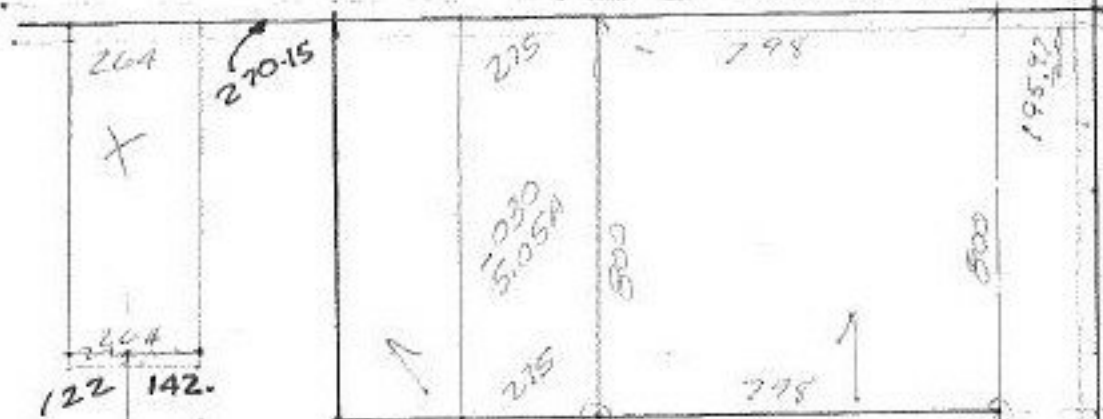


264
122 142.

225
275

195

500

*TO M
TAX MAP NORTH AND
SOUTH DISTANCES IS SHORT
Medina RW bearing DO NOT
LINE UP WITH HAWLEY RD
bearing.*

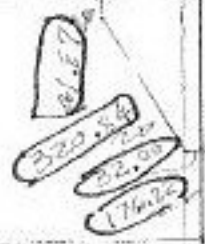

423.41
422.90
0.51
Record

2504.66

1751.44

206 10

APPROVED LORAIN CO. MAP DEPT.	
DATE	
PAGE	
BY	
VOID	AFTER

1246.21

650

1404.43

Hawley Rd

This B/W AND Length of TAX MAP IS

Cemetery Rd.