


ALL SURVY D

RD. 20
296.43

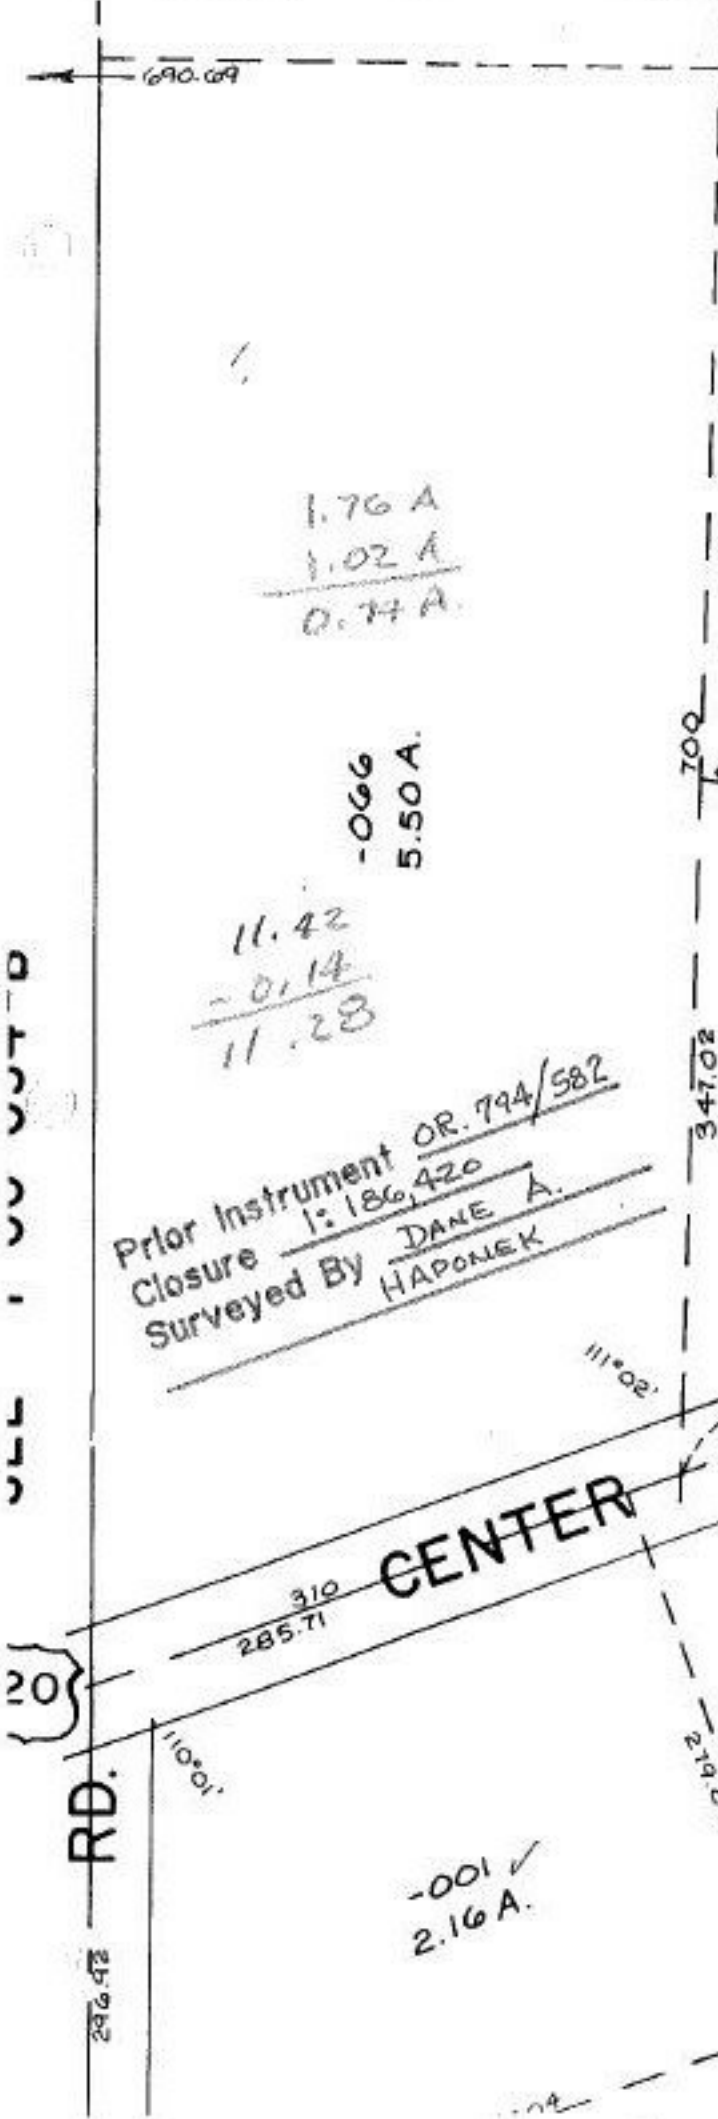

#20629

APPROVED	75.43
LORAIN CO.	
MAP DEPT.	
DATE	12-15-93
PAGE	7-00-028C
BY	J. Bollett
VOID AFTER	20629

-007
4.02 A.

-030
11.42 A

-096
11.28 A.