


0.81

P.P.NO. 15-00-046-101-
 PRIOR INST: 960/568
 CLOSURE: C=1:1NE
 SURVEYED BY: JOHN POZYWAK REC.
 SURVEYOR

101

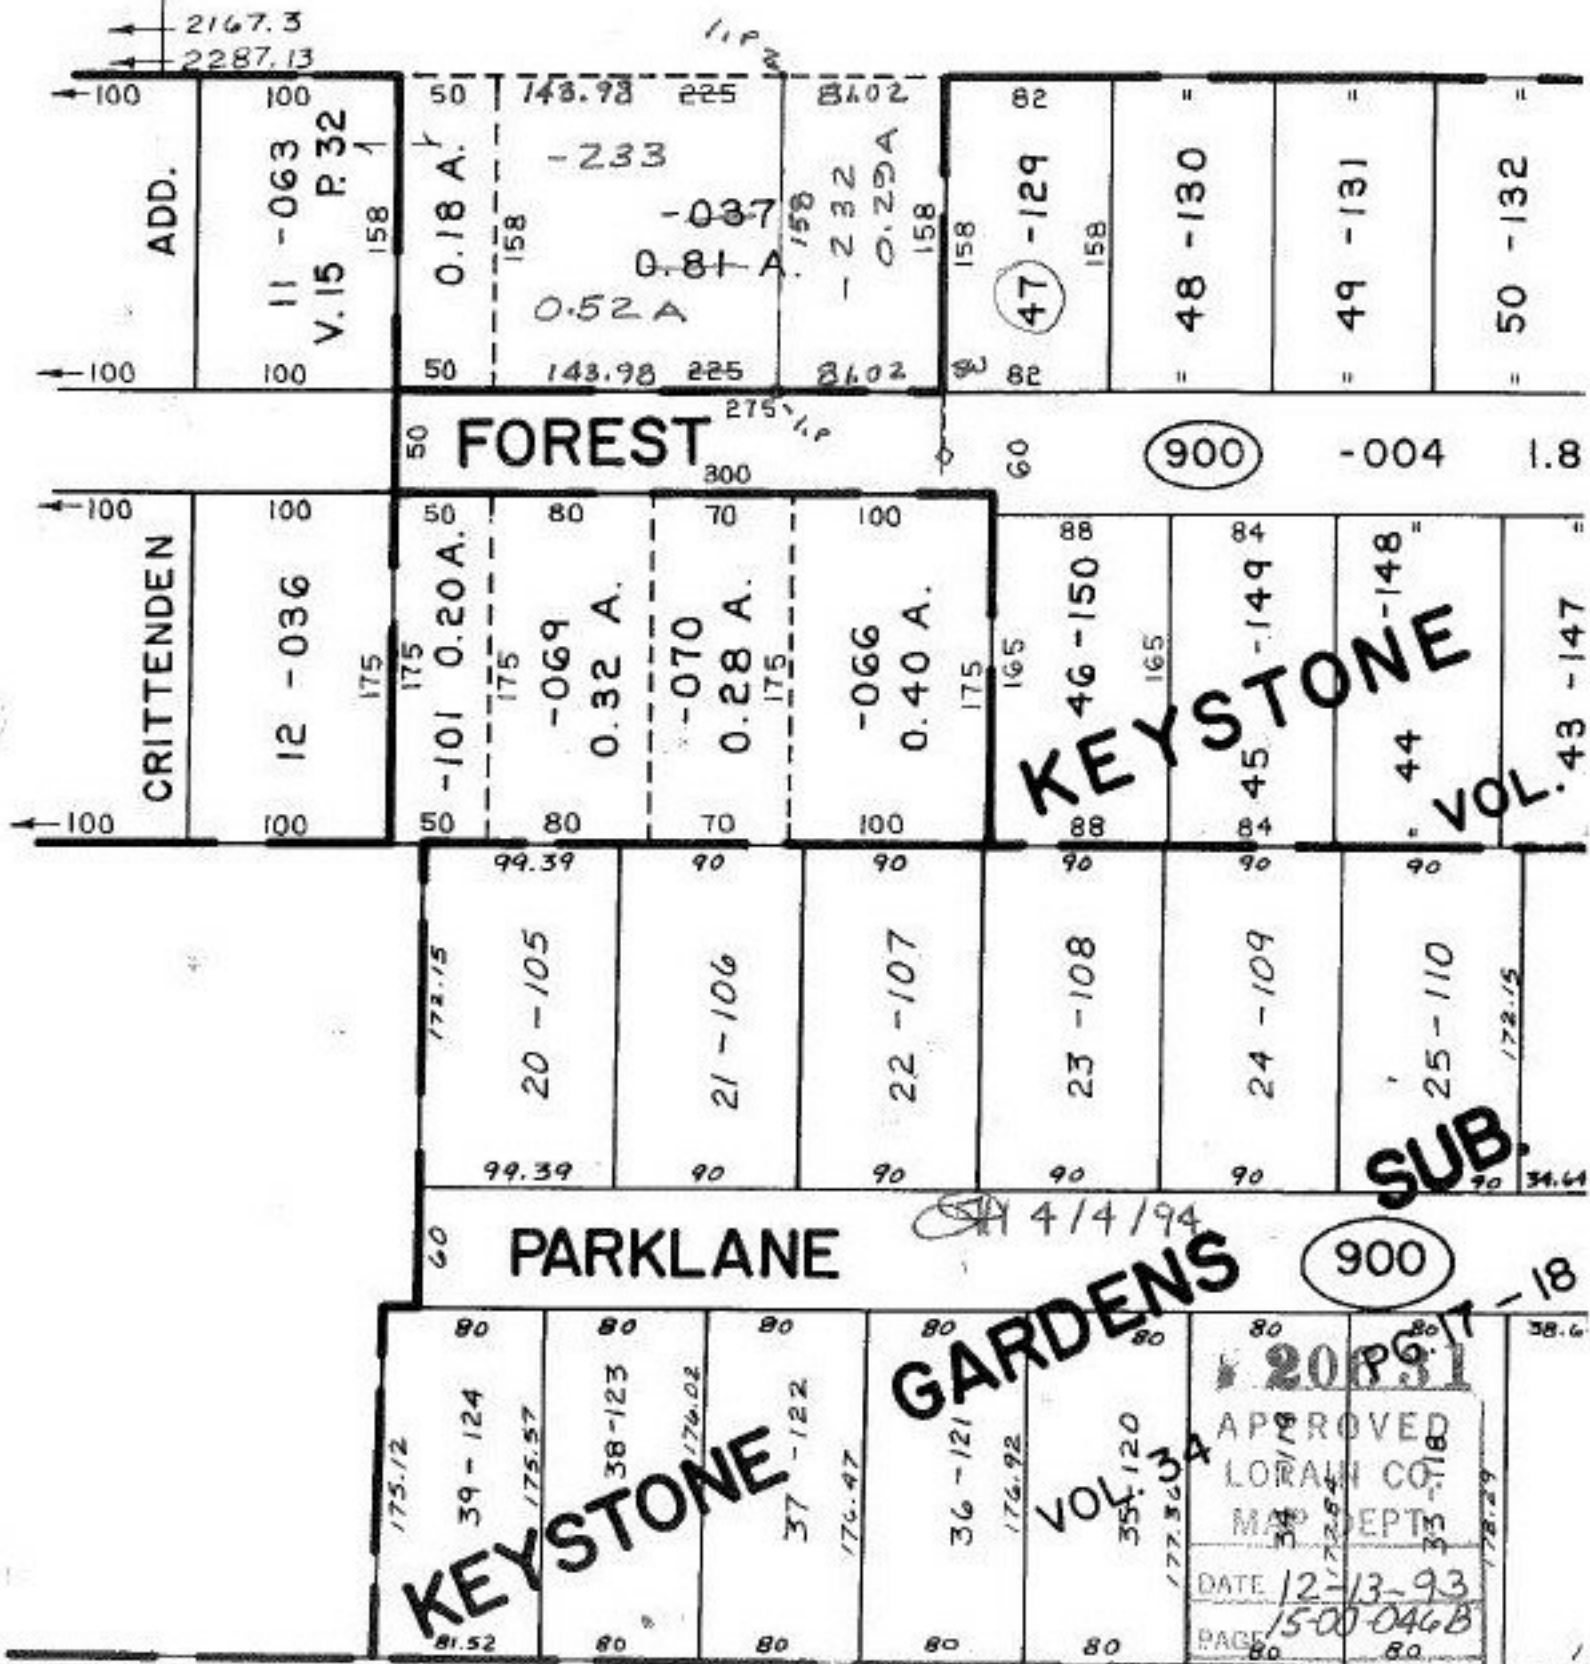

SEE 15-00-046-A

KEYSTONE

SUB.

KEYSTONE

GARDENS

APPROVED
 LORAIN CO.
 MAP DEPT.
 DATE 12-13-93
 PAGE 15-00-046B
 BY Carolyn Francis
 VOID AFTER # 20631

4/4/94