


AVON - BELDEN RD.

RD.

556.84

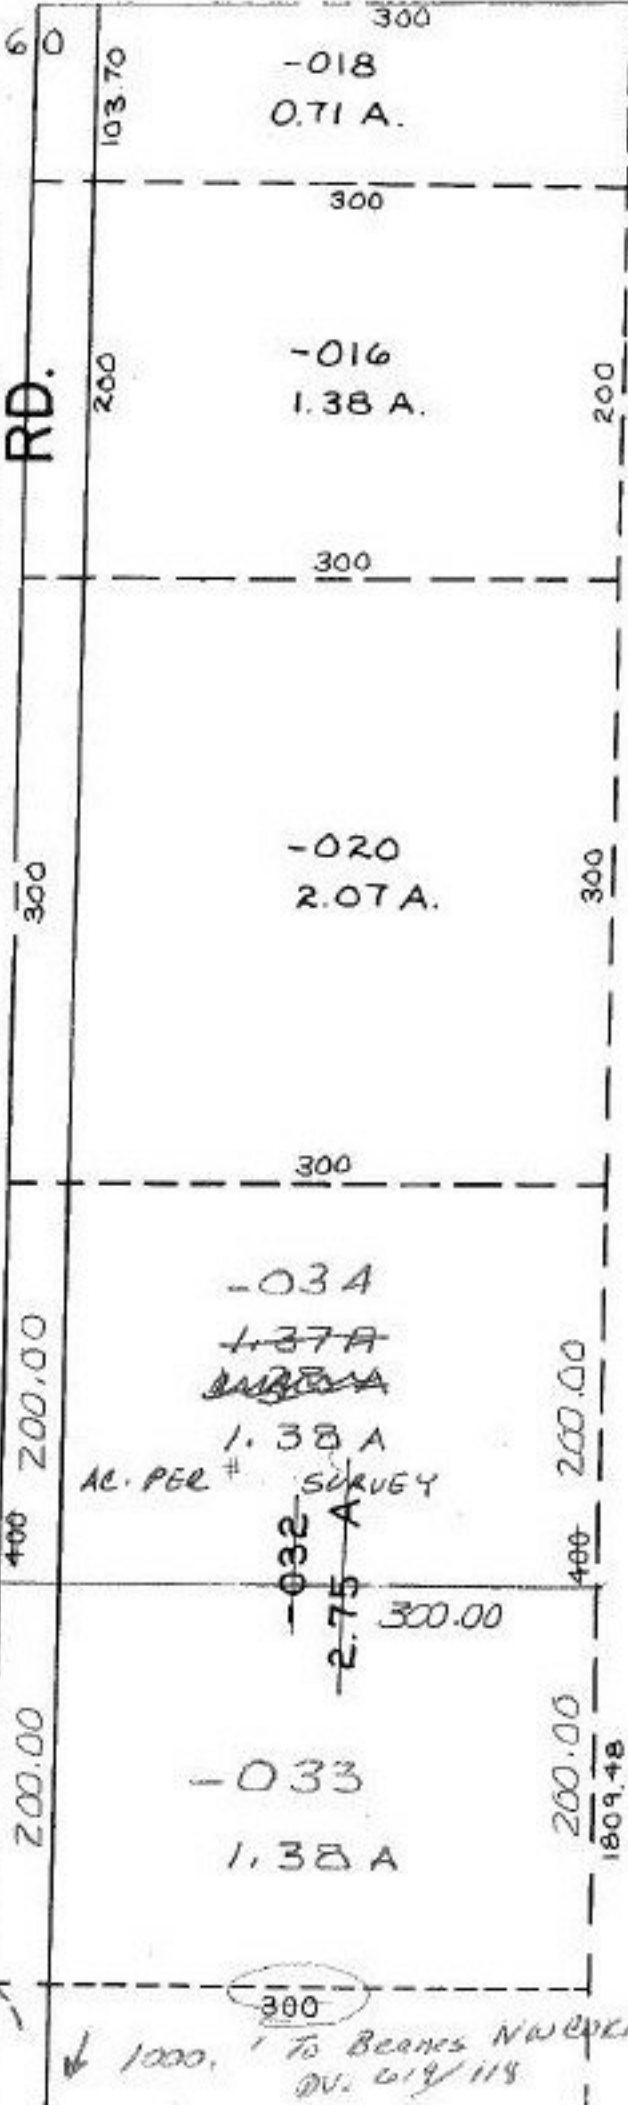

P.P. NO. 16-00-015-000-
 PRIOR INST: O.R. 351/93
 CLOSURE: C=1: INF.
 SURVEYED BY: DOUG MOSLEY
 REG. SURVEYOR

4/4/94
 # 20636
 20636
 APPROVED
 DRAIN CO.
 MAP DEPT.
 DATE 12-14-93
 PAGE 16-00-015-A
 BY CAROLYN
 FRANCIS
 VOID AFTER # 20637

83