

270.05

487.2
492.82

700.00

926.18

-006
2.13 A.

926.18

126.17

~~015~~
5.00 A.

044
20.01 A

-015 5.00 A
-042 15.01 A
20.01 A

746.17

-020
5.00 A.

~~037 6-8-78-A~~
~~15-01-A~~
~~53-79-A~~

300

726.17

348.56

-009
1.00 A.

377.61

-043
PT. 039-

PT. 68-78-A.
53.77A.

20649

APPROVED
LORAIN CO.
MAP DEPT.

DATE 1-12-94

PAGE 11-00-058A


BY CAROLYN
FRANCIS

VOID AFTER # 20649

SPLIT /
COMBINATION

-044
~~042~~

15.01A
20.01 A

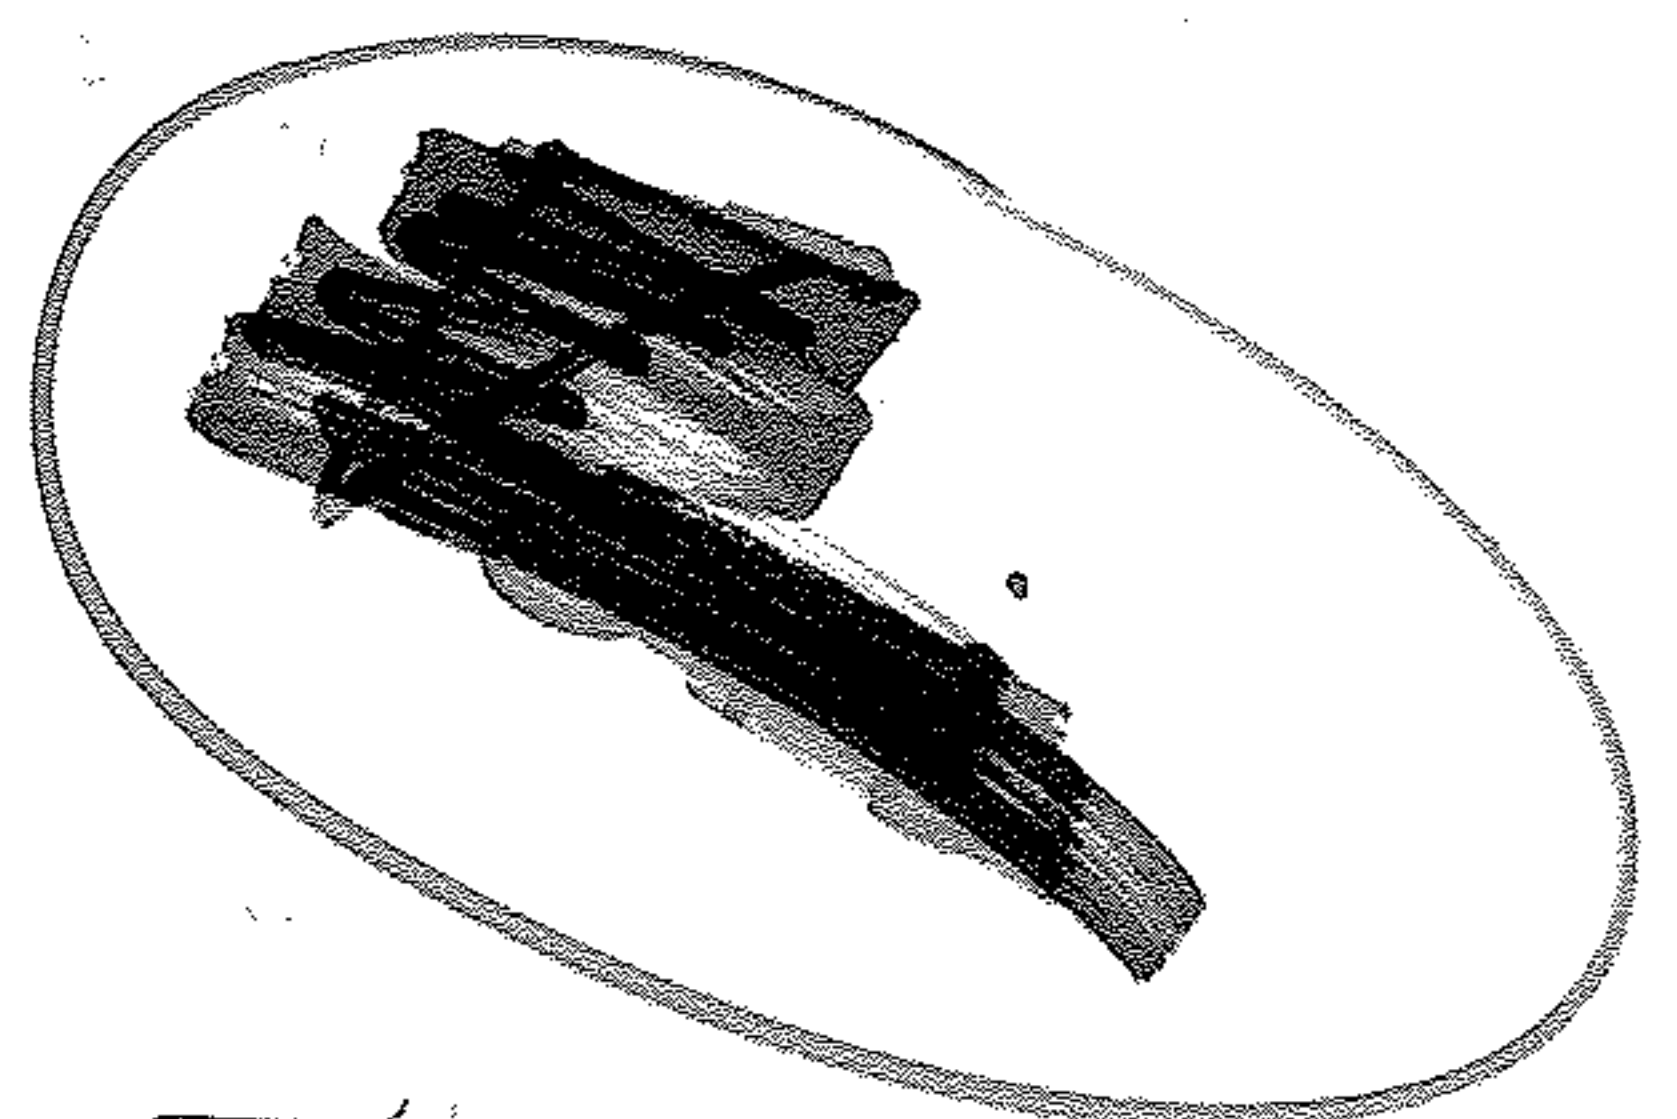

962.84

P.P.NO. 11-00-058-000-
PRIOR INST: O.R.647/193
DV. 1139/720
CLOSURE: cc=1: 93,881 15.01 A
C=1: 134,891 20.01 ac.
SURVEYED BY: JOHN POZYWAK
REG. SURVEYOR

498.96

-043
PT. 039.
PT. 68-78-A.
53.77A.

20649

APPROVED
LORAIN CO.
MAP DEPT.

DATE 1-12-94

PAGE 11-00-058A

BY CAROLYN
FRANCIS

VOID AFTER # 20649

SPLIT /
COMBINATION

AUG 5 1994