


SEE 10-D

to the CHESTNUT  
1035.20 ~~785.20~~ RIDGE RD.

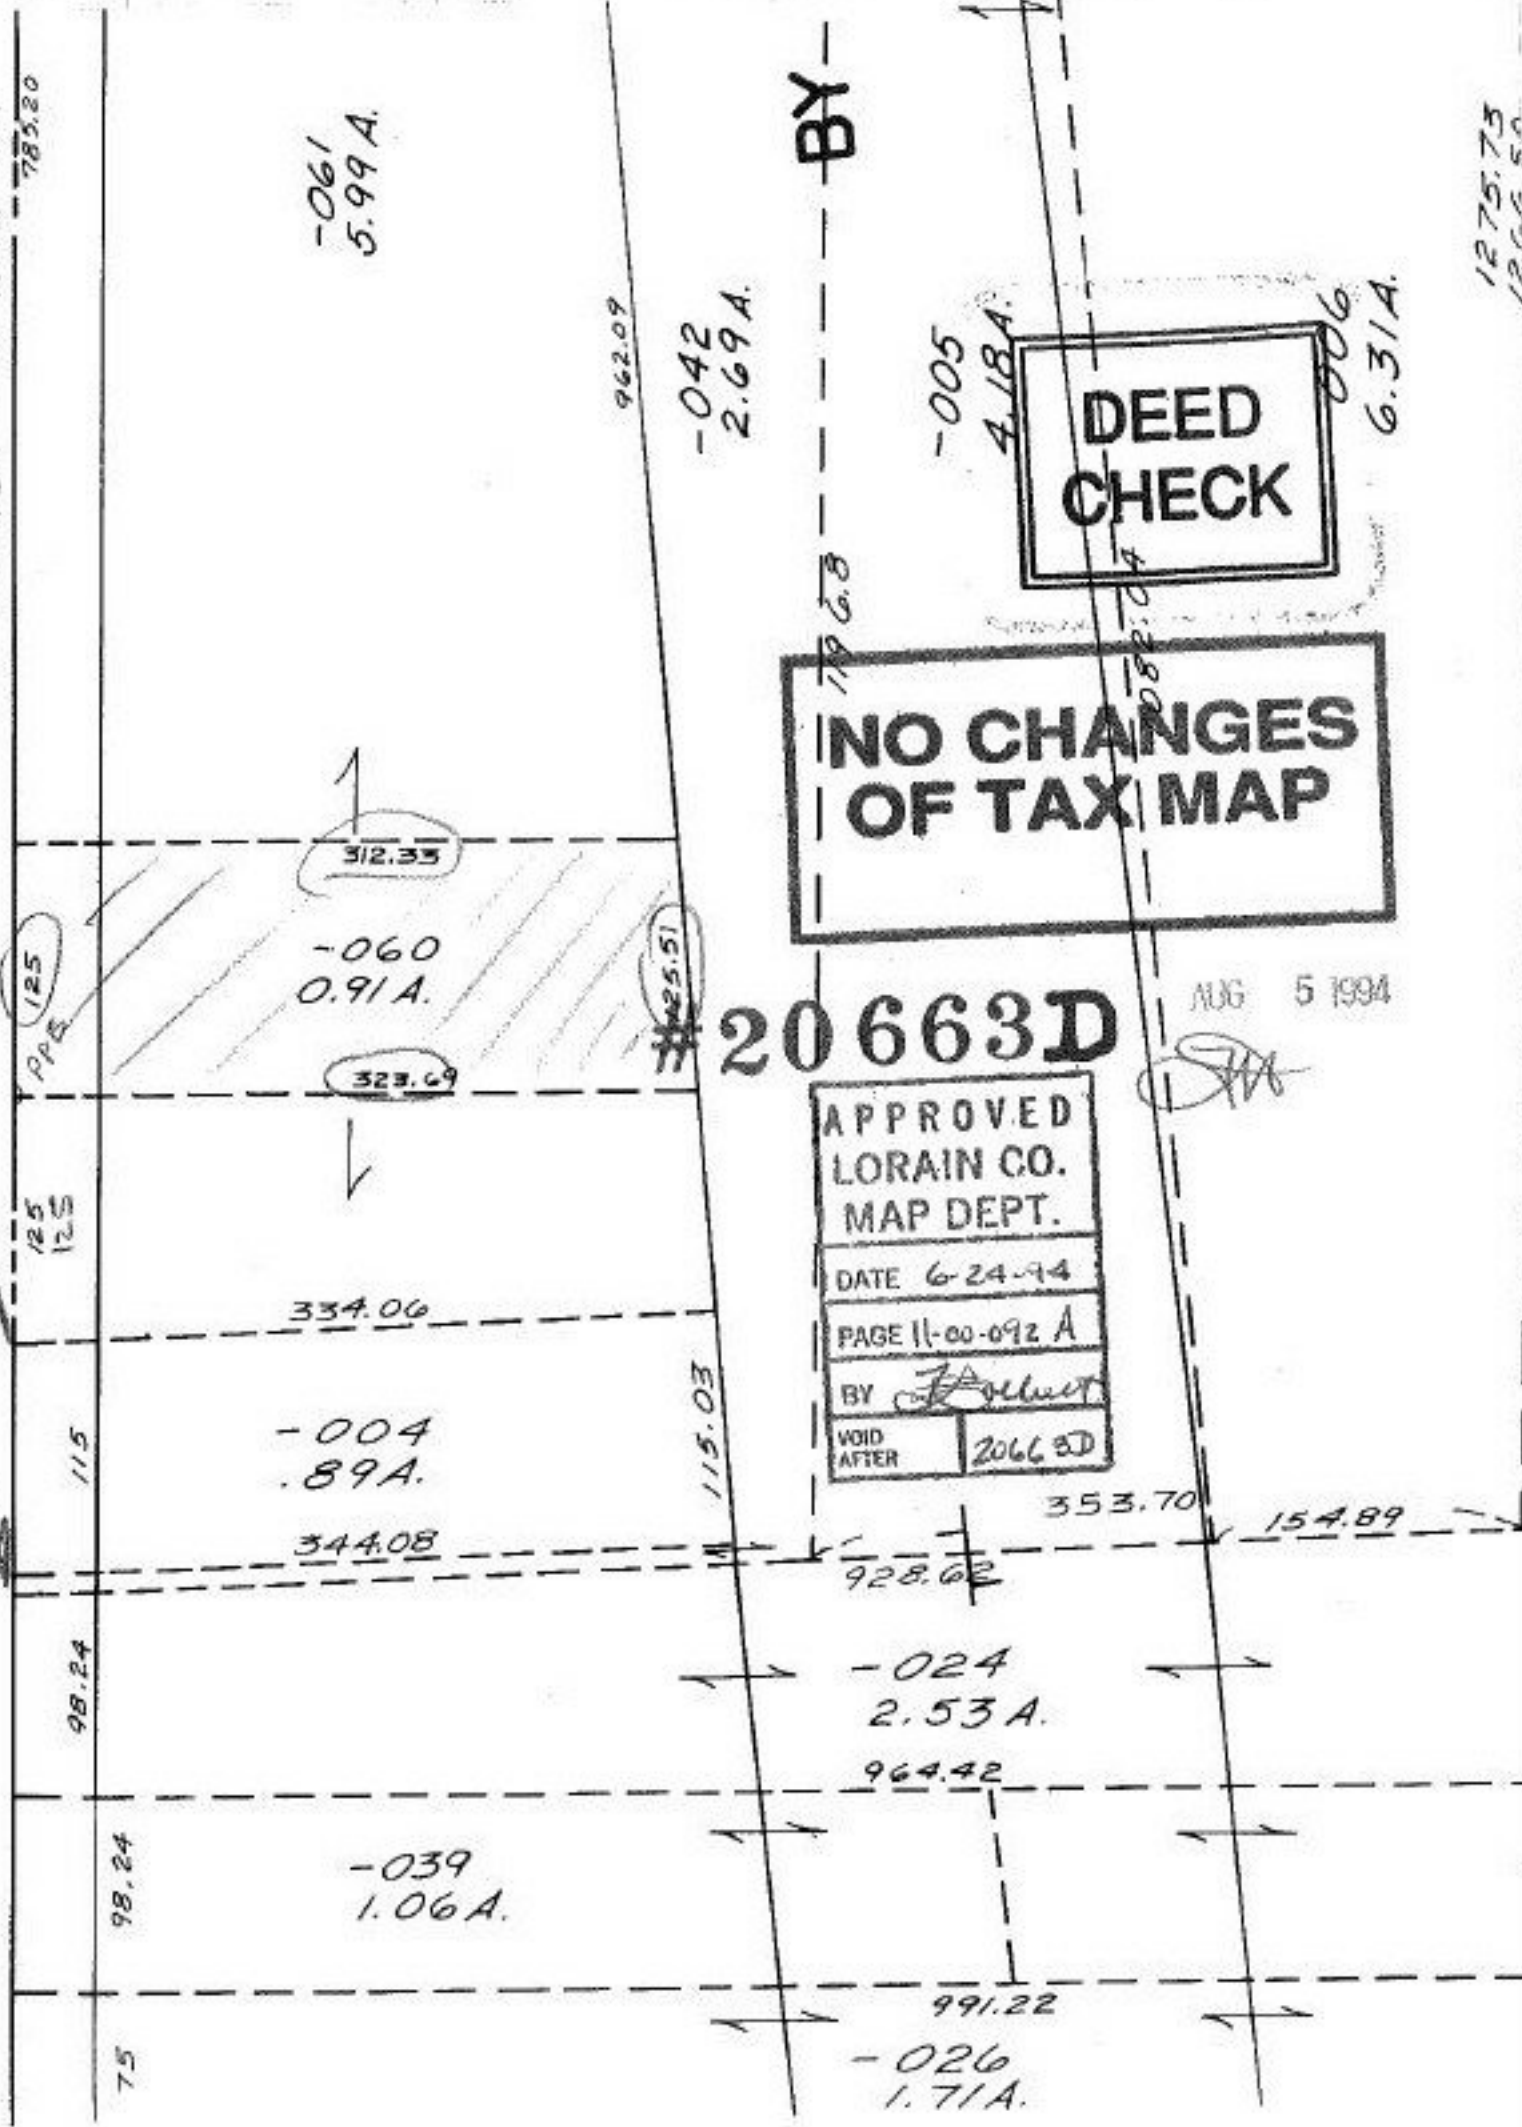

-061  
5.99 A.

-042  
2.69 A.

-005  
4.18 A.

DEED  
CHECK

NO CHANGES  
OF TAX MAP

20663D

AUG 5 1994

APPROVED  
LORAIN CO.  
MAP DEPT.

DATE 6-24-94

PAGE 11-00-092 A

BY *J. Albert*

VOID AFTER 20663D

1275.73  
1265.50