


-002
40.12A.

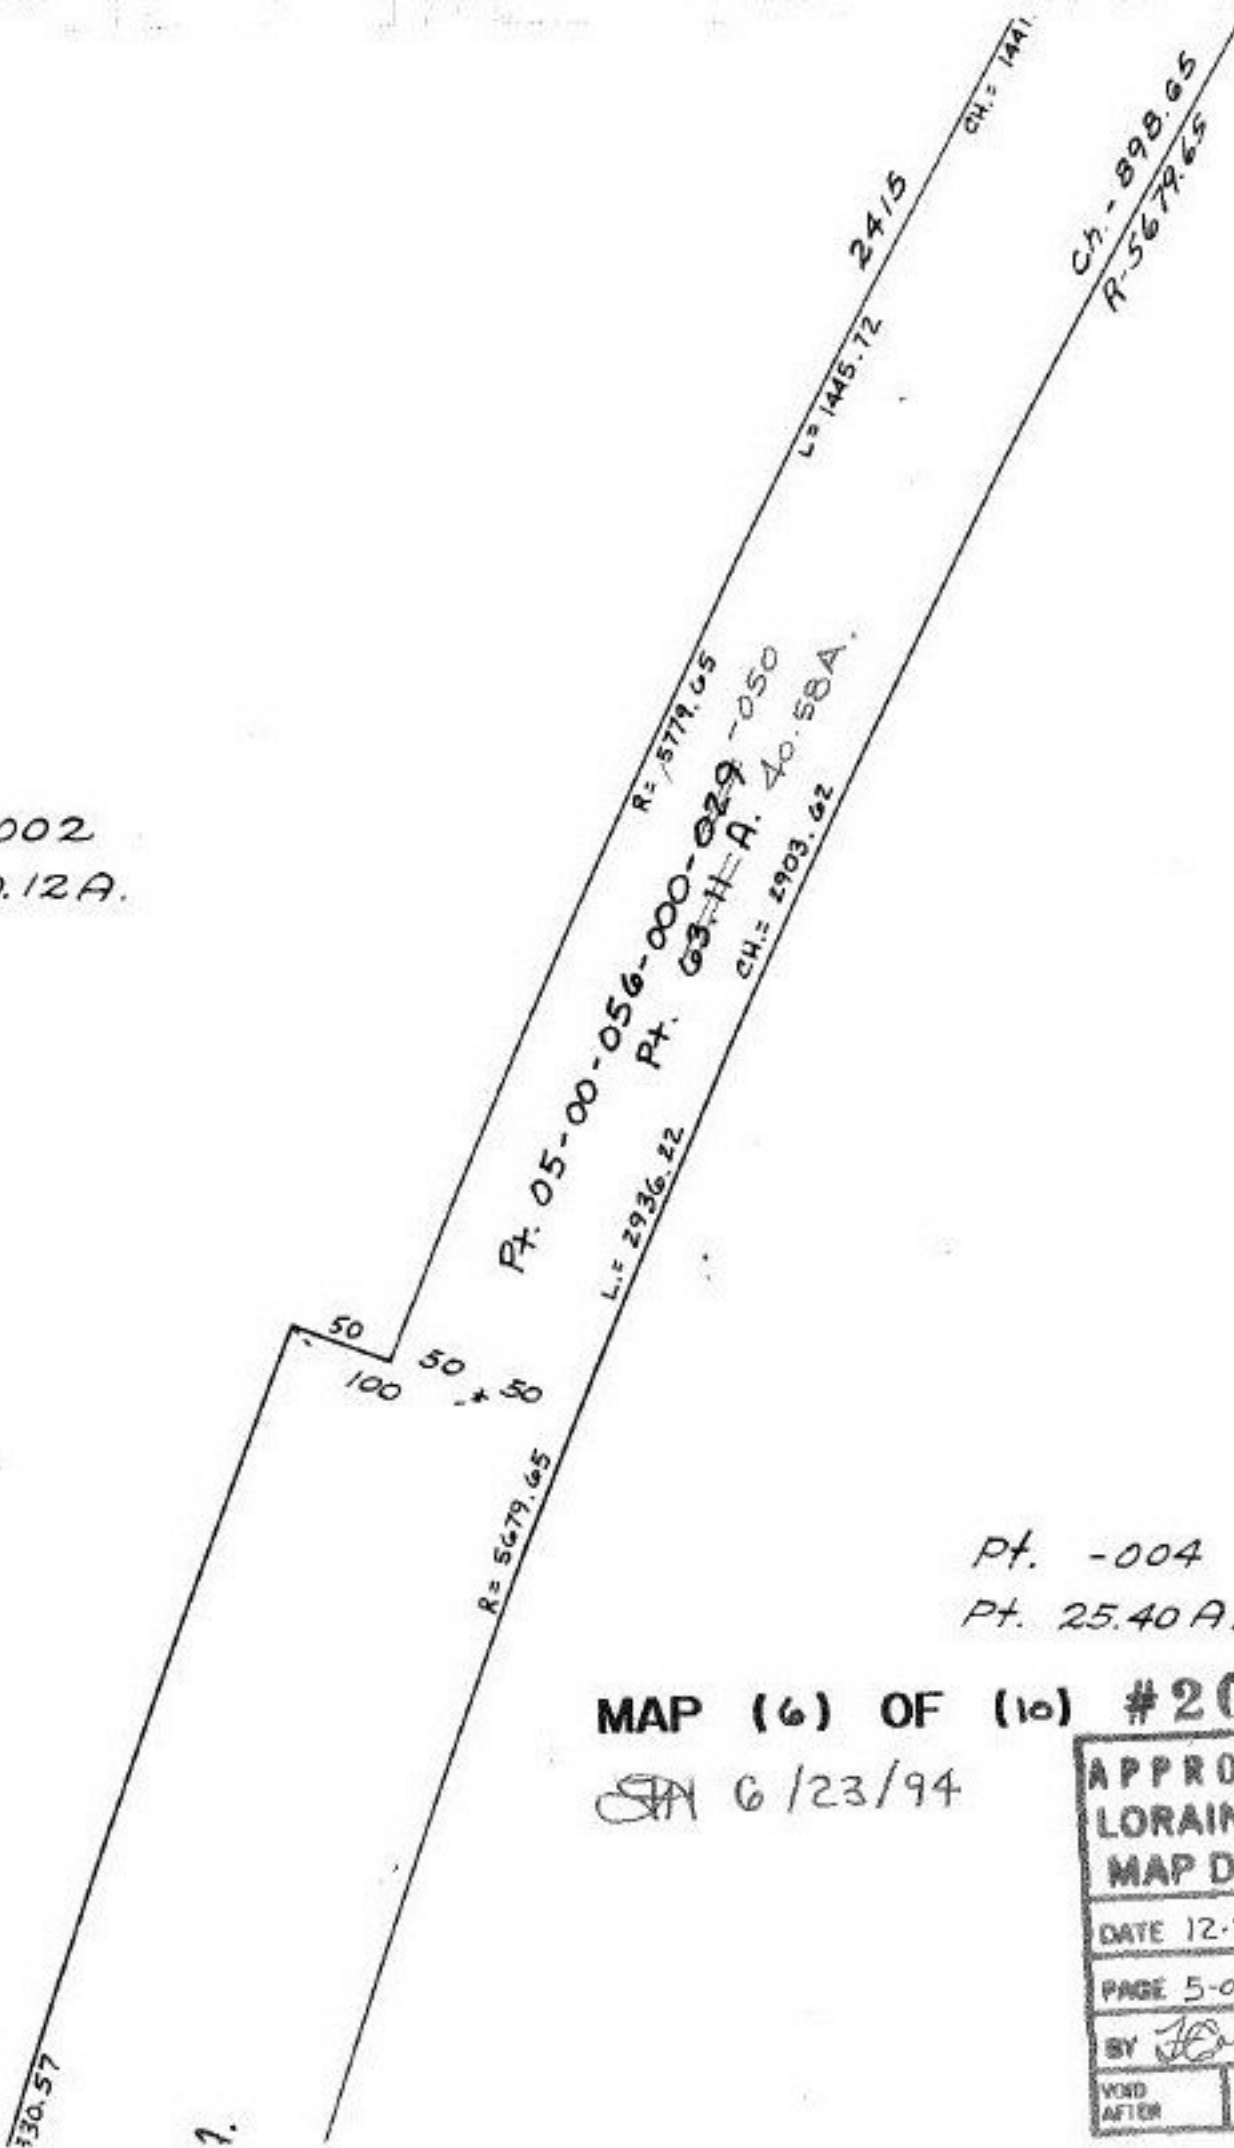

Pt. -004
Pt. 25.40 A.

MAP (6) OF (10) #20665
SIA 6/23/94

APPROVED LORAIN CO. MAP DEPT.	
DATE 12-22-93	
PAGE 5-00-033 A	
BY <i>J. Colbeck</i>	
VOID AFTER	20665