


SEE 5-00 056-A

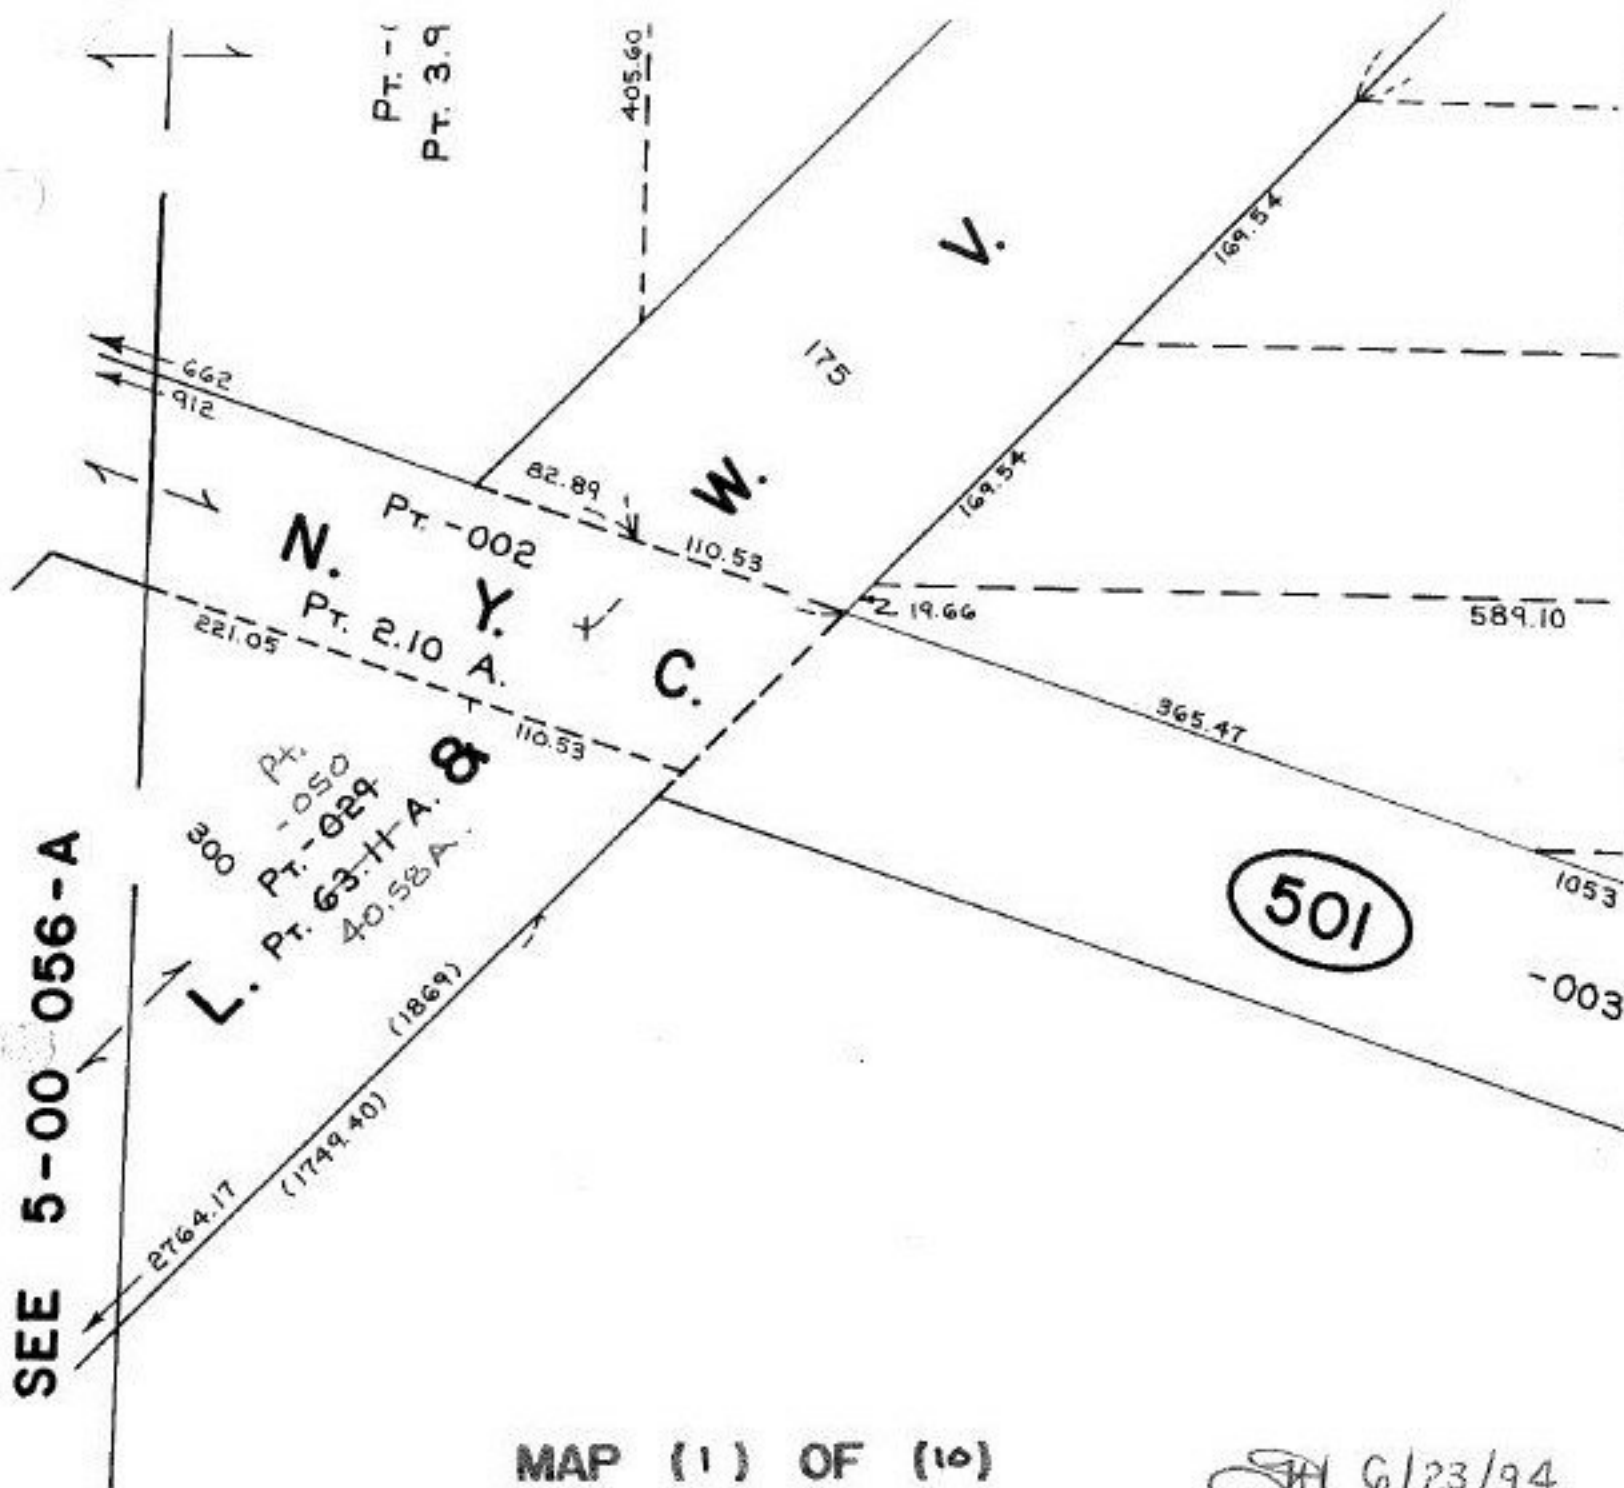

MAP (1) OF (10)

SH 6/23/94
#20665

APPROVED LORAIN CO. MAP DEPT.	
DATE 12-22-93	
PAGE 5-00-056B	
BY <i>Healy</i>	
VOID AFTER	20665