


SEE 3-00-017-B

BBE RD

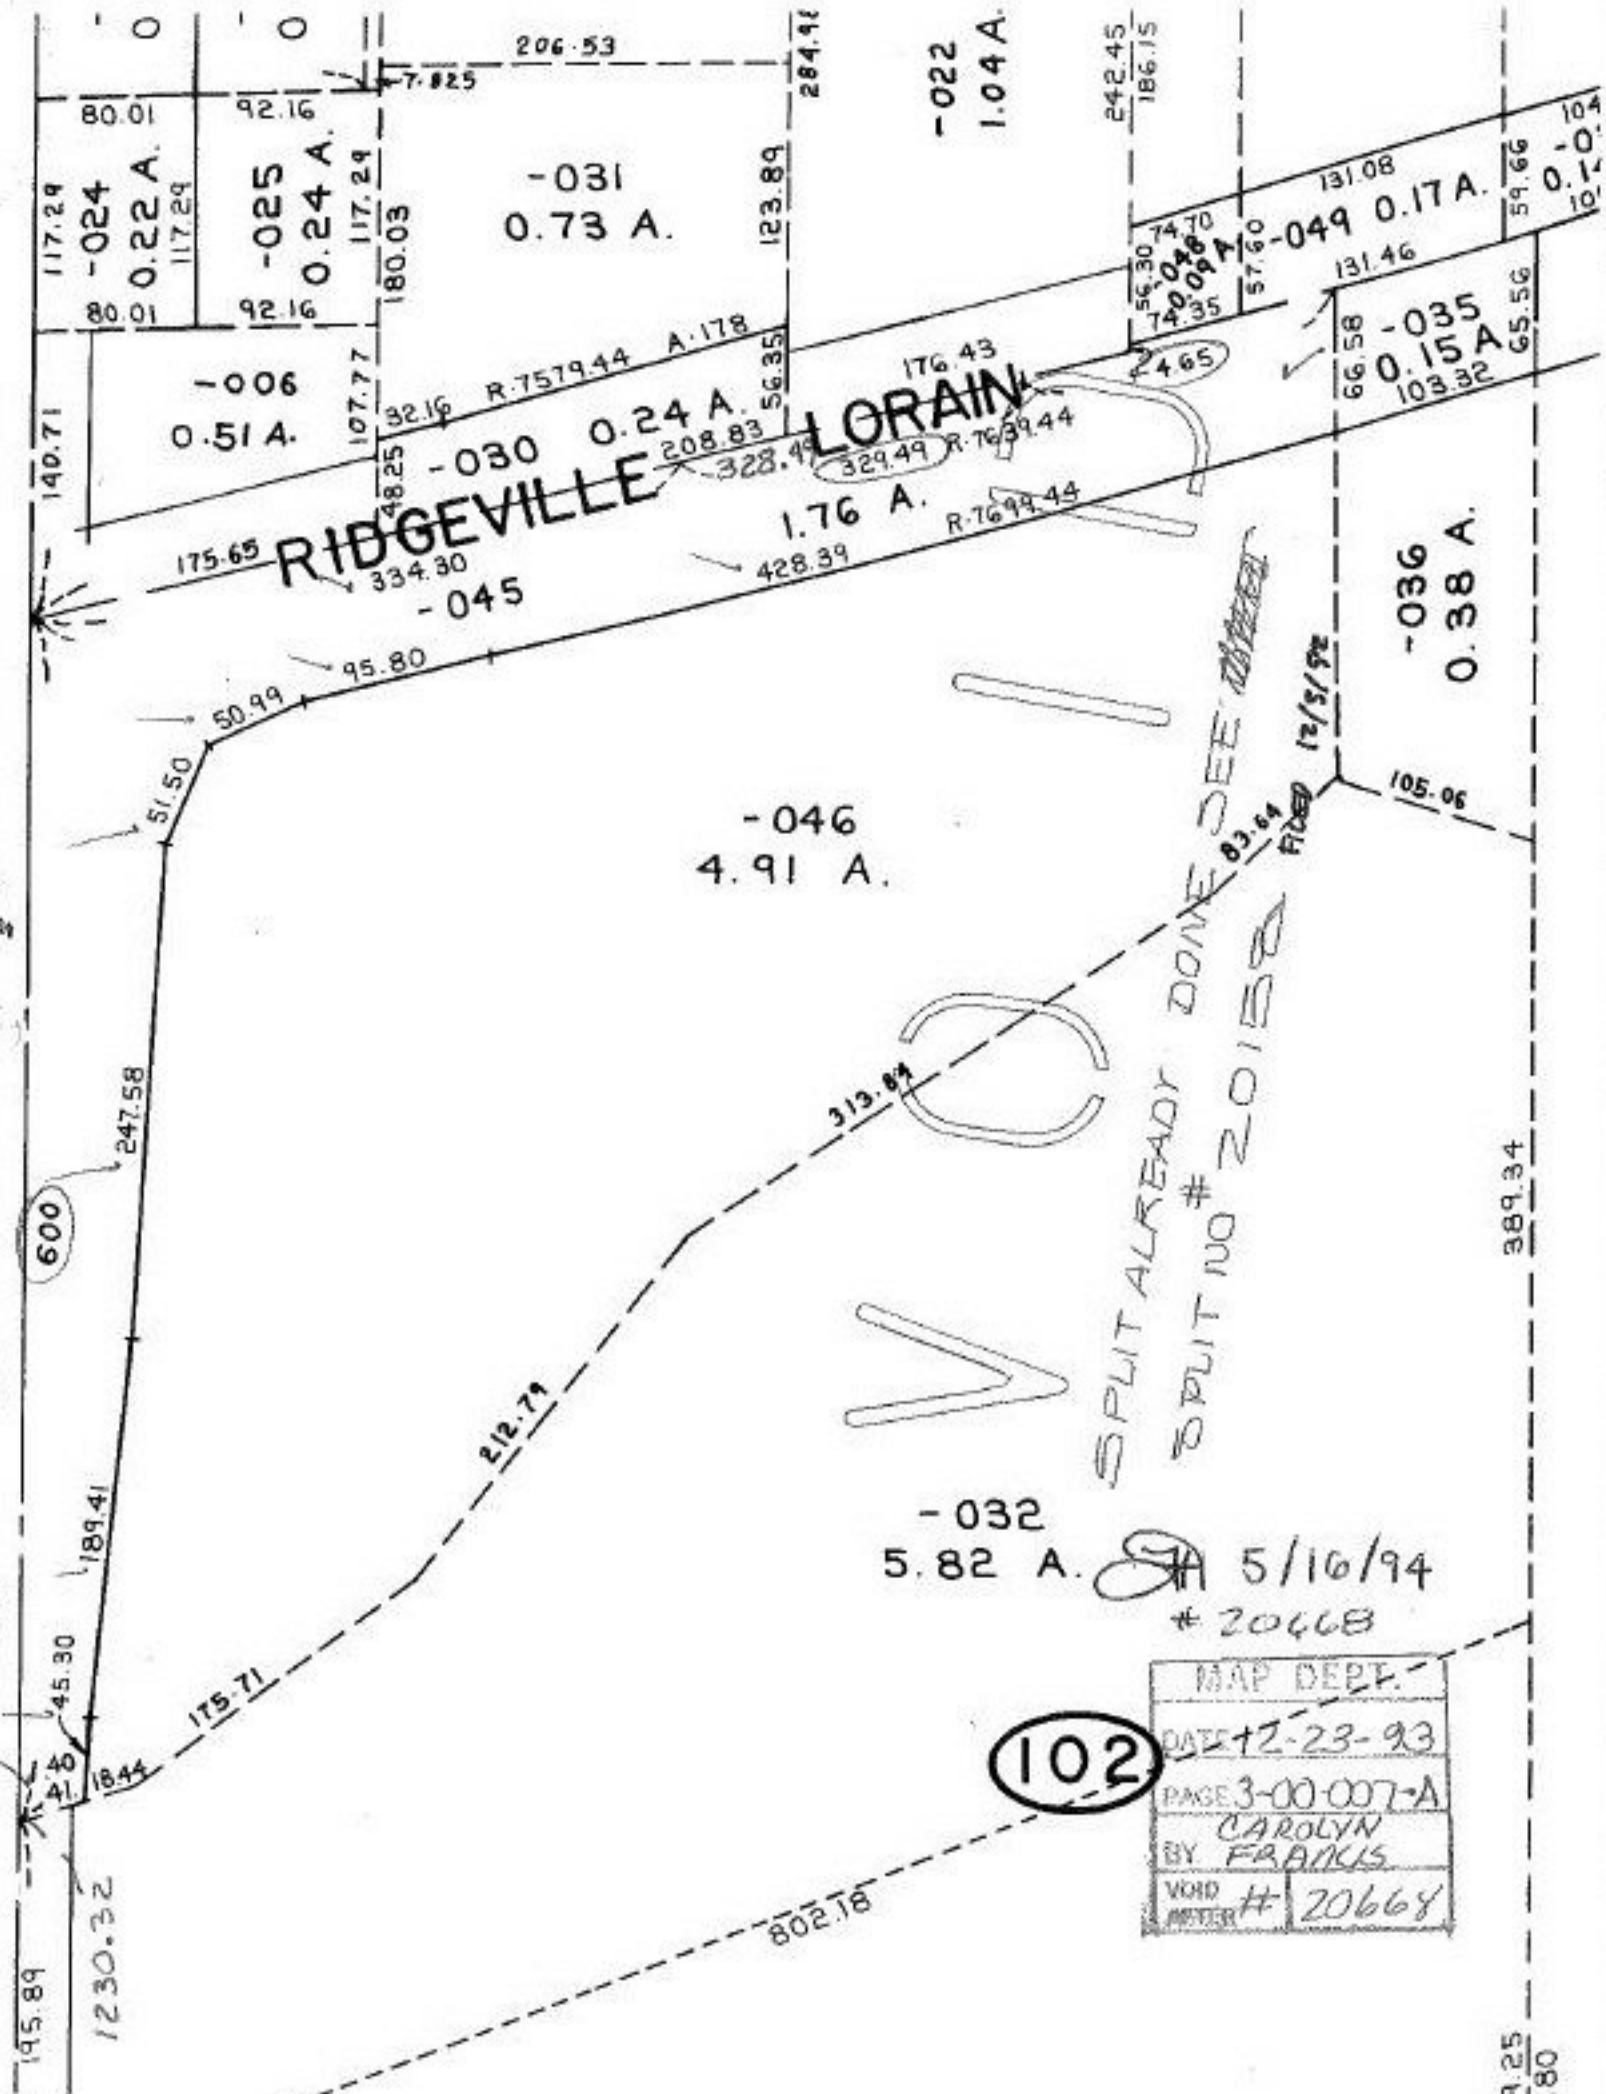

SPLIT ALREADY DONE DEC 12/31/92
 SPLIT NO # 20152

5/10/94
 # 20668

MAP DEPT.	
DATE	12-23-93
PAGE	3-00-007-A
BY	CAROLYN FRANKS
VOID NUMBER	# 20668

102

19.25
 3.80