


1392 JAN

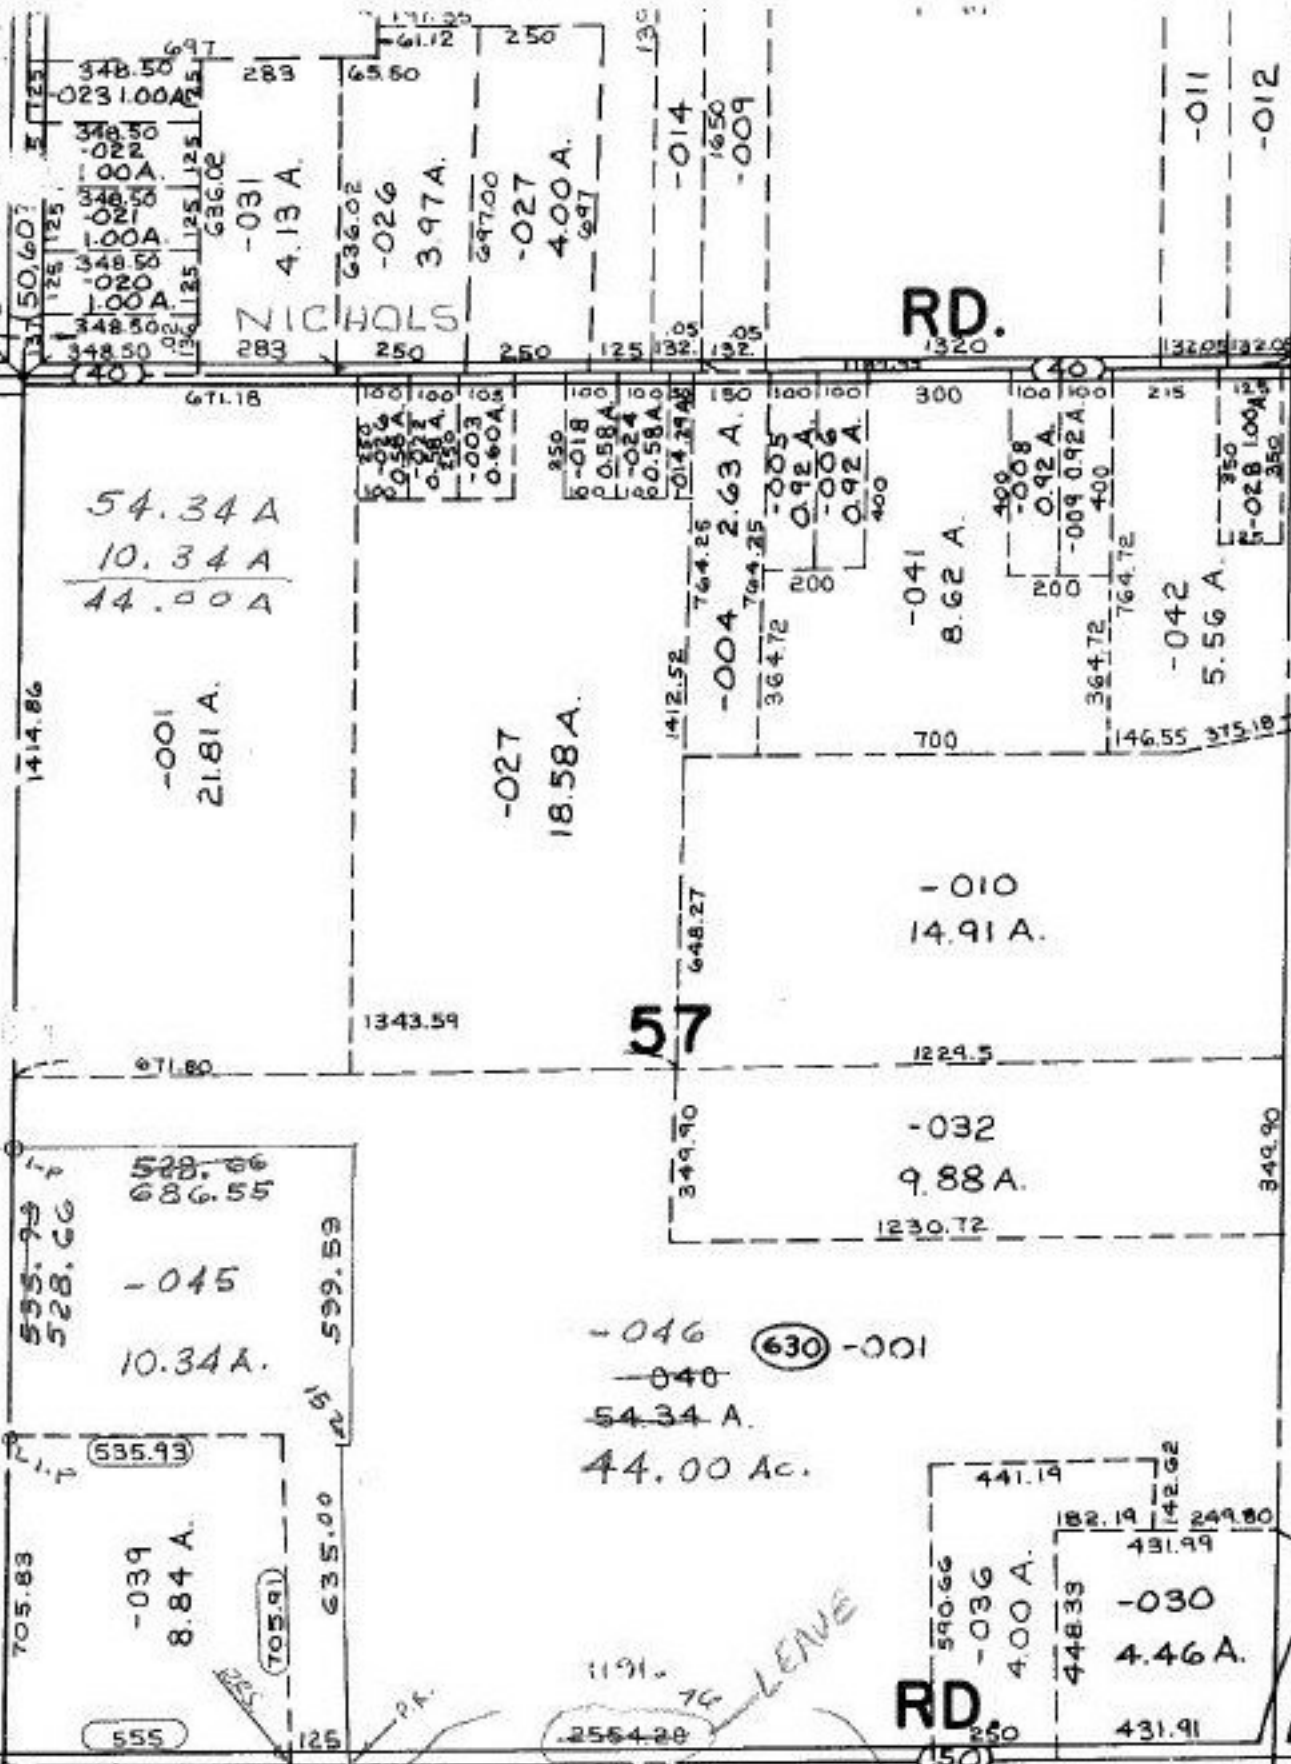

APPROVED
LORAIN CO.
MAP DEPT.
DATE 12-30-93
PAGE 12-B
BY CAROLYN
FRANCIS
VOID
BOOK # 20676

P.P.NO. 12-00-057-000-
PRIOR INST: VOL. 675/158
CLOSURE: C=1:416,468
SURVEYED BY: KS ASSOC.