



12-2-87
668.71

Ref Sec DV 782 Pq 408
812 Pq 446 AC
700 Pq 343
Rushong Forest Tract To Crawford Rd AM

2068
57Ac

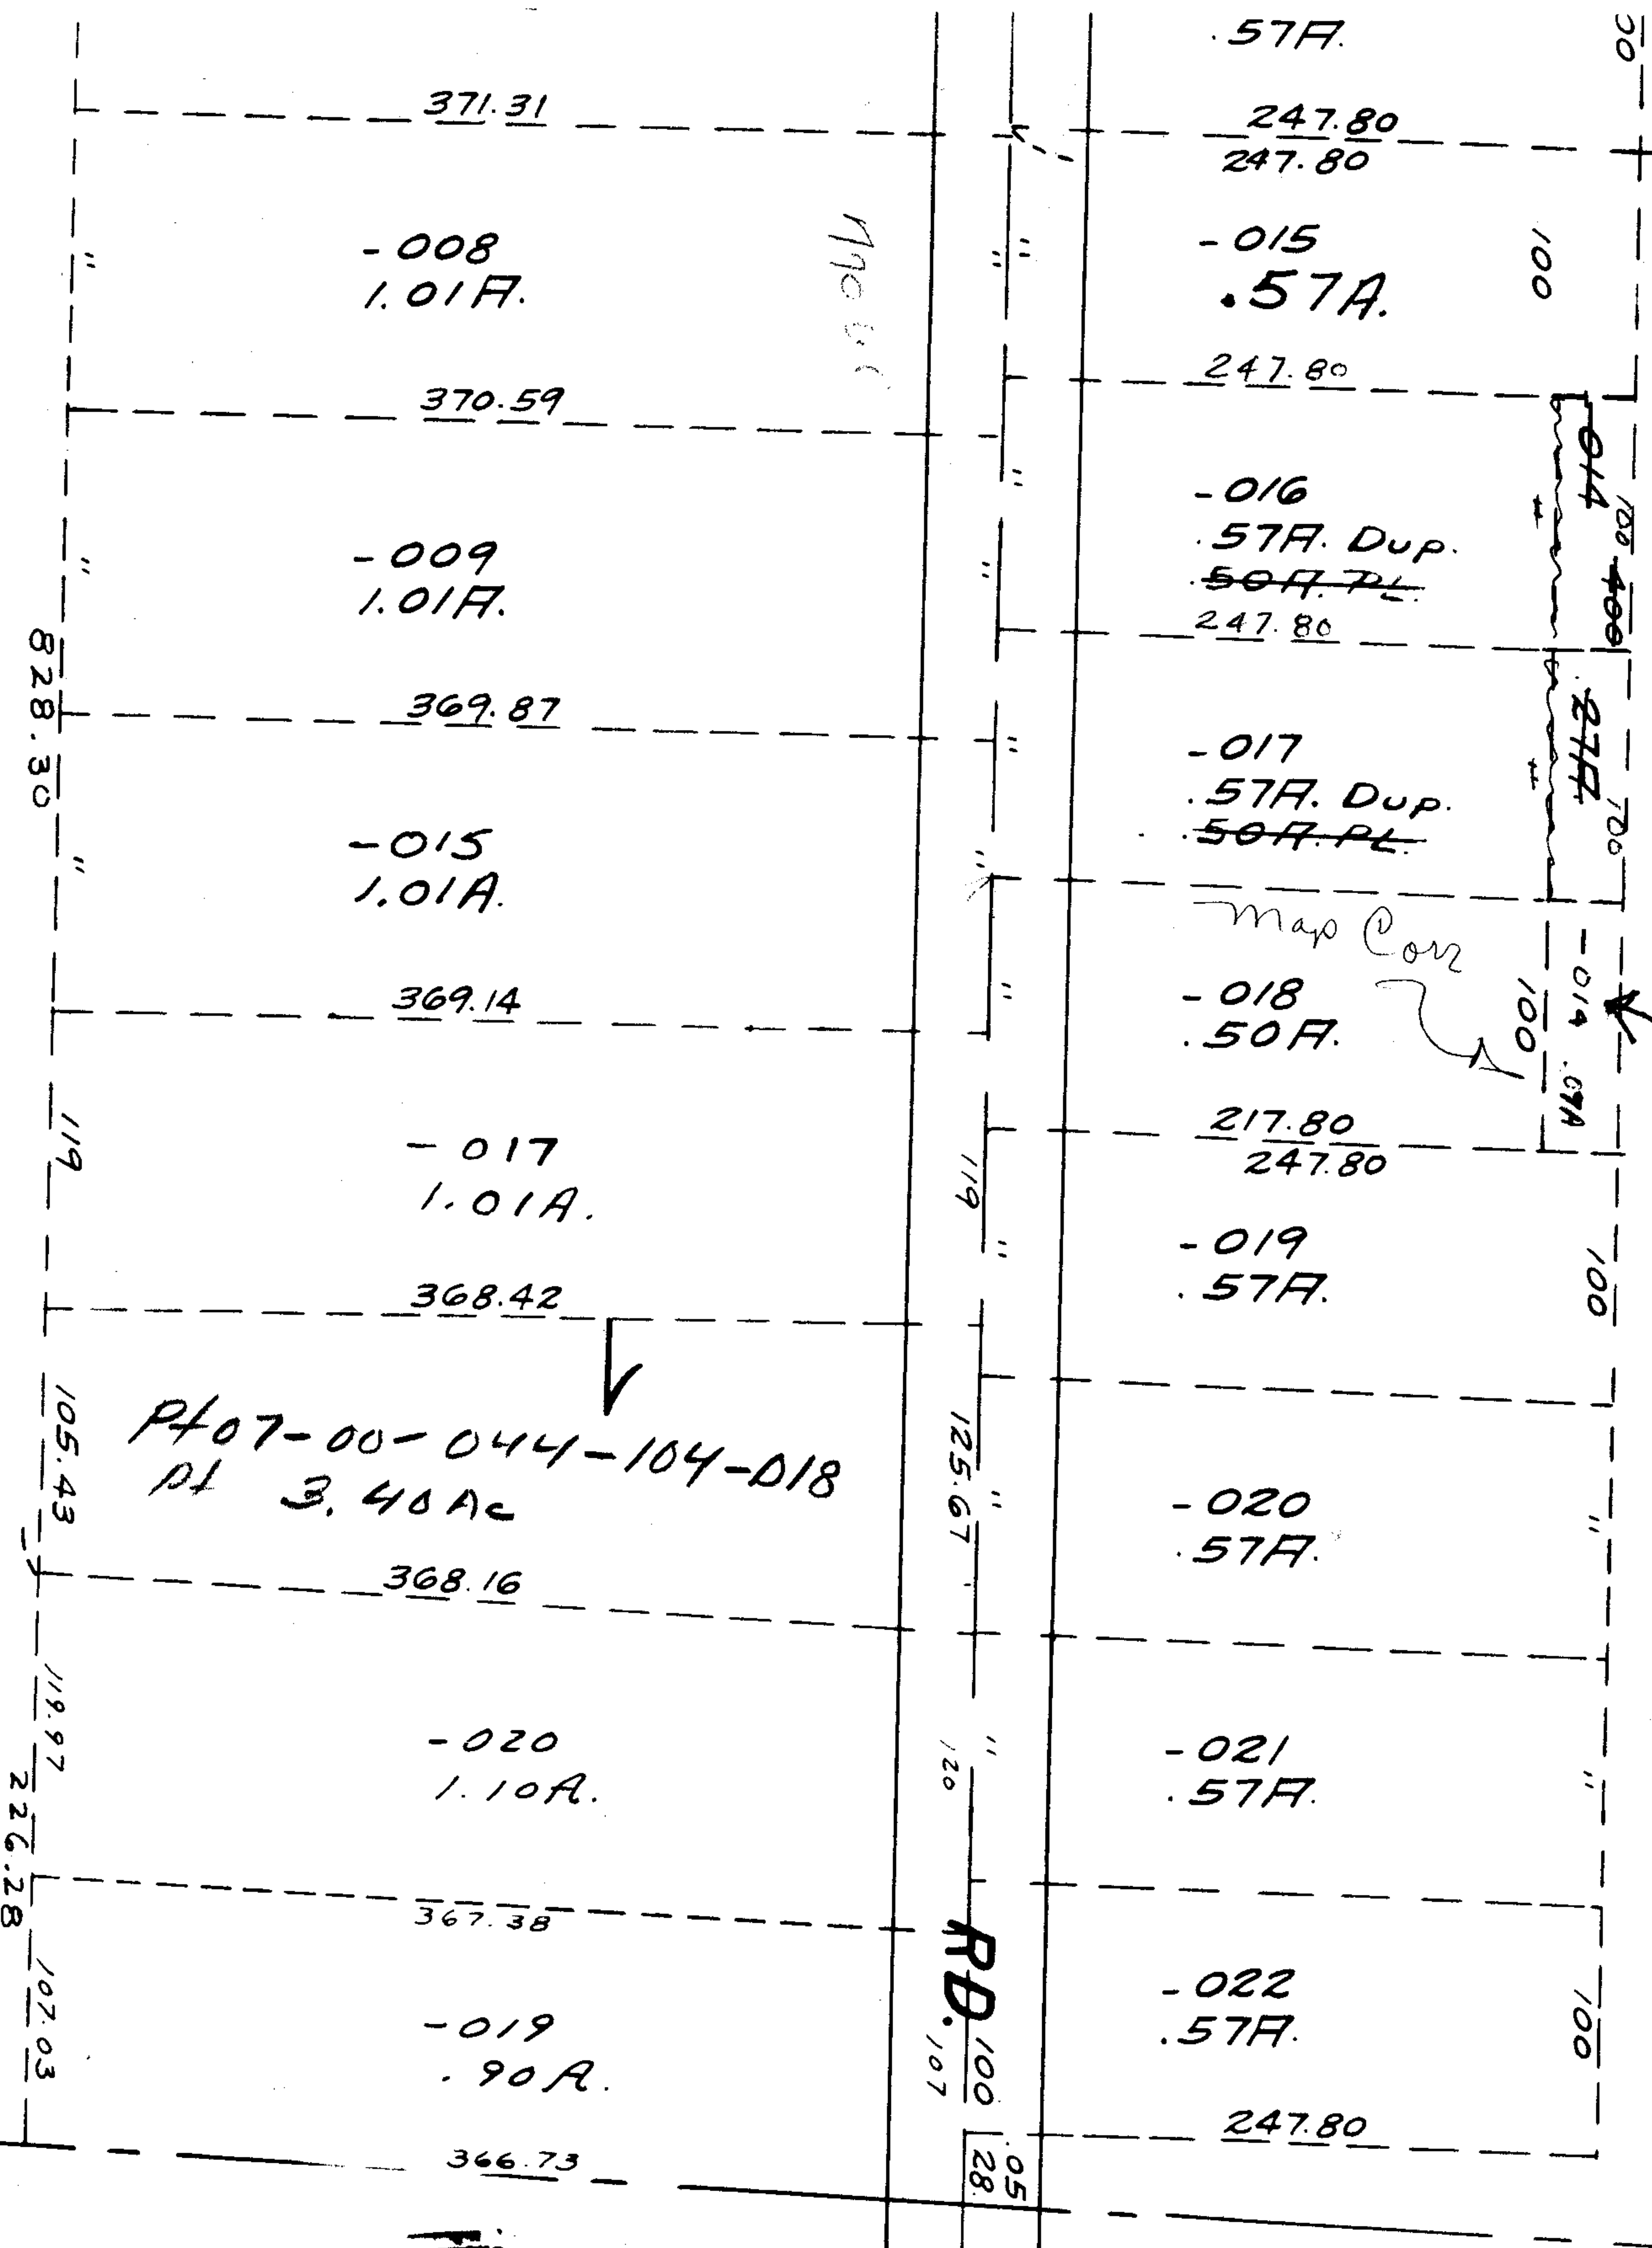

SEE 7-A

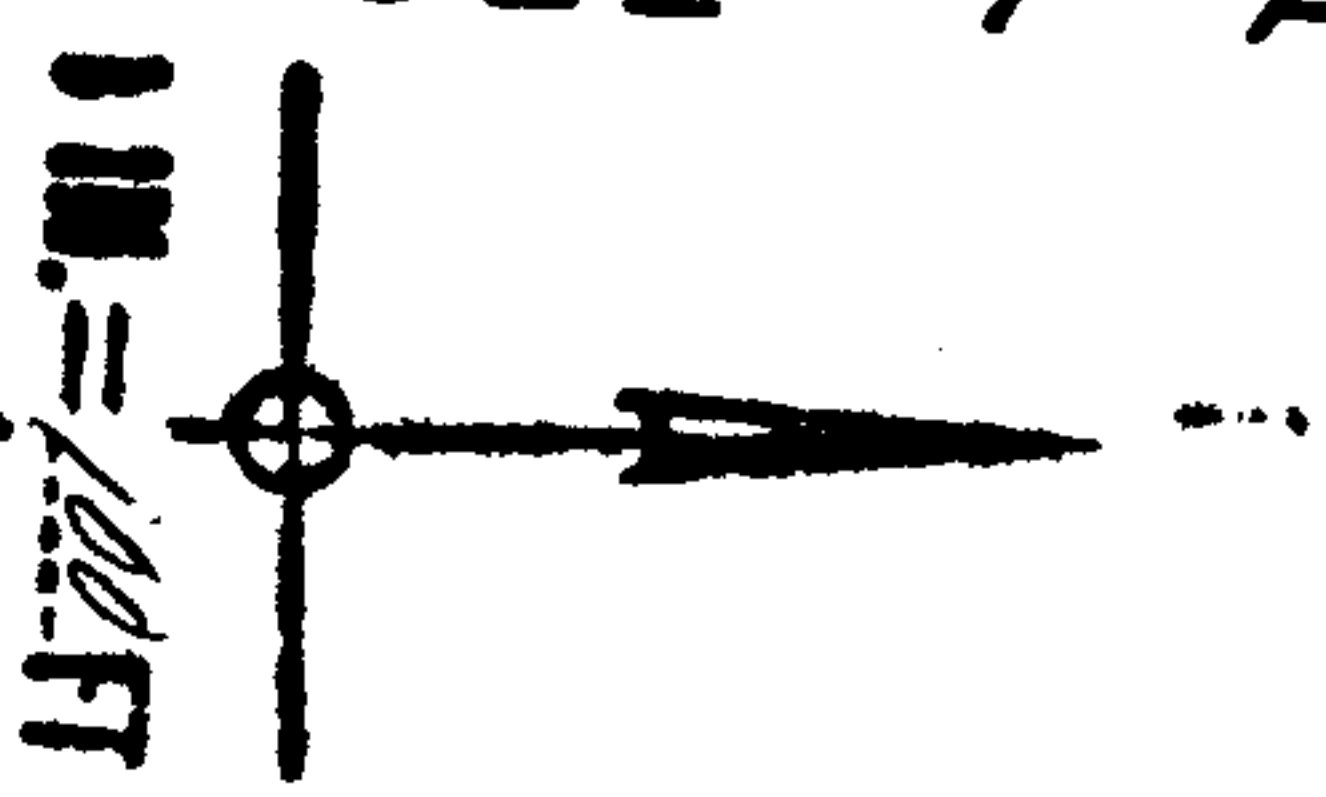

(Handwritten signature or initials)

APPROVED
LORAIN CO.
MAP DEPT.
 DATE 8-29-89
 7-00-044D
 BY *(Signature)*
 R.C.