


SIZE CORRECTION PER DEED VOL.
1267 Pg. 7321

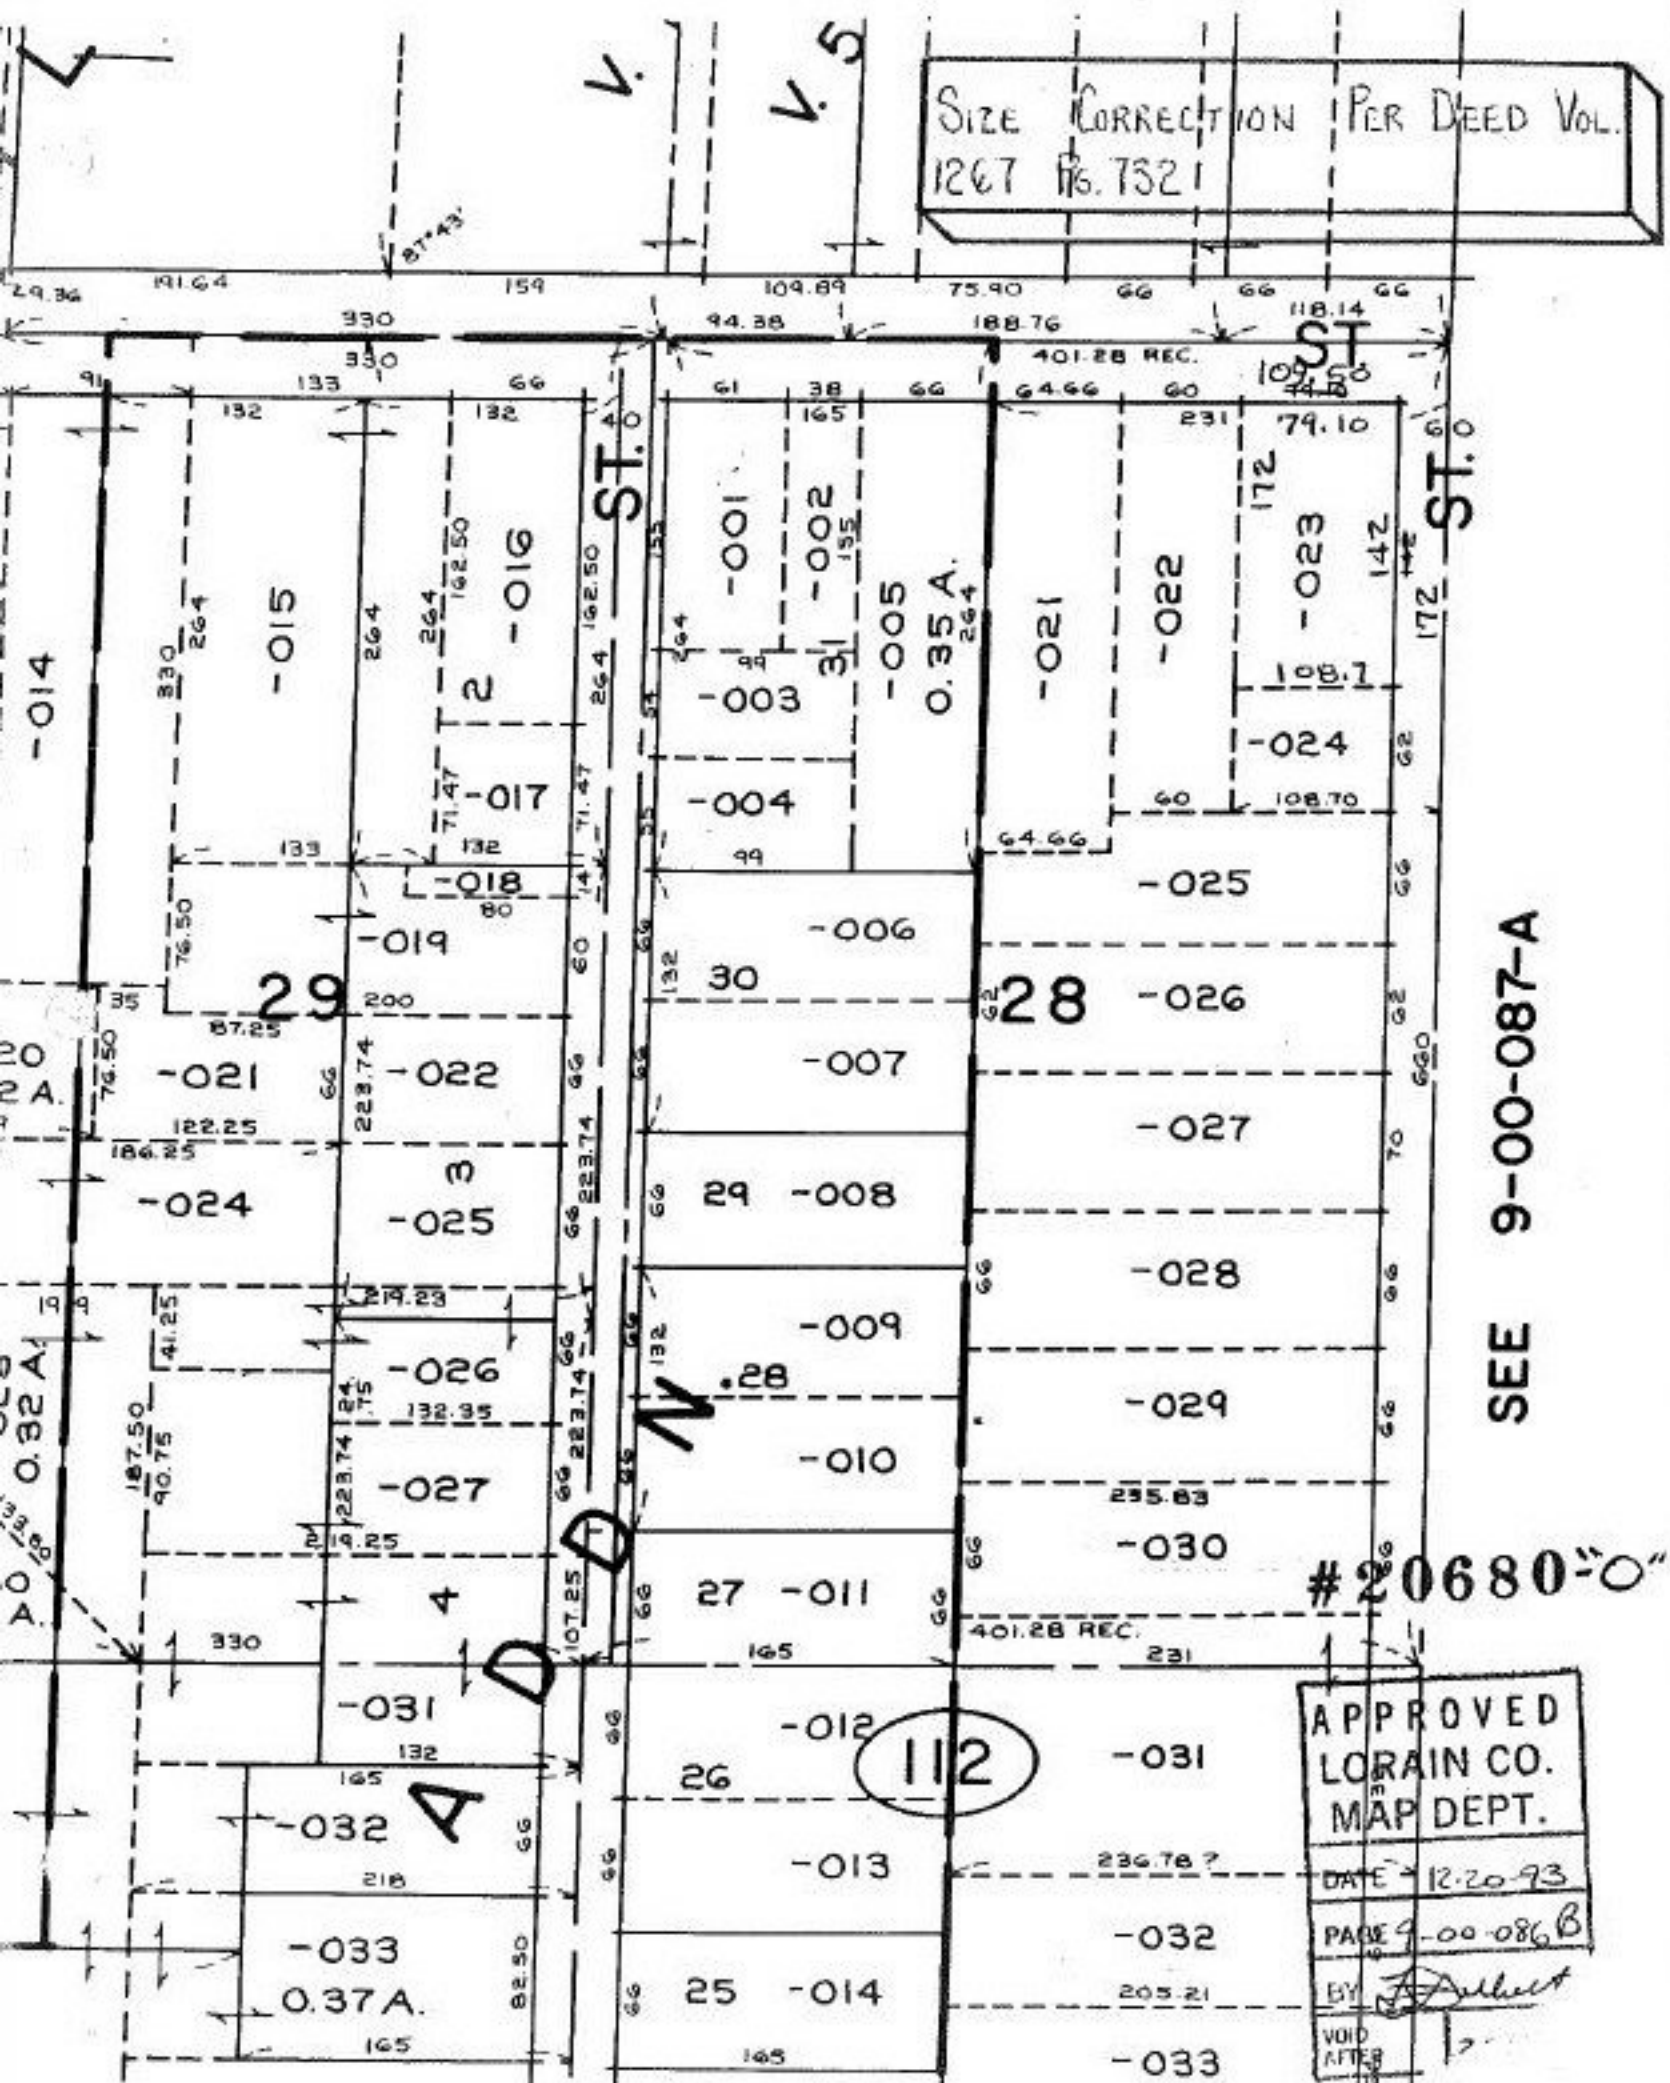

SEE 9-00-087-A

#20680-0

APPROVED
LORAIN CO.
MAP DEPT.

DATE 12-20-93

PAGE 9-00-086 B

BY *[Signature]*

VOID AFTER