


0.48A 0.09A 0.1.100
0.38A 0.2. 1

#20684

R/A
VEDINA
D

SEE II-00-100-B

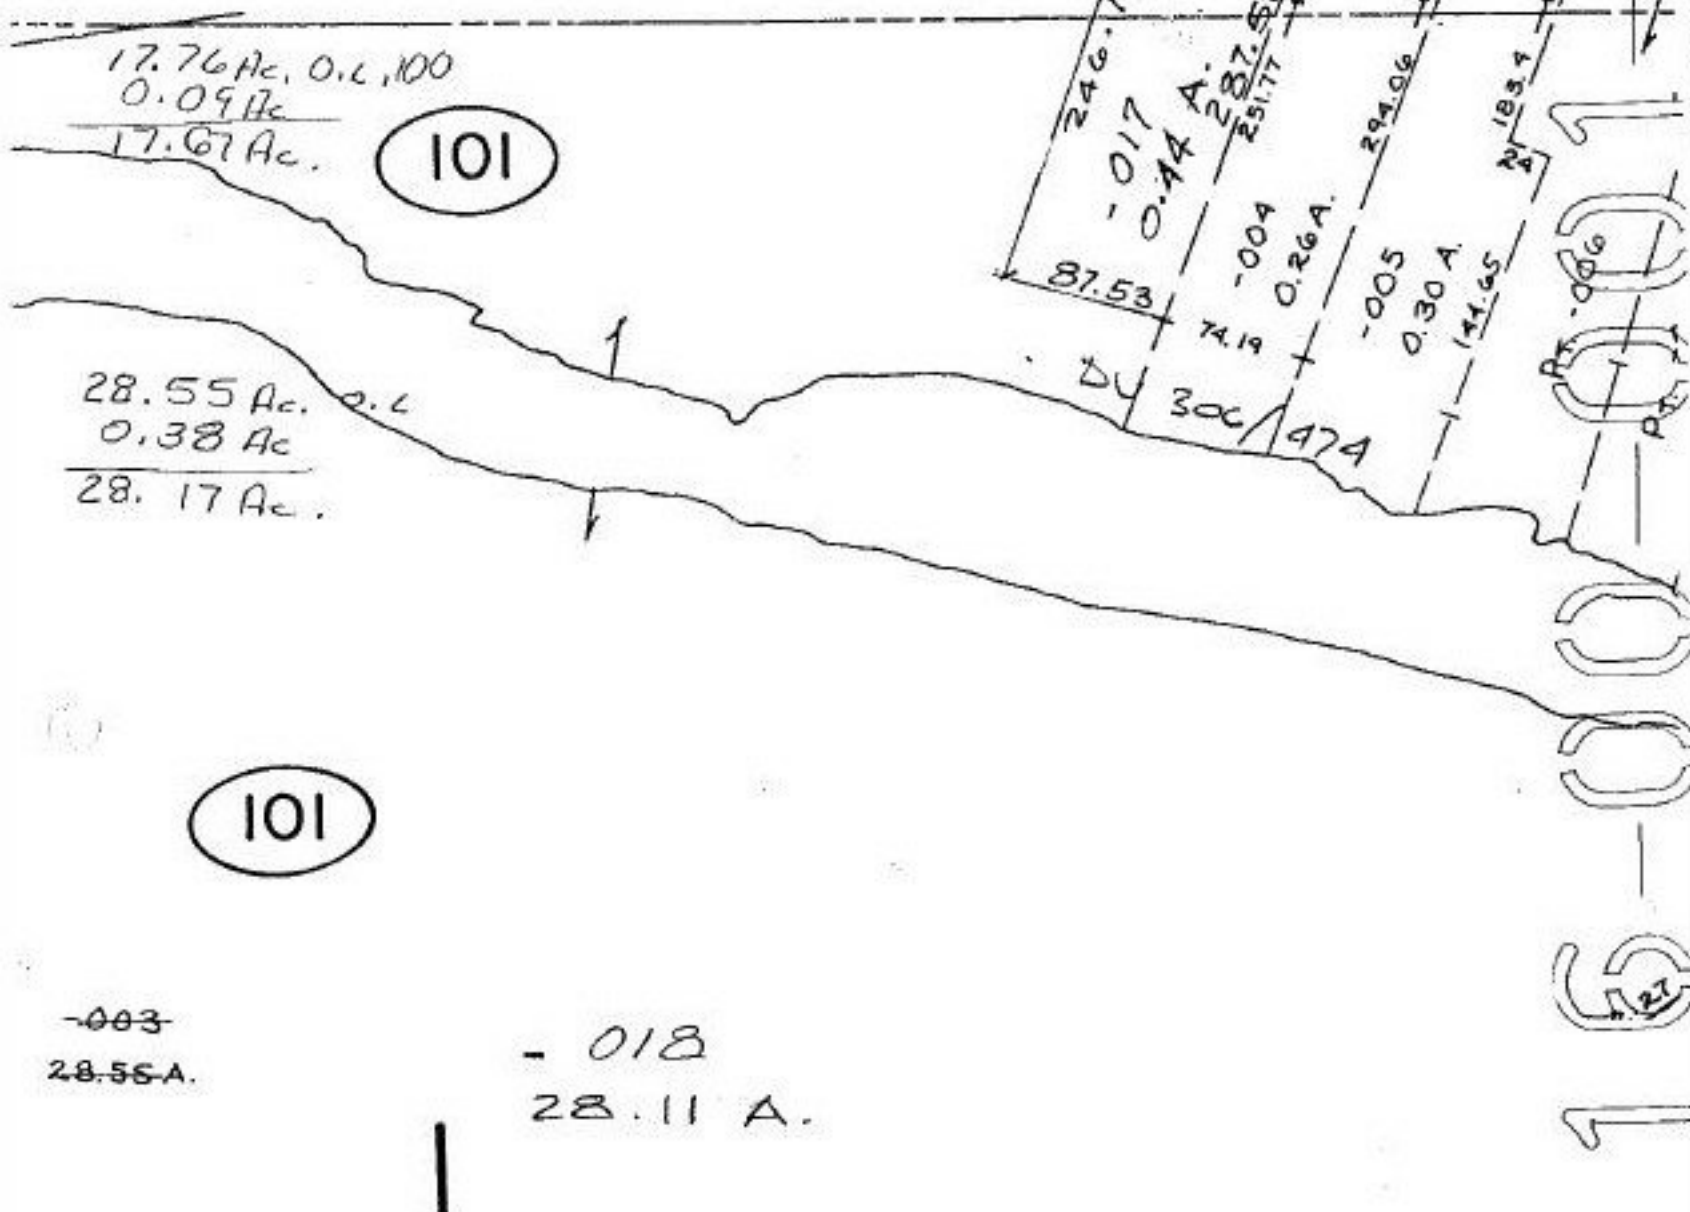

-003
28.55A.

- 018
28.11 A.

101

101

P.P.NO. 16-00-001-101-
PRIOR INST: DV. 306/474
DV. 1289/133
CLOSURE: C=1:96,611
SURVEYED BY: ROGER SIMON
XXXXXX REG. SURVEYOR

20684

APPROVED
LORAIN CO.
MAP DEPT.
DATE 1-11-94
PAGE 16-00-001-B
CAROLYN
BY FRANCIS
VOND # 20684
BEIER

-002
28.11 A.

16-00-001-B (2/)